


FRONTAGE ROAD TIES

 PC-4 239+49.77	 PI-4	 RE-12P	 RE-24P	 PI-5	 RE-24P
--------------------	----------	------------	------------	----------	------------

CURVE DATA

PI-4	PI-5
N 510.6287	N 511.215.75
E 558.972.00	E 573.215.23
D=13'	D=5'
A=+30°	A=20°
P=49.074	P=37.00
T=163.37	T=147.00
L=313.09	L=270.00
E=29.34	E=24.75
BANK=13/16'FT.	82/15/67'FT.

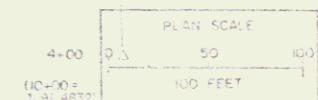

THETFORD - FAIRLEE  
 CONTRACT STAGE I CONSTRUCTION  
 T16-T14-FRONTAGE RD.  
 STA. 236+00 TO 251+00  
 PROJECT 1 94-2 (9) SHEET 126 OF 128