




Curve Data  
J.B.L.  
A = 12° 30' 55"  
D = 172.30  
C = 352.50  
T = 74.83  
L = 53.25  
E = 22.89  
R = 24.94

Curve Data  
N.B.L.  
A = 12° 30' 51"  
D = 172.30  
C = 352.50  
T = 74.83  
L = 53.25  
E = 22.89  
R = 24.94

POOR ORIGINAL COPY

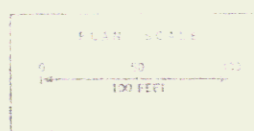

II Construction	
STATE OF VERMONT	
DEPARTMENT of HIGHWAYS	
FAIRLEE-BRADFORD	
McFARLAND JOHNSON	
PROJECT No. 191 (19)	Sheet 6 of 1
CONTRACT No.	