



Type of last Agreement: Nov 21, 1974
 Date: April 4, 1975
 Town: Farlee
 Proj #/Date: 44/3/10A/11
 30/12/80

JUTE MATING-ITEM G23
 G7+75-00+76 LT & RT

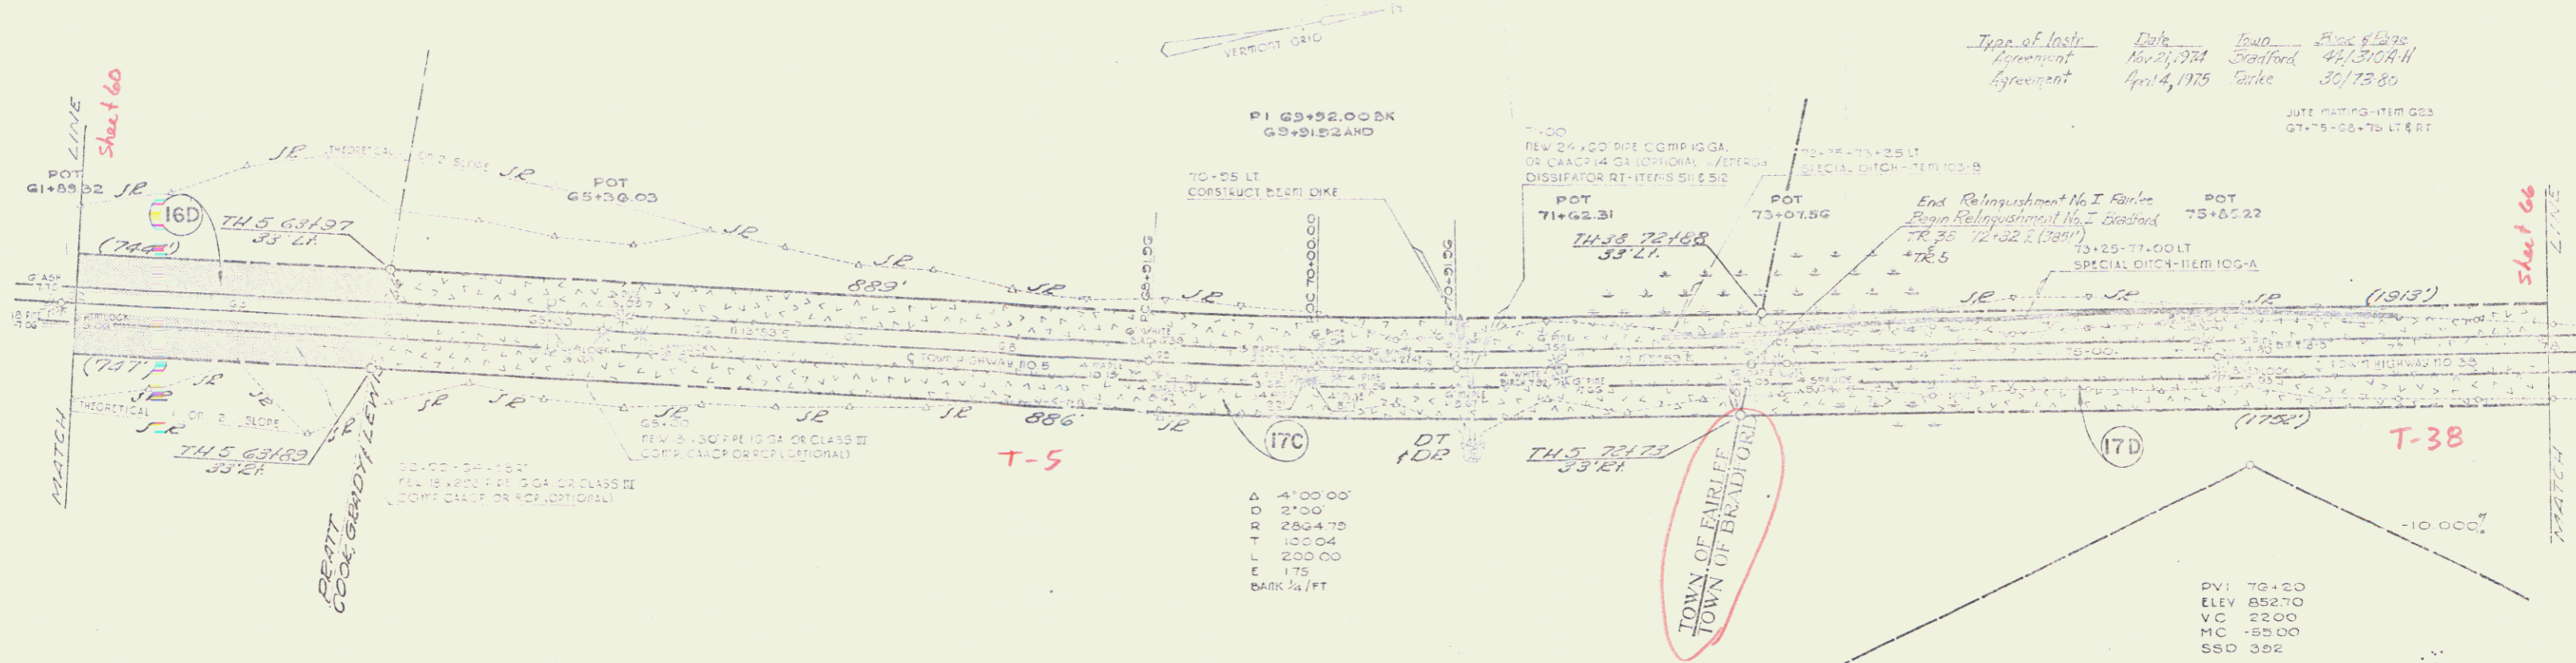

Δ 4'00.00'
 D 2'00.00'
 R 2864.75'
 T 100.04'
 L 200.00'
 E 175'
 BANK 3/4 FT

PVI 70+20
 ELEV 852.70
 VC 22.00'
 MC +55.00'
 SSD 362'

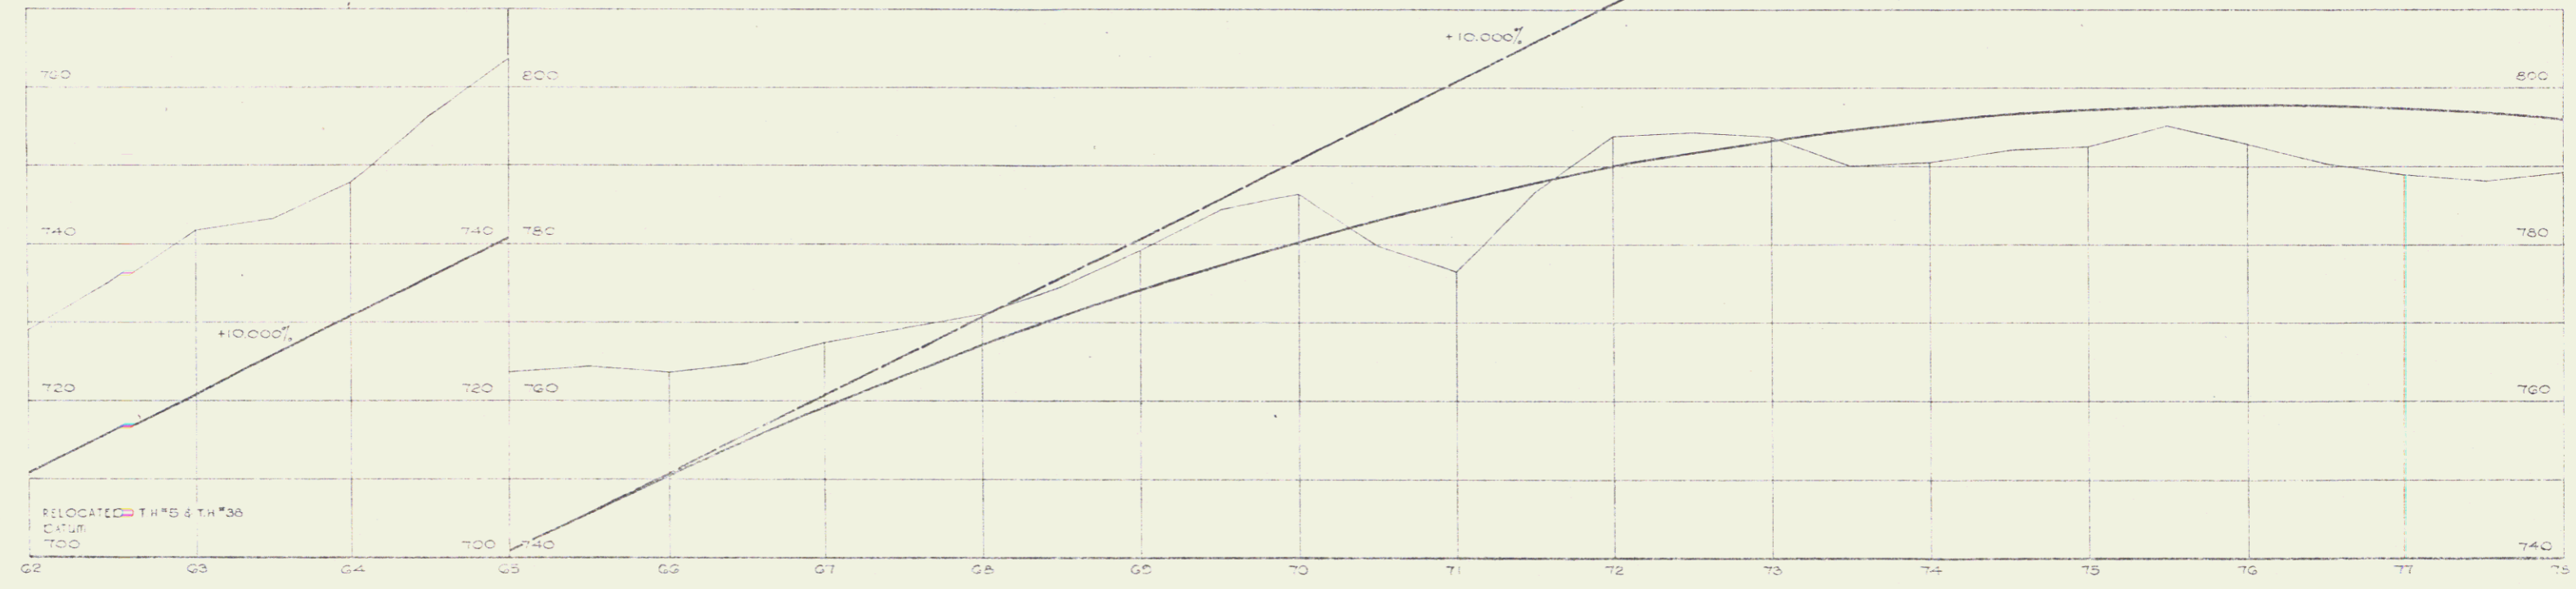

STATE of VERMONT	
DEPARTMENT of HIGHWAYS	
FARLEE-BRADFORD TH. NO. 5 & 36	
McFARLAND JOHNSON	
PROJECT No. 171 2051	SHEET 63