

Chain Link Fence
 JB 513450 - 5142+00 Lt
 71.96

Demolition and Disposal
 of Building - Item 286
 JB 5130+0 Lt

Grouted Rubble Paving
 Item 513
 JB 5135+05 - 5138+40 Rt
 JB 5136+10 Rt
 NB 5136+50 Lt

Stone Fill for Stone Crops
 Section 5134
 Item 512
 JB 5133+10 - 5134+75 Lt
 NB 5138+25 - 5138+50 Rt

* 270 # Barose (Light Type) Item 513.8
 JB 5131+50 - 5132+70 Lt
 JB 5135+0 - 5135+55 Lt

* Treated Timber Curb
 Item 508.1
 JB 5134+0 - 5142+0 Rt
 JB 5133+50 - 5142+0 Lt
 NB 5133+50 - 5142+0 Lt
 NB 5135+50 - 5142+0 Rt

Topsail Stockpiled or
 Available
 NB 5140+00: Rt

Property Line Fence
 w/ Steel Posts Item 533.8 Mod
 SB 5126+0 - 5138+0 Rt
 NB 5126+0 - 5142+0 Rt

Drilling & Blasting of Solid
 Rock Subgrade Item 115
 NB 5126+00 - 5133+50
 SB 5126+00 - 5131+25.00

* Three Cable Guard Rail w/
 Light Steel Posts Item 538
 JB 5127+25 - 5140+75
 JB 5132+50 - 5142+0 Lt
 NB 5133+50 - 5142+0 Lt
 NB 5136+50 - 5142+0 Lt


For Continuation of T-15
 T-38 Elevation See Sheets
 247 to 259

STATE OF VERMONT
 DEPARTMENT OF HIGHWAYS
FAIRLEE-BRADFORD
 McFARLAND-JOHNSON
 CONSULTING ENGINEERS

DESIGNED BY: P.F. J. (1-2-25) CHECKED BY: G.W.
 TRACED BY: F.F. DATE: 8-1-26

PROJECT No: 1,912(1) SHEET 81 OF 868
 CONTRACT No:

Scale: 66 of 117 Sheets

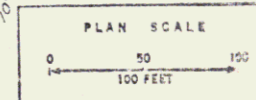

R. Wood - Spring 0 NB 513750
 Control of Access
 Complete on this sheet