
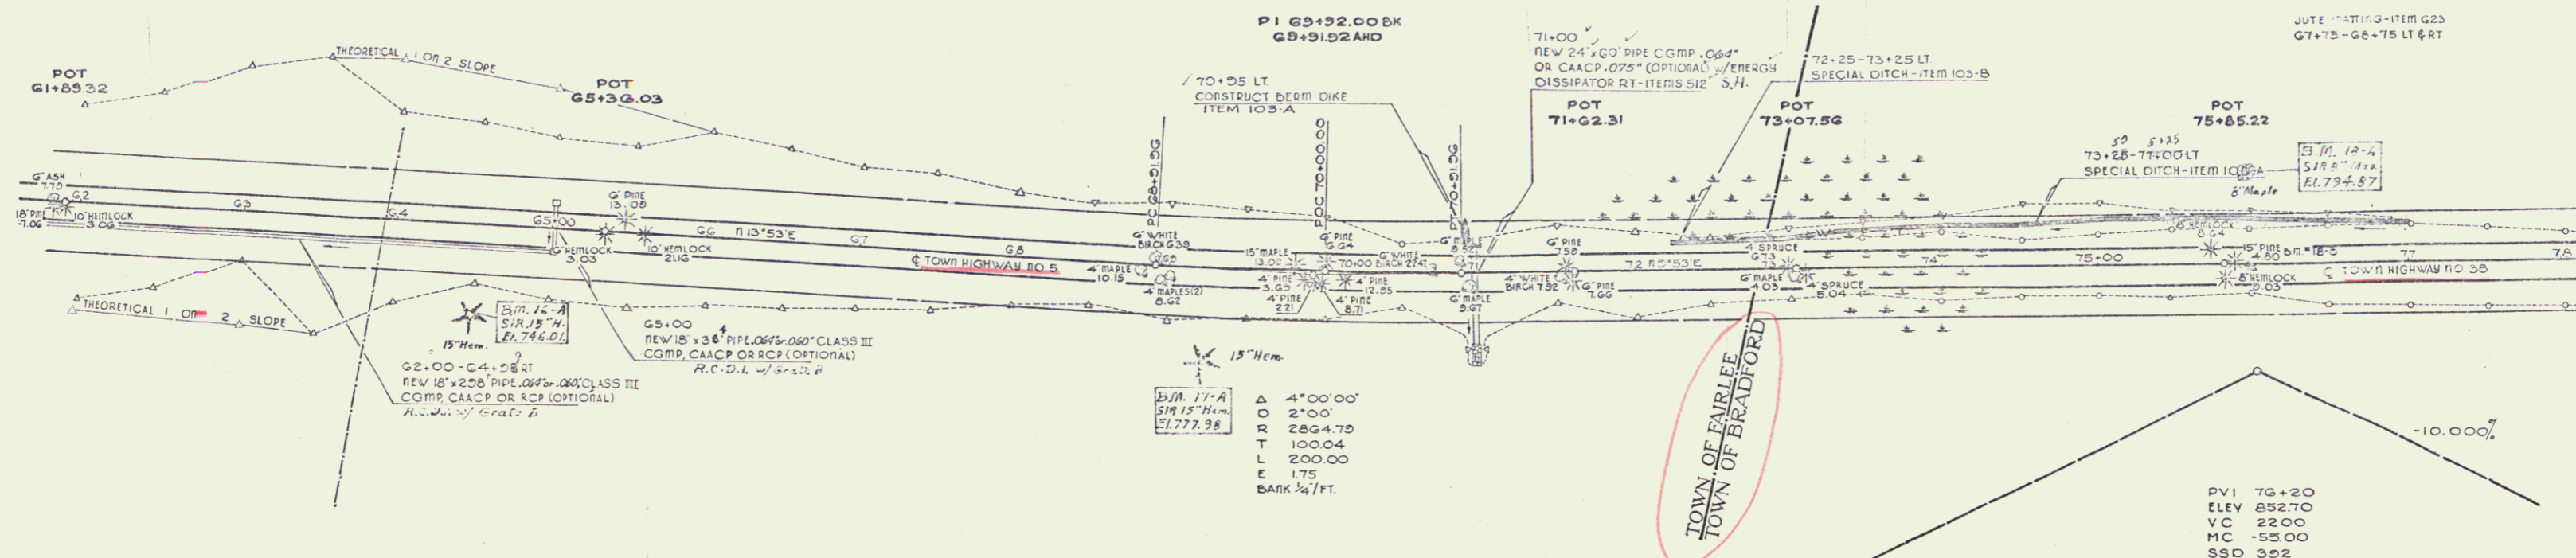



Welded Steel Pipe Constructed
 73+05-74+15 RL 73+05-74+15 RL

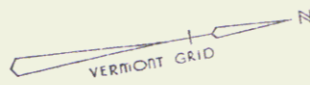

Δ	4'00.00'
D	2'00'
R	2864.75
T	100.04
L	200.00
E	175
BANK	3/4 FT.

TOWN OF FAIRLEE
TOWN OF BRADFORD

PVI 76+20
 ELEV 852.70
 VC 22.00
 MC -55.00
 SSD 302

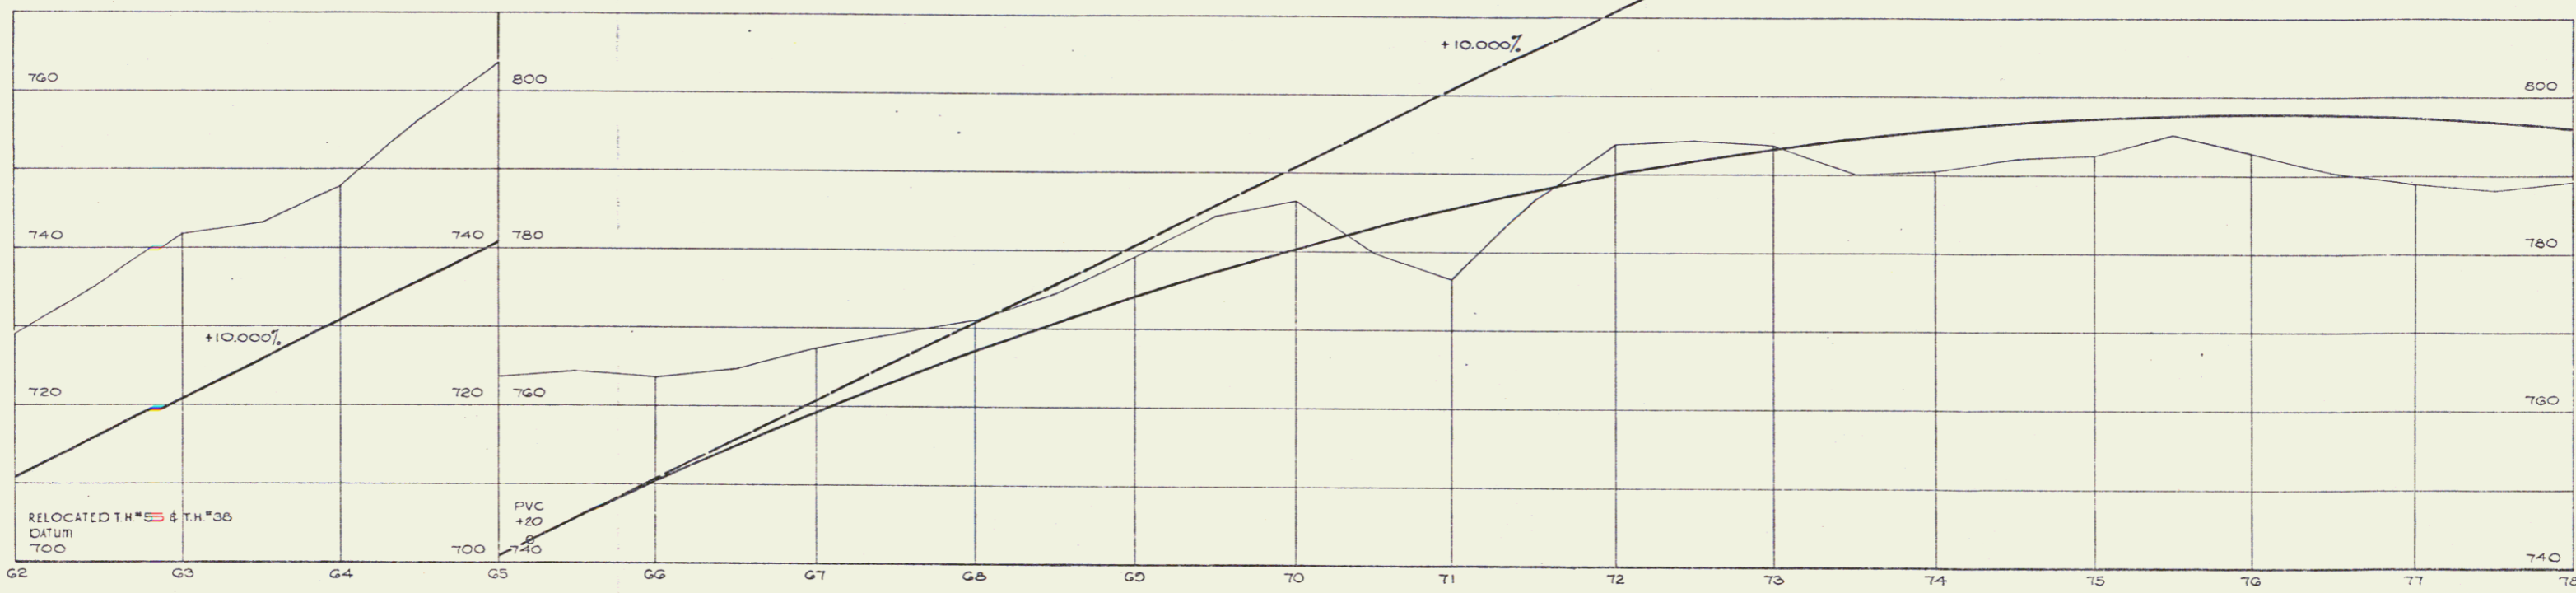

STATE OF VERMONT	
DEPARTMENT OF HIGHWAYS	
FAIRLEE-BRADFORD T.H. NO. 5 & 35	
McFARLAND JOHNSON	
CONSULTING ENGINEERS	
DESIGNED BY: P.A.	CHECKED BY: F.C. REIL
TRACED BY: J. DUFFELL	DATE: 7-21-66
PROJECT No: 191211	SHEET 257 OF 868
CONTRACT No:	

Const
 67