
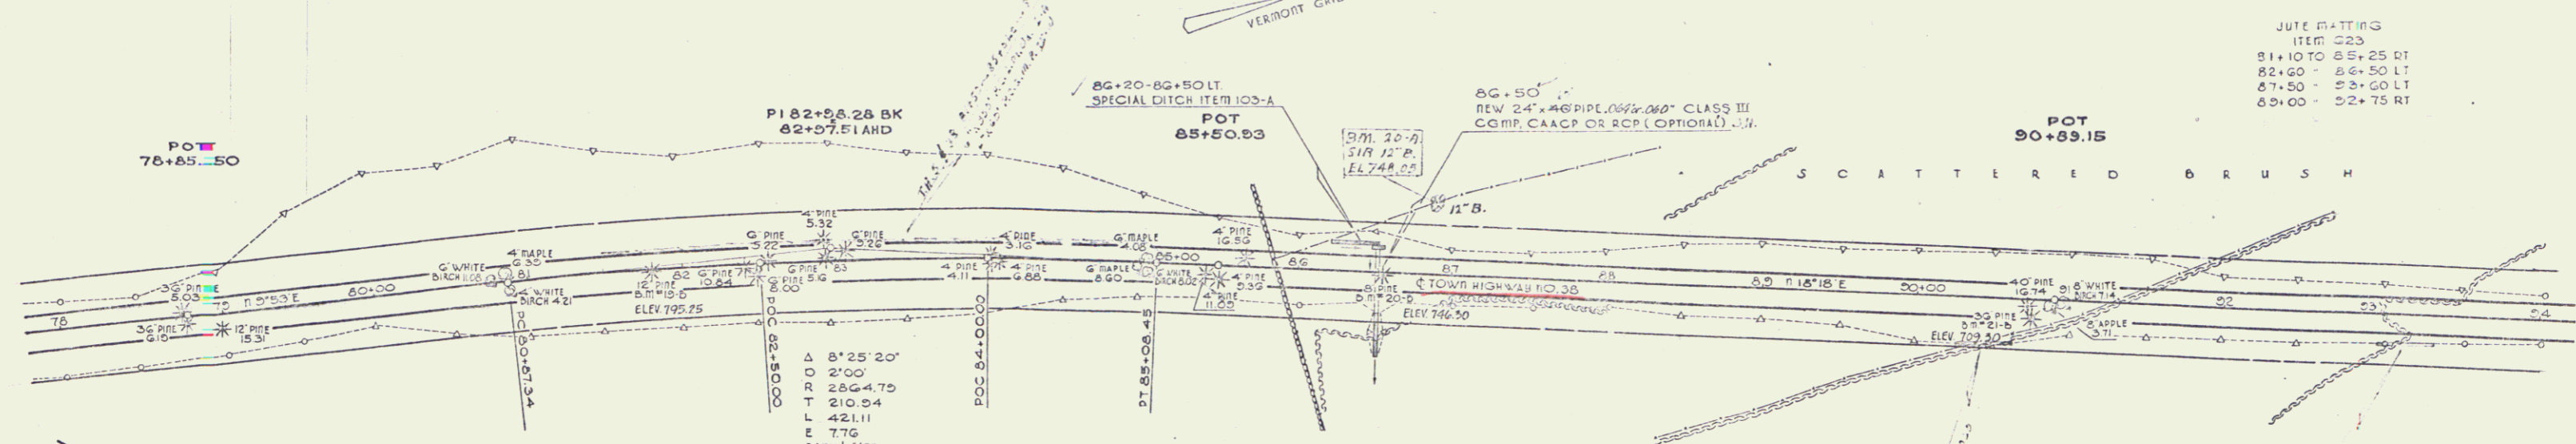



Courtesy Drive  
 93+50 RT.  
 93+25 RT.

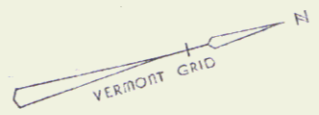

JULY DATINGS

|                   |     |
|-------------------|-----|
| ITEM              | Q23 |
| 81+10 TO 85+25 DT |     |
| 82+00 - 84+50 LT  |     |
| 87+50 - 93+00 LT  |     |
| 89+00 - 92+75 RT  |     |

Δ 8'25' 20"  
 O 2'00"  
 R 2864.75  
 T 210.54  
 L 421.11  
 E 776  
 DARK 1/4" FT.

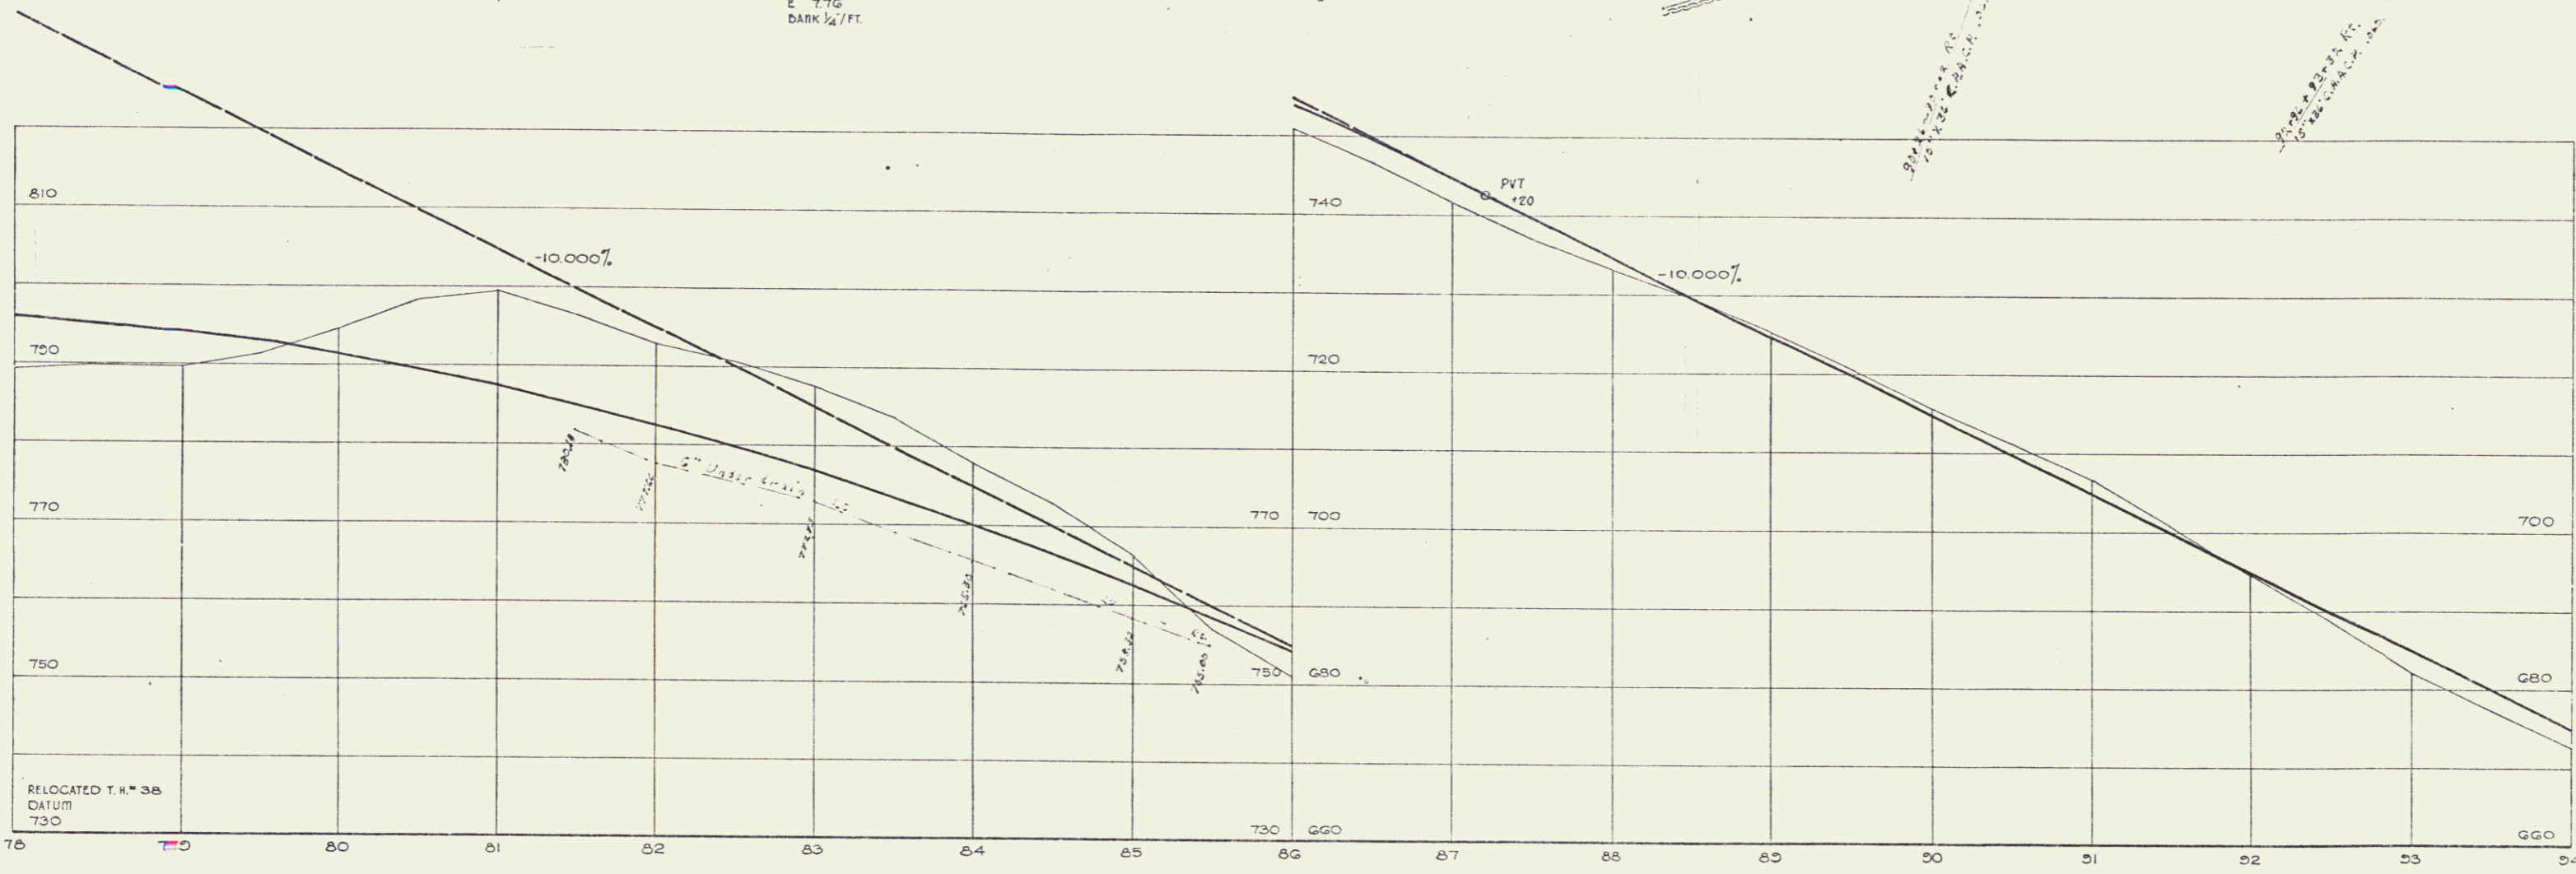

STATE of VERMONT  
 DEPARTMENT of HIGHWAYS  
 FAIRLEE-BRADFORD T.H. NO. 38  
 McFARLAND-JOHNSON  
 CONSULTING ENGINEERS

|                       |                       |
|-----------------------|-----------------------|
| DESIGNED BY: J.M.     | CHECKED BY: W. DANIEL |
| TRACED BY: H. RUSSELL | PL. BY: J. H. 88      |
| PROJECT No: 1-912(10) | SHEET 258 OF 868      |
| CONTRACT No:          |                       |

68