

Excavation and Removal of Road Surfaces and/or Pavements
Ramp C' 2+60-3+40-Lt.

Plank Guard Rail
Ramp C' 3+25-Lt.

Jute Matting
NB 5181+00-5182+50 Lt.
SB 5185+00-5186+50 Lt.
NB 5185+02-5186+40 Lt.

Property Line Fence w/Steel Posts
Rte 25 57+02-Lt-SB 5189+95 Lt.
TH=27 1+00-NB 5187+80 Rt.

Steel Beam Guard Rail
Ramp G. 5+95-5189+62 Lt.

APPROACH RAILING - 2 RAIL ALUMINUM *

NB 5187+62 ~ 5189+87 Lt.
NB 5187+69 ~ 5189+94 Rt.
SB 5176+59 ~ 5177+67 Lt.
SB 5176+21 ~ 5177+31 Rt.
SB 5179+86 ~ 5182+11 Rt.
SB 5180+12 ~ 5182+37 Lt.
SB 5185+76 ~ 5189+89 Lt.
SB 5188+80 ~ 5189+93 Rt.
NB 5174+85 ~ 5177+10 Lt.
NB 5176+54 ~ 5176+81 Rt.
NB 5179+31 ~ 5180+43 Rt.
NB 5179+60 ~ 5180+72 Lt.

* Treated Timber Curb

SB 5181+00-5182+00 Lt.
NB 5177+00-5176+01
SB 5180+00 = Rt.


* REMOVAL & DISPOSAL OF EXISTING GUARD RAIL

NB RT. 5171+99 ~ 5177+00
SB LT. 5177+00 ~ 5177+65

Topsoil Stockpiles
Ramp B 7+50 - 4+50 Rt. (1040 cu)
Ramp C 1+00 - 2+05 Lt. (530 cu)
Ramp C 3+00 - 4+35 Lt. (530 cu)
Ramp C 5+00 - 6+25 Lt. (470 cu)

* GUARD RAIL, STD STEEL BEAM w/ STEEL POSTS - TYPE II
NB 5171+99 ~ 5176+54
75

* STAGE 2 CONSTRUCTION ITEM

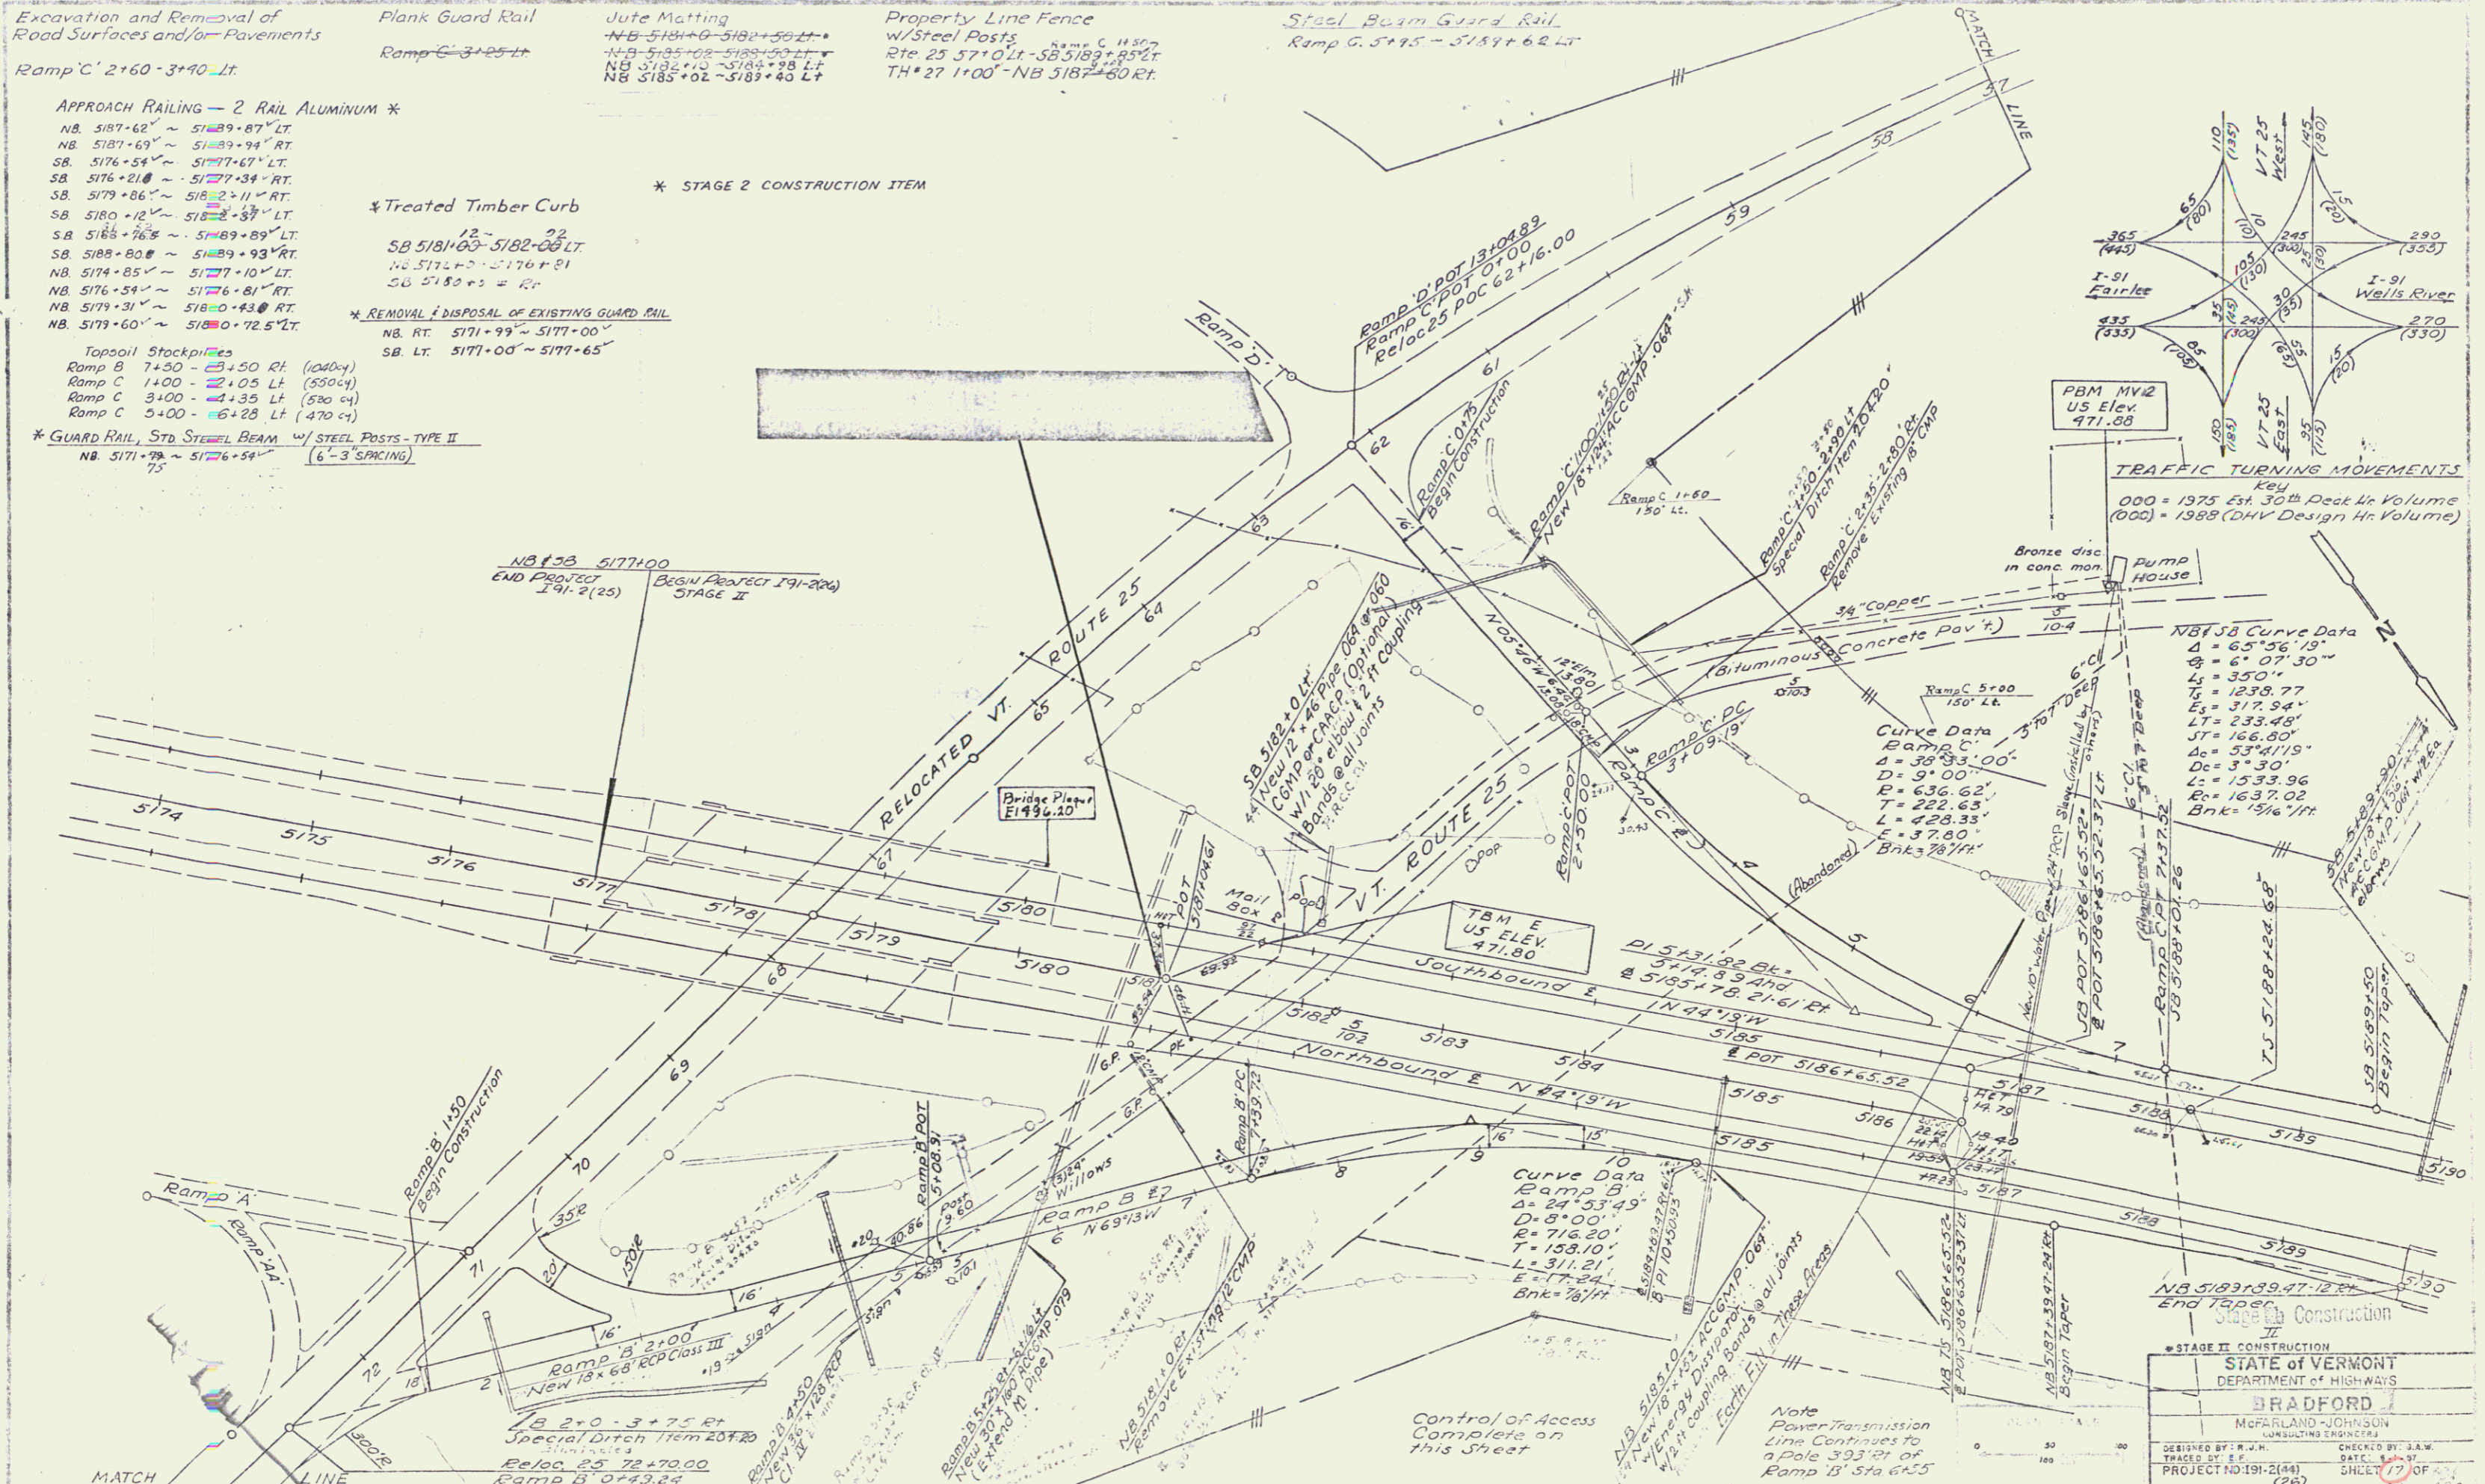

See sheet 26 of 181

POOR ORIGINAL COPY

Bradford-Ryegate

STATE OF VERMONT
DEPARTMENT OF HIGHWAYS
BRADFORD
McFARLAND-JOHNSON
CONSULTING ENGINEERS
DESIGNED BY: R.J.W. CHECKED BY: J.A.W.
TRACED BY: E.E. DATE: 6-2-97
PROJECT NO: 191-2144 SHEET 17 OF 75C
(26)