

STATE OF VERMONT  
DEPARTMENT OF HIGHWAYS  
RIGHT-OF-WAY PLANS  
DETAIL SHEET  
3 OF 18

TABLE OF PROJECT PROPERTY ACQUISITION


PARCEL NO.	GRANTOR	SHEET NO.	BEGINNING STATION	ENDING STATION	TAKING	REM.	RIGHTS	TITLE TAKEN	DATE	TOWN OR CITY RECORDED	BK.	PG.	REMARKS
13	Frank E. & Virginia H. Deters	33 34	§ 5253+41 § 5253+46LT § 5253+00RT	§ 5260+16 § 5260+16LT	72A+1A		Drainage (P) Drainage (P) Drainage (P) Drainage (P)	Cond	1-4-72	Bradford	41	340 346	Area Computed Loss of Access (347A) Spring § 5254+50 Lt See Parcel 69
			§ 5258+00RT § 5260+00RT § 5254+35LT § 5253+46LT § 5253+41RT	§ 5260+16LT § 5260+15RT		34.7 A <sup>2</sup> 10.7 A <sup>2</sup> 81.4 A <sup>2</sup>							Other lands located On Rec 5
14	Airmon C. & Katherine D. Burgess	41 42	§ 5260+15 § 5260+16LT § 5262+00RT	§ 5275+67 § 5275+67LT	184A+1A		Drainage (P) Drainage (P) Drainage (P) Drainage (P) Drainage (P)	Cond	1-4-72	Bradford	41	340 346	Area Computed Loss of Access (90A) Spring § 5262+45 Rt See Parcel 70 Loss of Access and Removal of Buildings § 5262+50 Rt Spring
19A			§ 5267+00RT § 5270+50RT § 5271+30RT § 5264+50LT § 5268+00RT § 5260+16 LT § 5260+15 RT	§ 5275+67LT § 5271+32RT	90.0 A <sup>2</sup>	191.6 A <sup>2</sup>		WD	3-15-72	Bradford	41	440	PPM 80-1 PAR 7A (2)
15	Leon C. & Winnifred E. Norcross	50 51	§ 5271+92 § 5275+00RT § 5275+25RT § 5271+92RT	§ 5275+35 § 5275+23RT	064+1A		Drainage (P) Drainage (P)	WD	1-11-72	Bradford	41	332	Area Computed
16	Paul K. & Mary Elizabeth Goren Rogers	57 58	§ 5275+23 § 5275+67LT § 5275+25RT § 5275+15RT § 5275+67LT § 5275+25RT	§ 5282+35 § 5282+35LT § 5282+55RT § 5282+55RT § 5282+55RT § 5282+55RT	844+1A		Drainage (P) Drainage (P)	Cond	1-4-72	Bradford	41	340 346	Area Computed Loss of Access (30.2A)
17	Green Mountain Stables, Inc	59	§ 5282+53 § 5282+53LT § 5282+53LT § 5282+53RT	§ 5290+168 § 5290+168LT § 5290+168LT § 5290+168RT	10.1A+1A			Cond	1-4-72	Bradford	41	350 346	Area Computed
17A			§ 5282+53RT	§ 5290+168RT	33.0 A <sup>2</sup>	15.0 A <sup>2</sup>		WD	3-16-72	Bradford	41	439	PPM 80-1 PAR 7A (2)
18	Morris D. & Nancy P. Derry	59 60	§ 5290+168 § 5290+168LT § 5290+168LT § 5290+168RT	§ 5294+78 § 5294+78LT § 5294+98LT § 5294+38RT	6.7A+1A			WD	1-27-72	Bradford	41	352	Loss of Access (20A)
						20A <sup>2</sup> 6.9 A <sup>2</sup>							

TABLE OF REVISIONS

REVISION NO.	SHEET NO.	DESCRIPTION OF REVISION	DATE	MADE BY	APPROVED BY
26	15	Parcel # 15 Added Loss of Access of sta. 5362+18LT - 5371+07LT of 69.5A <sup>2</sup> in the town of Bradford and sta. 5393+07LT - 5428+00LT of 180A <sup>2</sup> in the town of Newbury Fer. CO #1672	2-4-70	KMD	J.P.M.
26	28	Parcel # 115 Not Drawn On R.O.W. Plans At Sta. § 5217+71 Lt. Per Change Order # 1629	8-2-71	KMD	
27	220, 23, 130	Added New Parcels #146A, B, C, D To Plans Per Change Order #1739	11-3-70	WJM	J.P.M.
28	103, 105, 107	ADDED ACCESS ROAD PER C.O. #1580 TO SHEETS 103, 105, 107.	2-2-71	W.E.B.	J.P.M.
29	103, 105, 107, 109	CHANGED LIMITED ACCESS & ADDED ON PARCELS 55E & 49D PER CHANGE ORDER # 1580	2-2-71	KMD	J.P.M.
30	49, 51, 133	Parcel # 28 Change in ownership from Mable J. De Costa to Angela D. & Douglas S. Stone and Elizabeth J. De Costa, Per Change Order # 1817	2-11-71	ES	J.P.M.
31	117, 118, 144	Parcel # 63 Change in ownership from Rose P. Dutton to Lucy Farley, Per Change Order # 1815	2-11-71	ES	J.P.M.
32	31, 33, 130	Parcel # 10 Change in property line and ownership Per Change Order # 1816	2-11-71	ES	J.P.M.
33		Parcel # 62 Added area of new portion of land purchased by Lee to detail sheet in the remarks column and plotted new total area sketch this parcel, Per Change Order # 1814	2-11-71	ES	J.P.M.
34	21, 117, 118, 144	PARCEL # 63 CHANGE IN OWNERSHIP FROM LUCY FARLEY TO ROSE P. DUTTON, PER CO #1850	3-15-71	KMD	J.P.M.
35	228, 9A	Parcel # 115 Correction In Title. Per Change Order # 1885	4-15-71	KMD	J.P.M.
36	226, 9A	PARCEL # 126 CORRECTION IN TITLE. PER CHANGE ORDER # 1884	4-15-71	KMD	J.P.M.

POOR ORIGINAL COPY

MADE BY: V.S. Waldon DATE: 6-22-68  
CHECKED BY: G.E. O'Neil DATE: 8-20-68

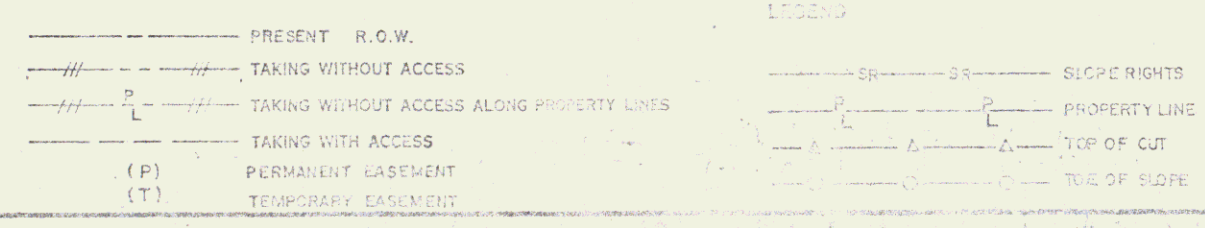

APPROVED: Thomas C. Remondy DATE: 1-16-67  
CHIEF OF ACQUISITION  
APPROVED: Waldon, V.S. DATE: 1-16-67  
DEPUTY CHIEF OF ACQUISITION  
APPROVED: H.P. K... .. DATE: 1-16-67  
SUPERVISOR

PROJECT: BRADFORD-NEWBURY  
NO. I-91-2(10)  
SHEET 12 OF 150