


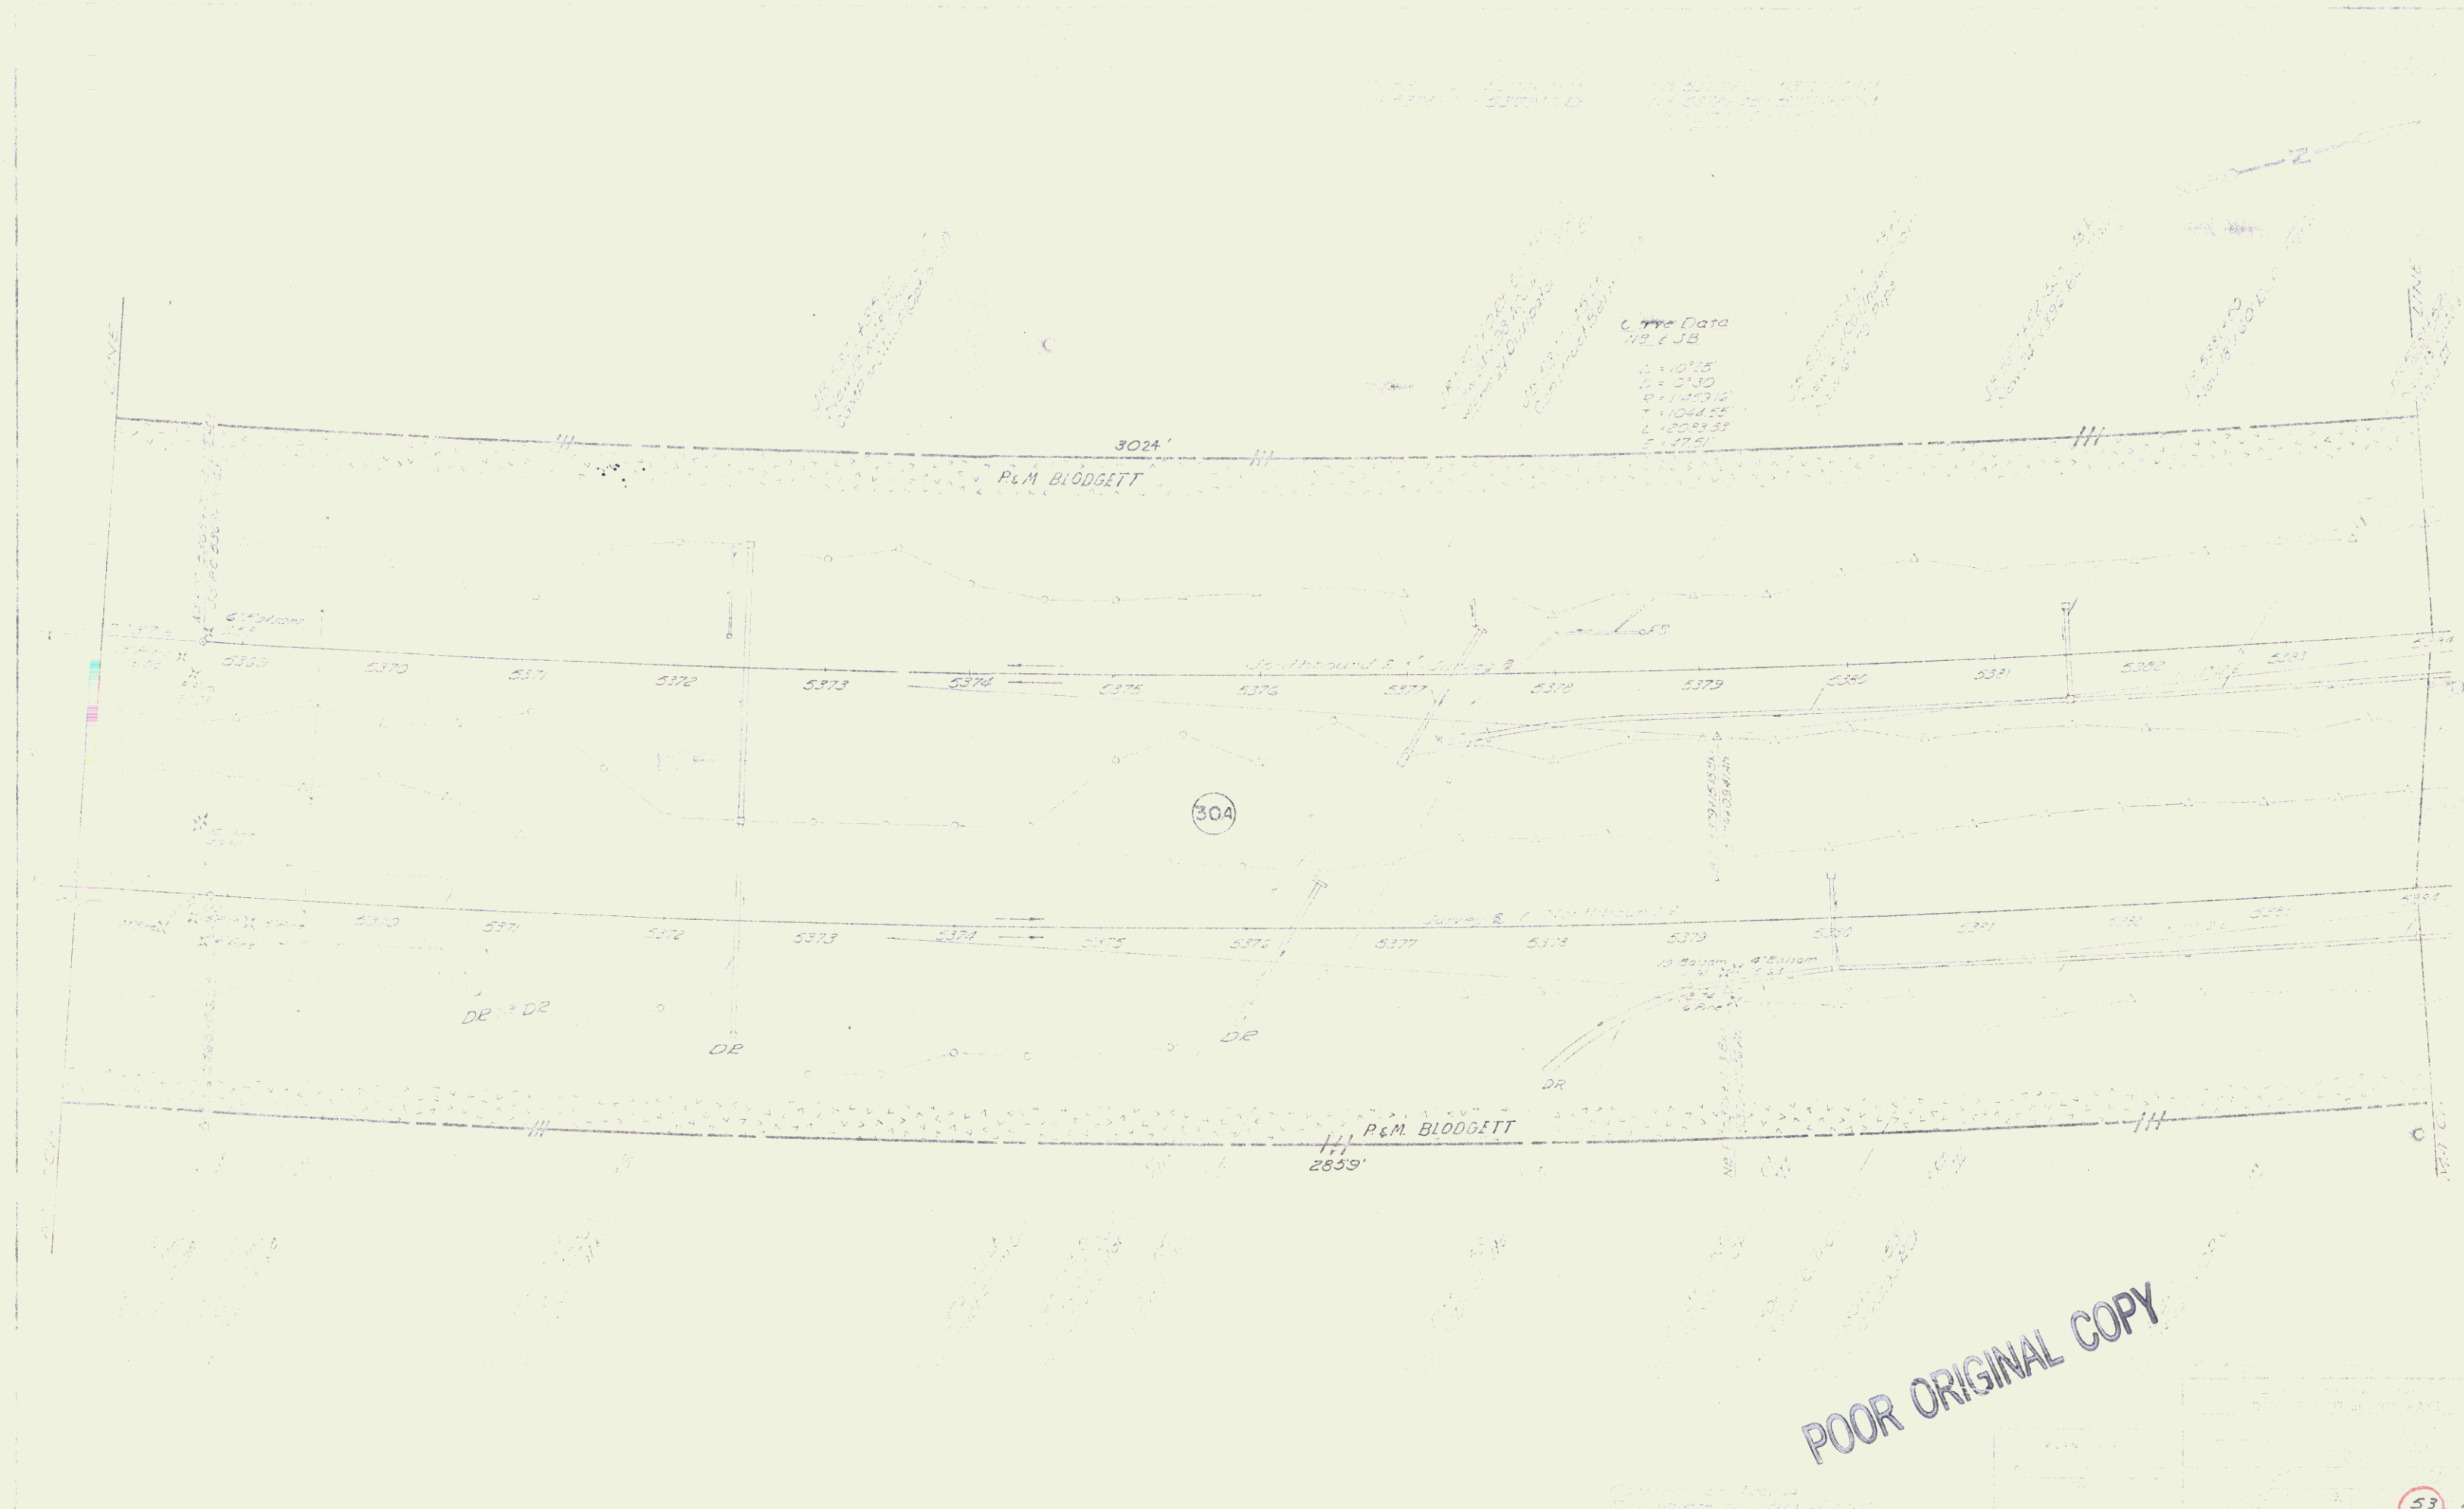

Curve Data
H.S. & J.B.
L = 101.25
P = 3130
D = 145.3
T = 1044.55
L = 1023.33
E = 127.51

3024'

P&M BLODGETT

304

P&M BLODGETT

2859'

POOR ORIGINAL COPY

53 150

R.O.W.

41