


5B 559810-5603+0.1'      5B 559810-559810.1'      5B 559810-559810.1'      5B 559810-559810.1'      5B 559810-559810.1'

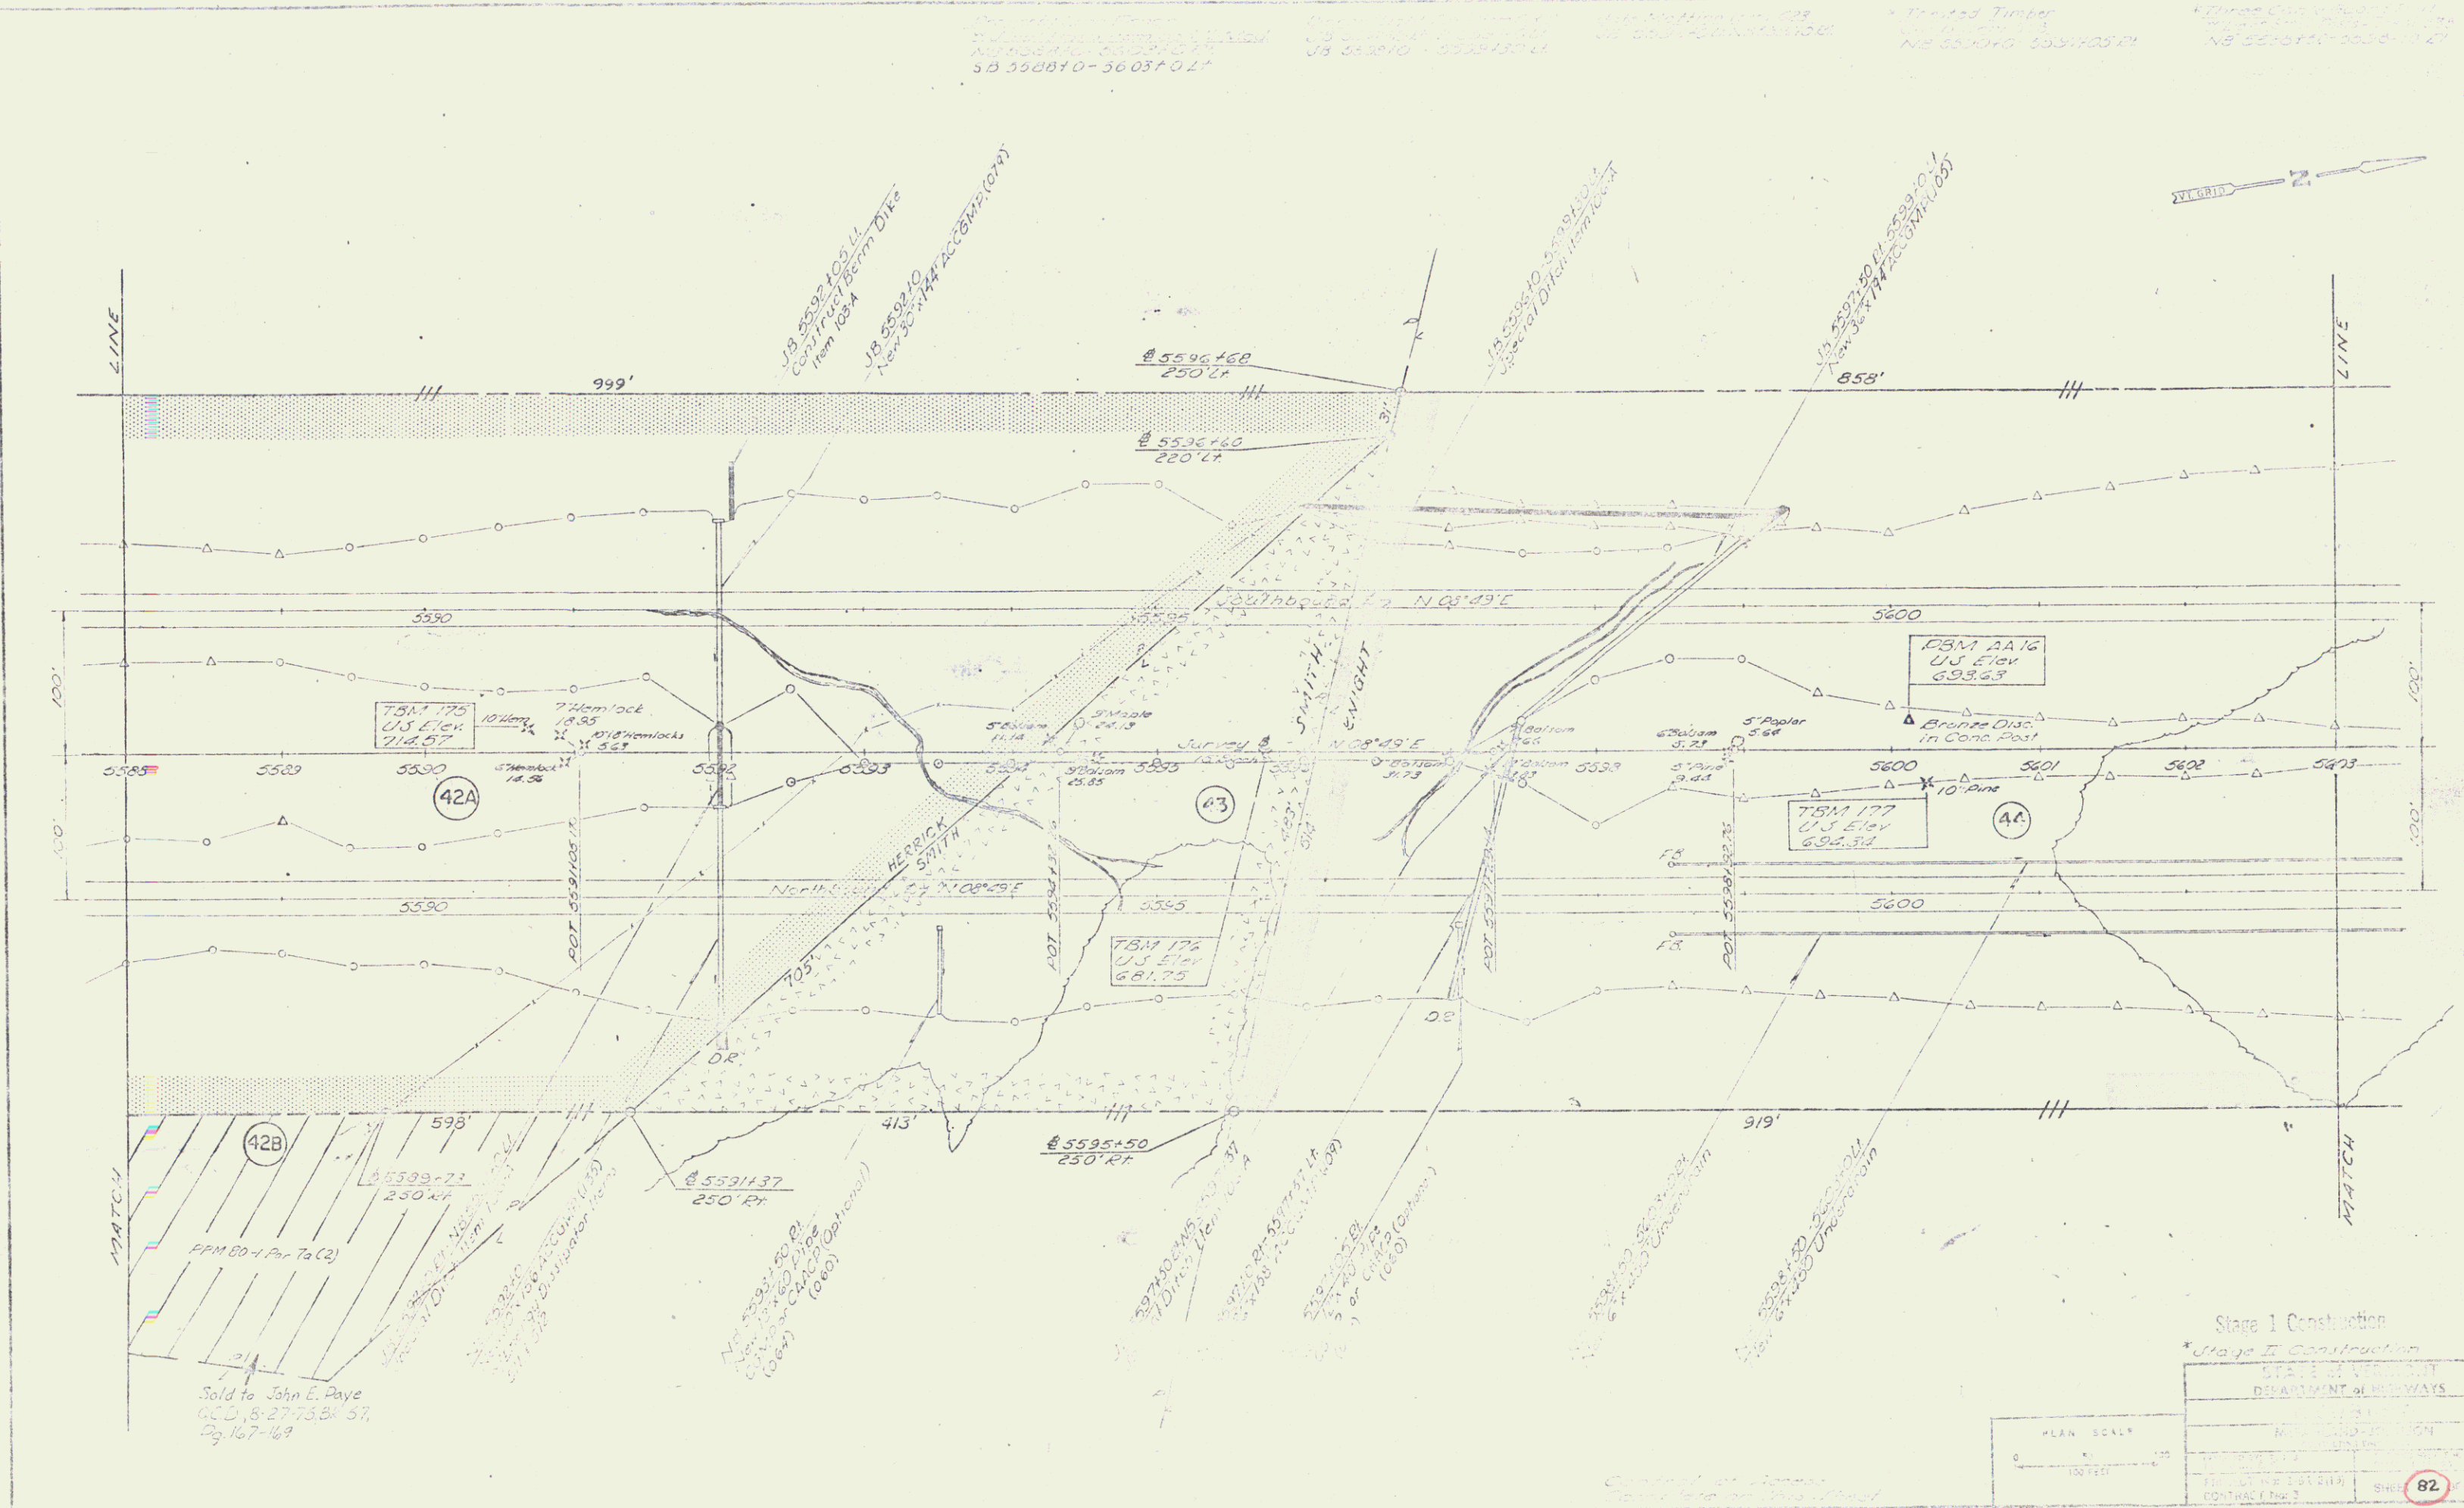

MATCH  
 42B  
 598'  
 5599+71  
 250' Pt.  
 Sold to John E. Payne  
 C.C.D. 8-27-75 Bk 57,  
 Pg 167-169

Stage I Construction  
 \* Stage II Construction

STATE OF VERMONT	82
DEPARTMENT OF HIGHWAYS	150
PROJECT NO. 101-111	
CONTRACT NO. 2	

PLAN SCALE  
 1" = 100'  
 SHEET 82 OF 150

5E