


Parcel 59F HARRY C. & MARYBELL BOYCE  
 BRADFORD-NEWBURY 191-2 (19)  
 TAKE AREA 0.68 ACRES ±  
 RIGHTS:  
 2+80 RT DRAINAGE (P)  
 5+30 RT DRAINAGE (P)  
 Revised 10-13-71

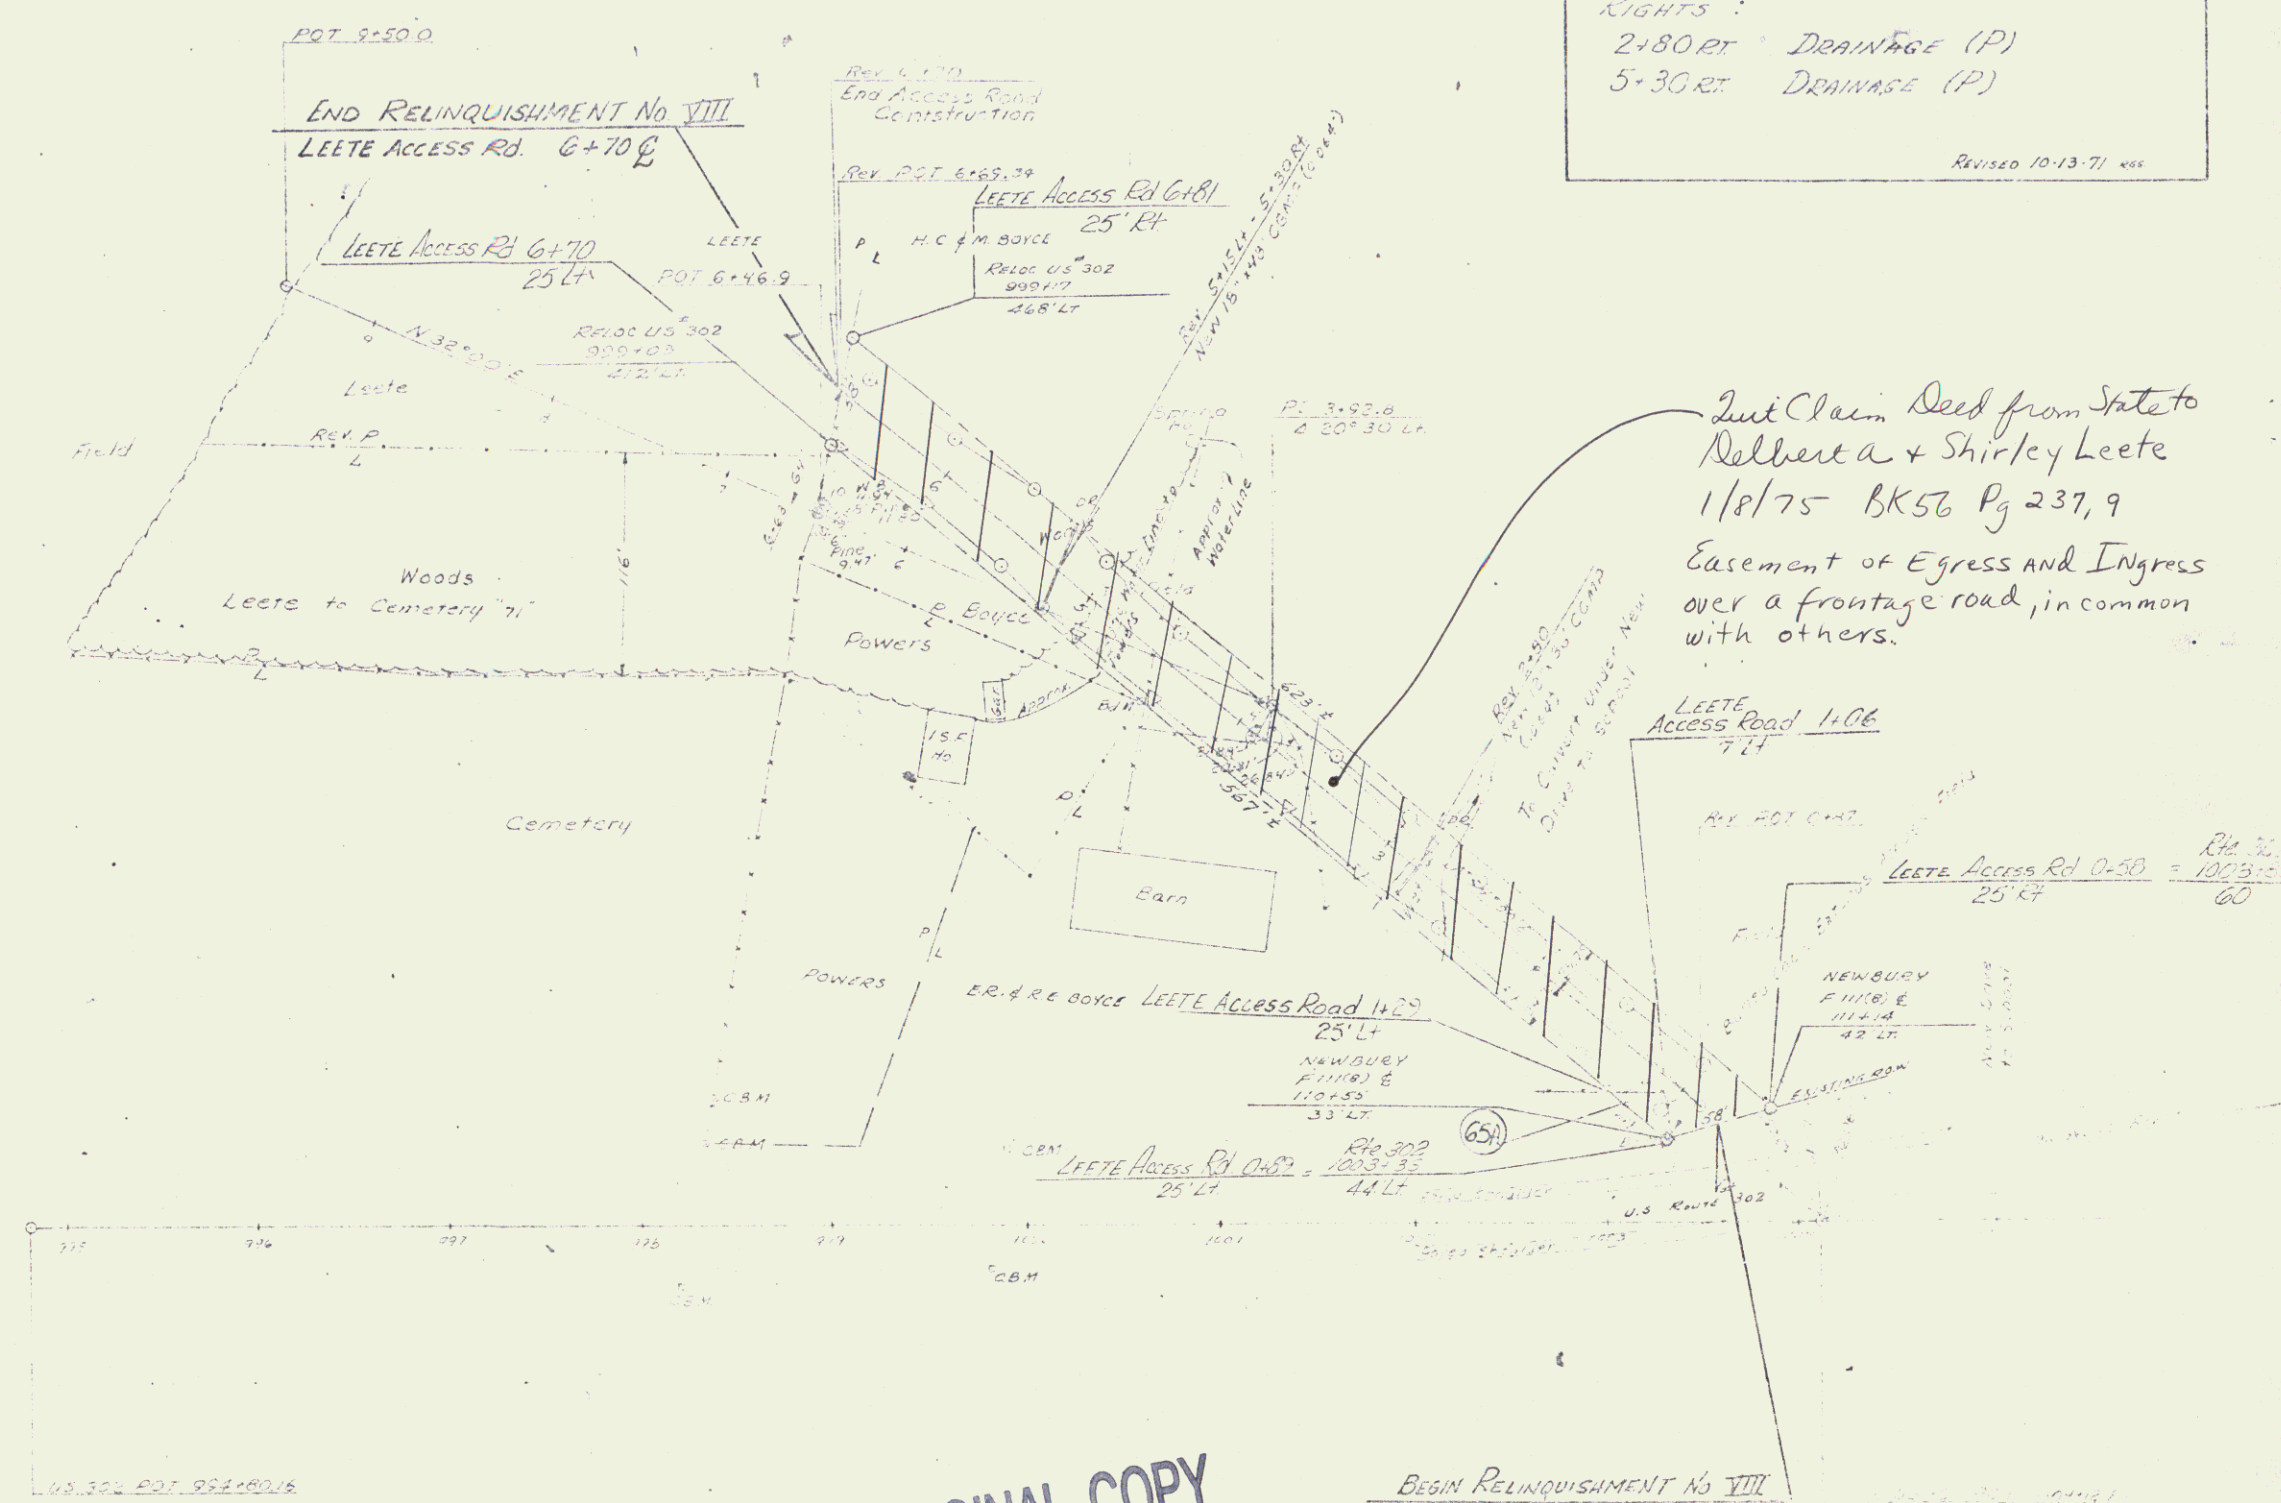

Quit Claim Deed from State to  
 Albert & Shirley Leete  
 1/8/75 BK 56 Pg 237, 9  
 Easement of Egress and Ingress  
 over a frontage road, in common  
 with others.

POOR ORIGINAL COPY

BEGIN RELINQUISHMENT No VIII  
 LEE TE ACCESS RD 0+75  
 (LENGTH 595'±)

NOTES  
 Easement E.O.D.

118A