

Drilling & Blasting of Solid Rock Subgrade
 NB 5202+70 - 5291+00

* GUARD RAIL, STD. STEEL BEAM
 † STEEL POSTS - TYPE II (6'-8" SPACING)
 NB 5275+00 - 5277+65 RT.

Woven Wire Fence
 NB 5275+00 - 5291+00 RT.
 SB 5275+00 - 5291+00 LT.

Stone Fill - Type I
 SB 5275+25 - 5282+00 LT.

Moss Fill - Type II
 NB 5275+00 - 5277+00 RT.
 NB 5279+10 - 5279+50 RT.
 SB 12+90 - 14+30


Stone Fill - Type III
 SB 5275+00 - 5277+03 LT.

Jute Matting
 NB 5275+27 - 5277+10 RT.
 NB 5281+15 - 5282+75 RT.
 NB 5283+10 - 5284+25 RT.
 NB 5284+25 - 5285+125 RT.

* Treated Timber Curb
 NB 5275+00 - 5280+10 RT.
 NB 5275+00 - 5276+50 RT.

* Guard Rail, Three Cable w/ Light Steel Posts
 SB 5275+00 - 5281+60 LT.

PLAN	PRINTED	1:1
SCALE	AS SHOWN	AS SHOWN
DATE	11/15/00	11/15/00
BY	BRAD	BRAD
CHECKED	BRAD	BRAD
APPROVED	BRAD	BRAD

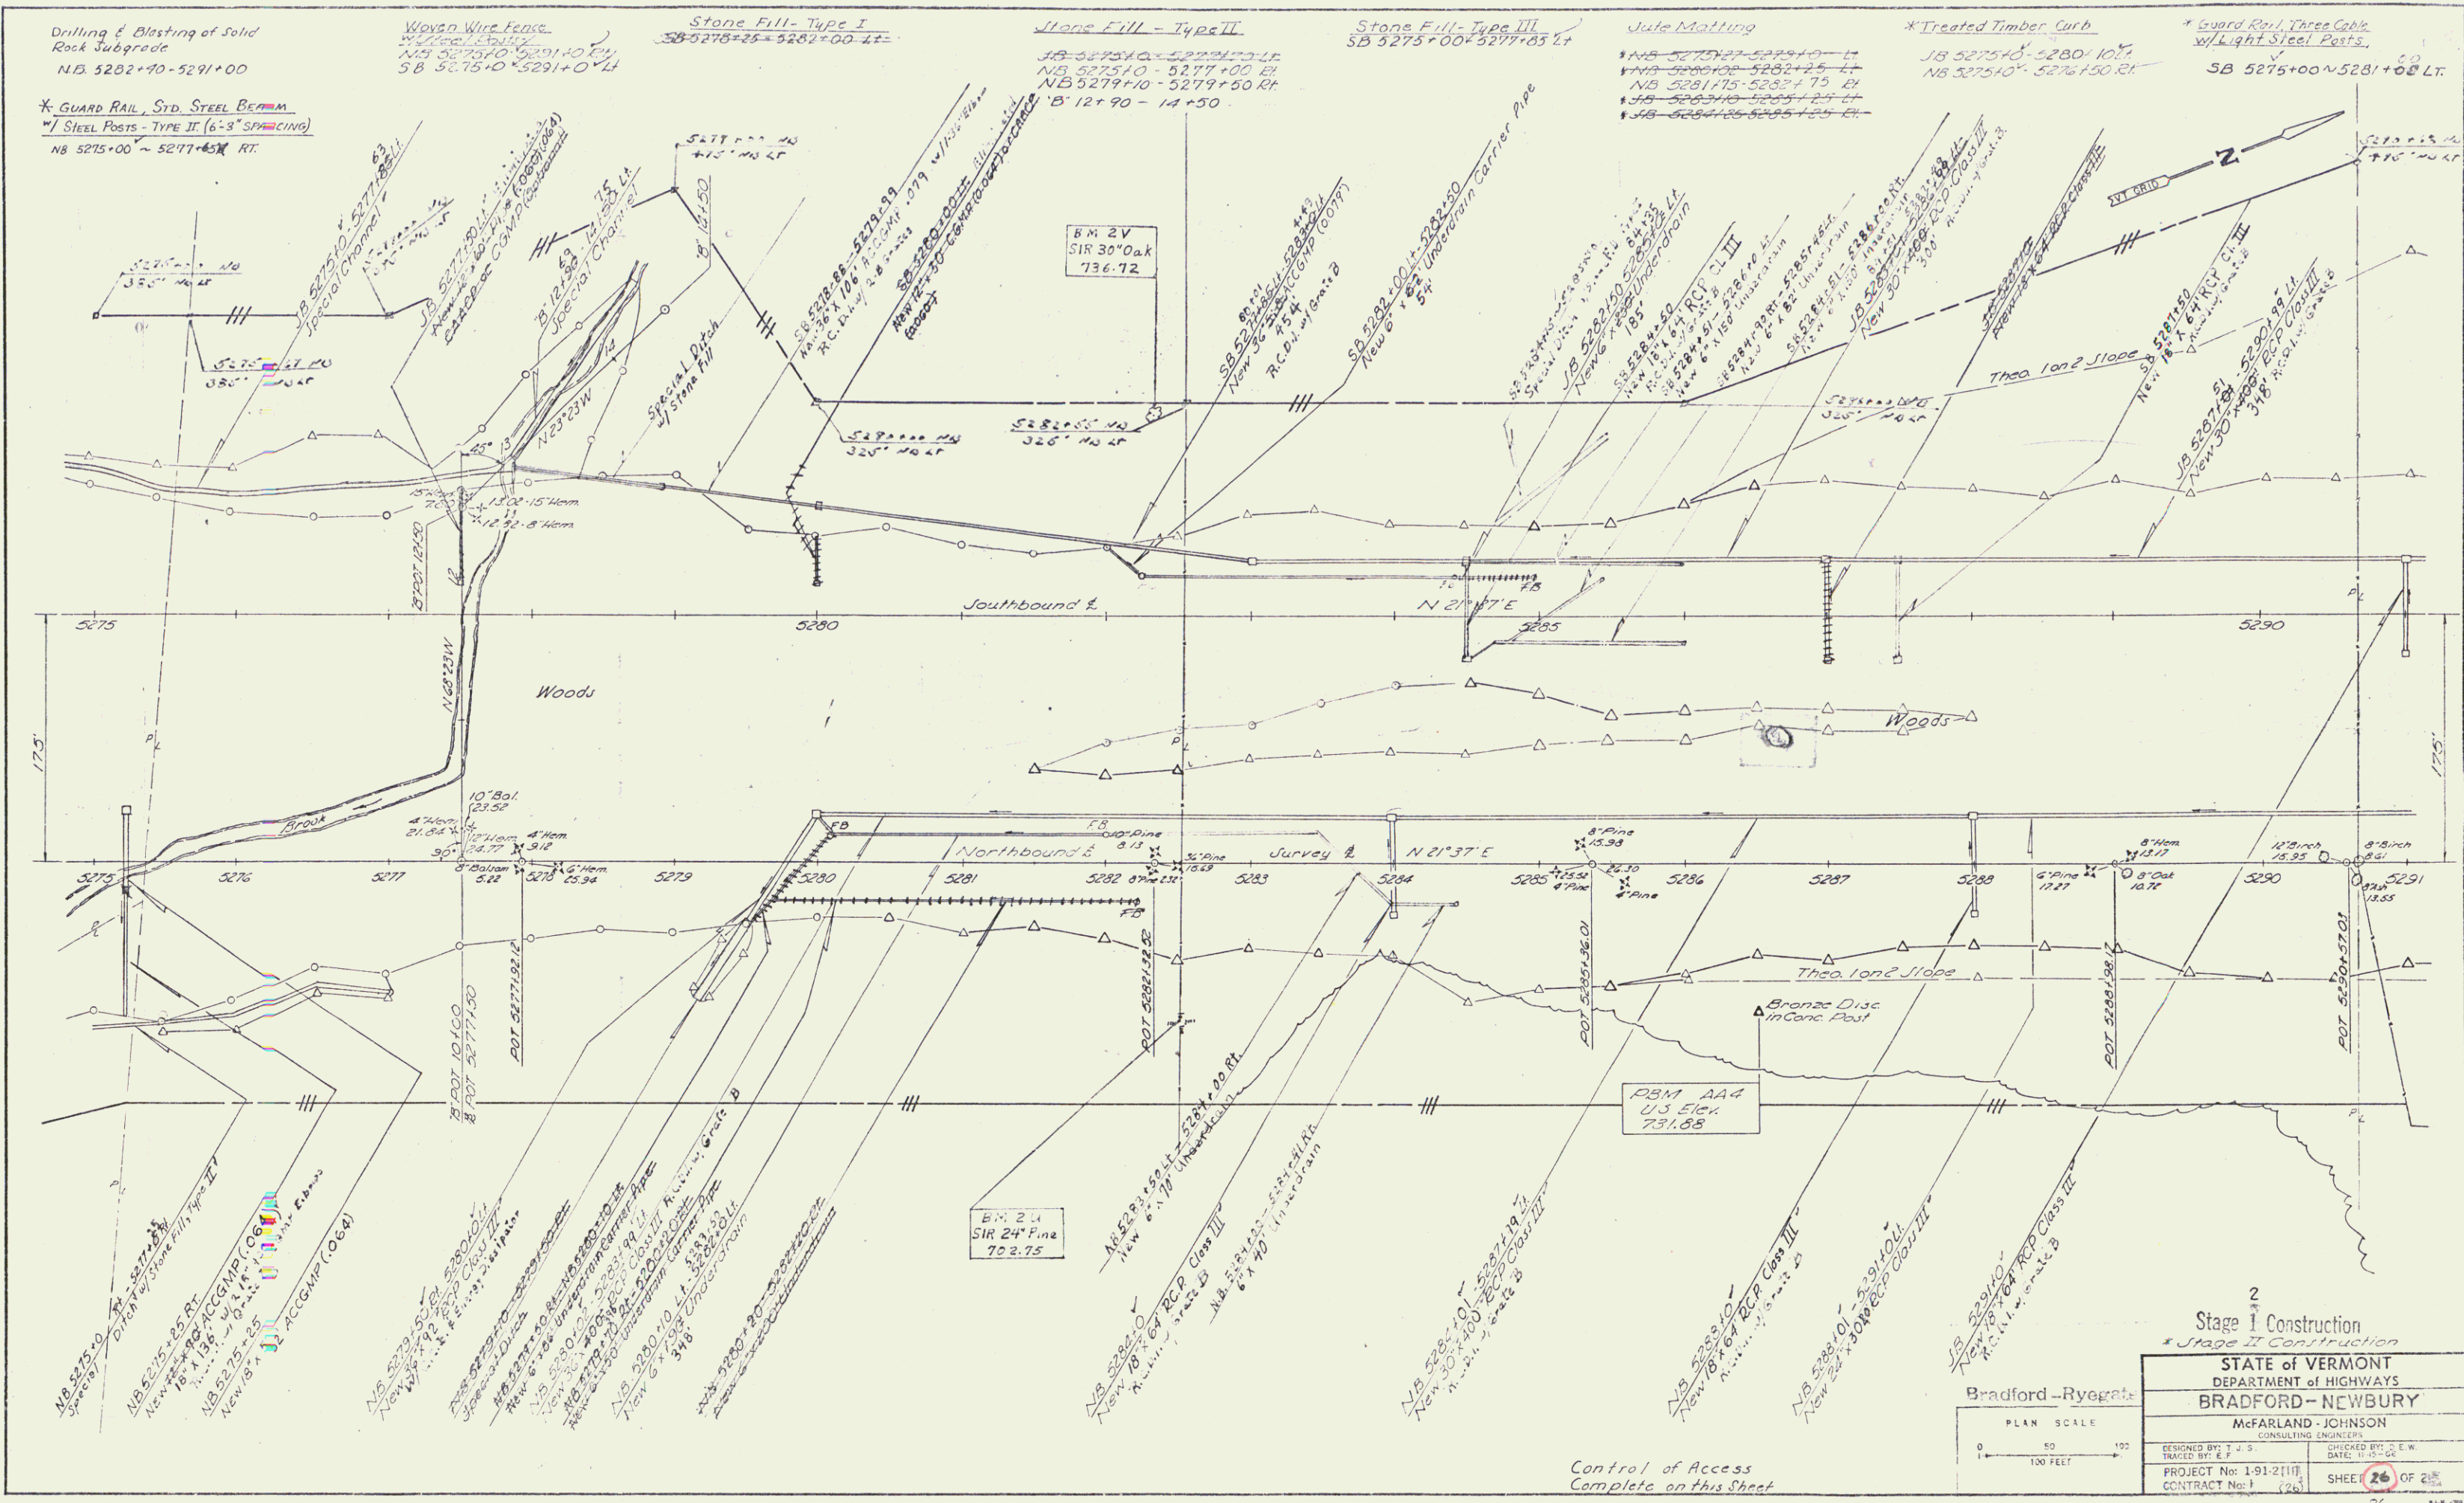

Control of Access
 Complete on this Sheet

Bradford-Ryegate

Stage I Construction
 * Stage II Construction

STATE of VERMONT
 DEPARTMENT of HIGHWAYS
 BRADFORD-NEWBURY

McFARLAND-JOHNSON
 CONSULTING ENGINEERS

DESIGNED BY: J.S.S.
 TRACED BY: E.F.
 PROJECT No: 1-91-2111
 CONTRACT No: 1 (26)

CHECKED BY: J.E.W.
 DATE: 11-15-00

SHEET 26 OF 26

86 430

Row/const