


Curve Data  
NB 1 JB  
Δ = 10° 25' 00"  
D = 0° 30"  
P = 11459.16'  
T = 10744.35'  
L = 2088.33'  
E = 87.51'  
Bnk = 0.021 R = 17'

Drilling and Blasting of  
Solid Rock Subgrade  
NB 5384+0 - 5391+30  
SB 5384+0 - 5389+0

Send Borrow  
NB 5392+00-5396+50

Woven Wire Fence w/ Steel Posts  
NB 5384+00 - 5400+00 RT  
SB 5384+00 - 5400+00 LT


Just-Matting  
\*NB 5382+04-5393+50 LT+RT

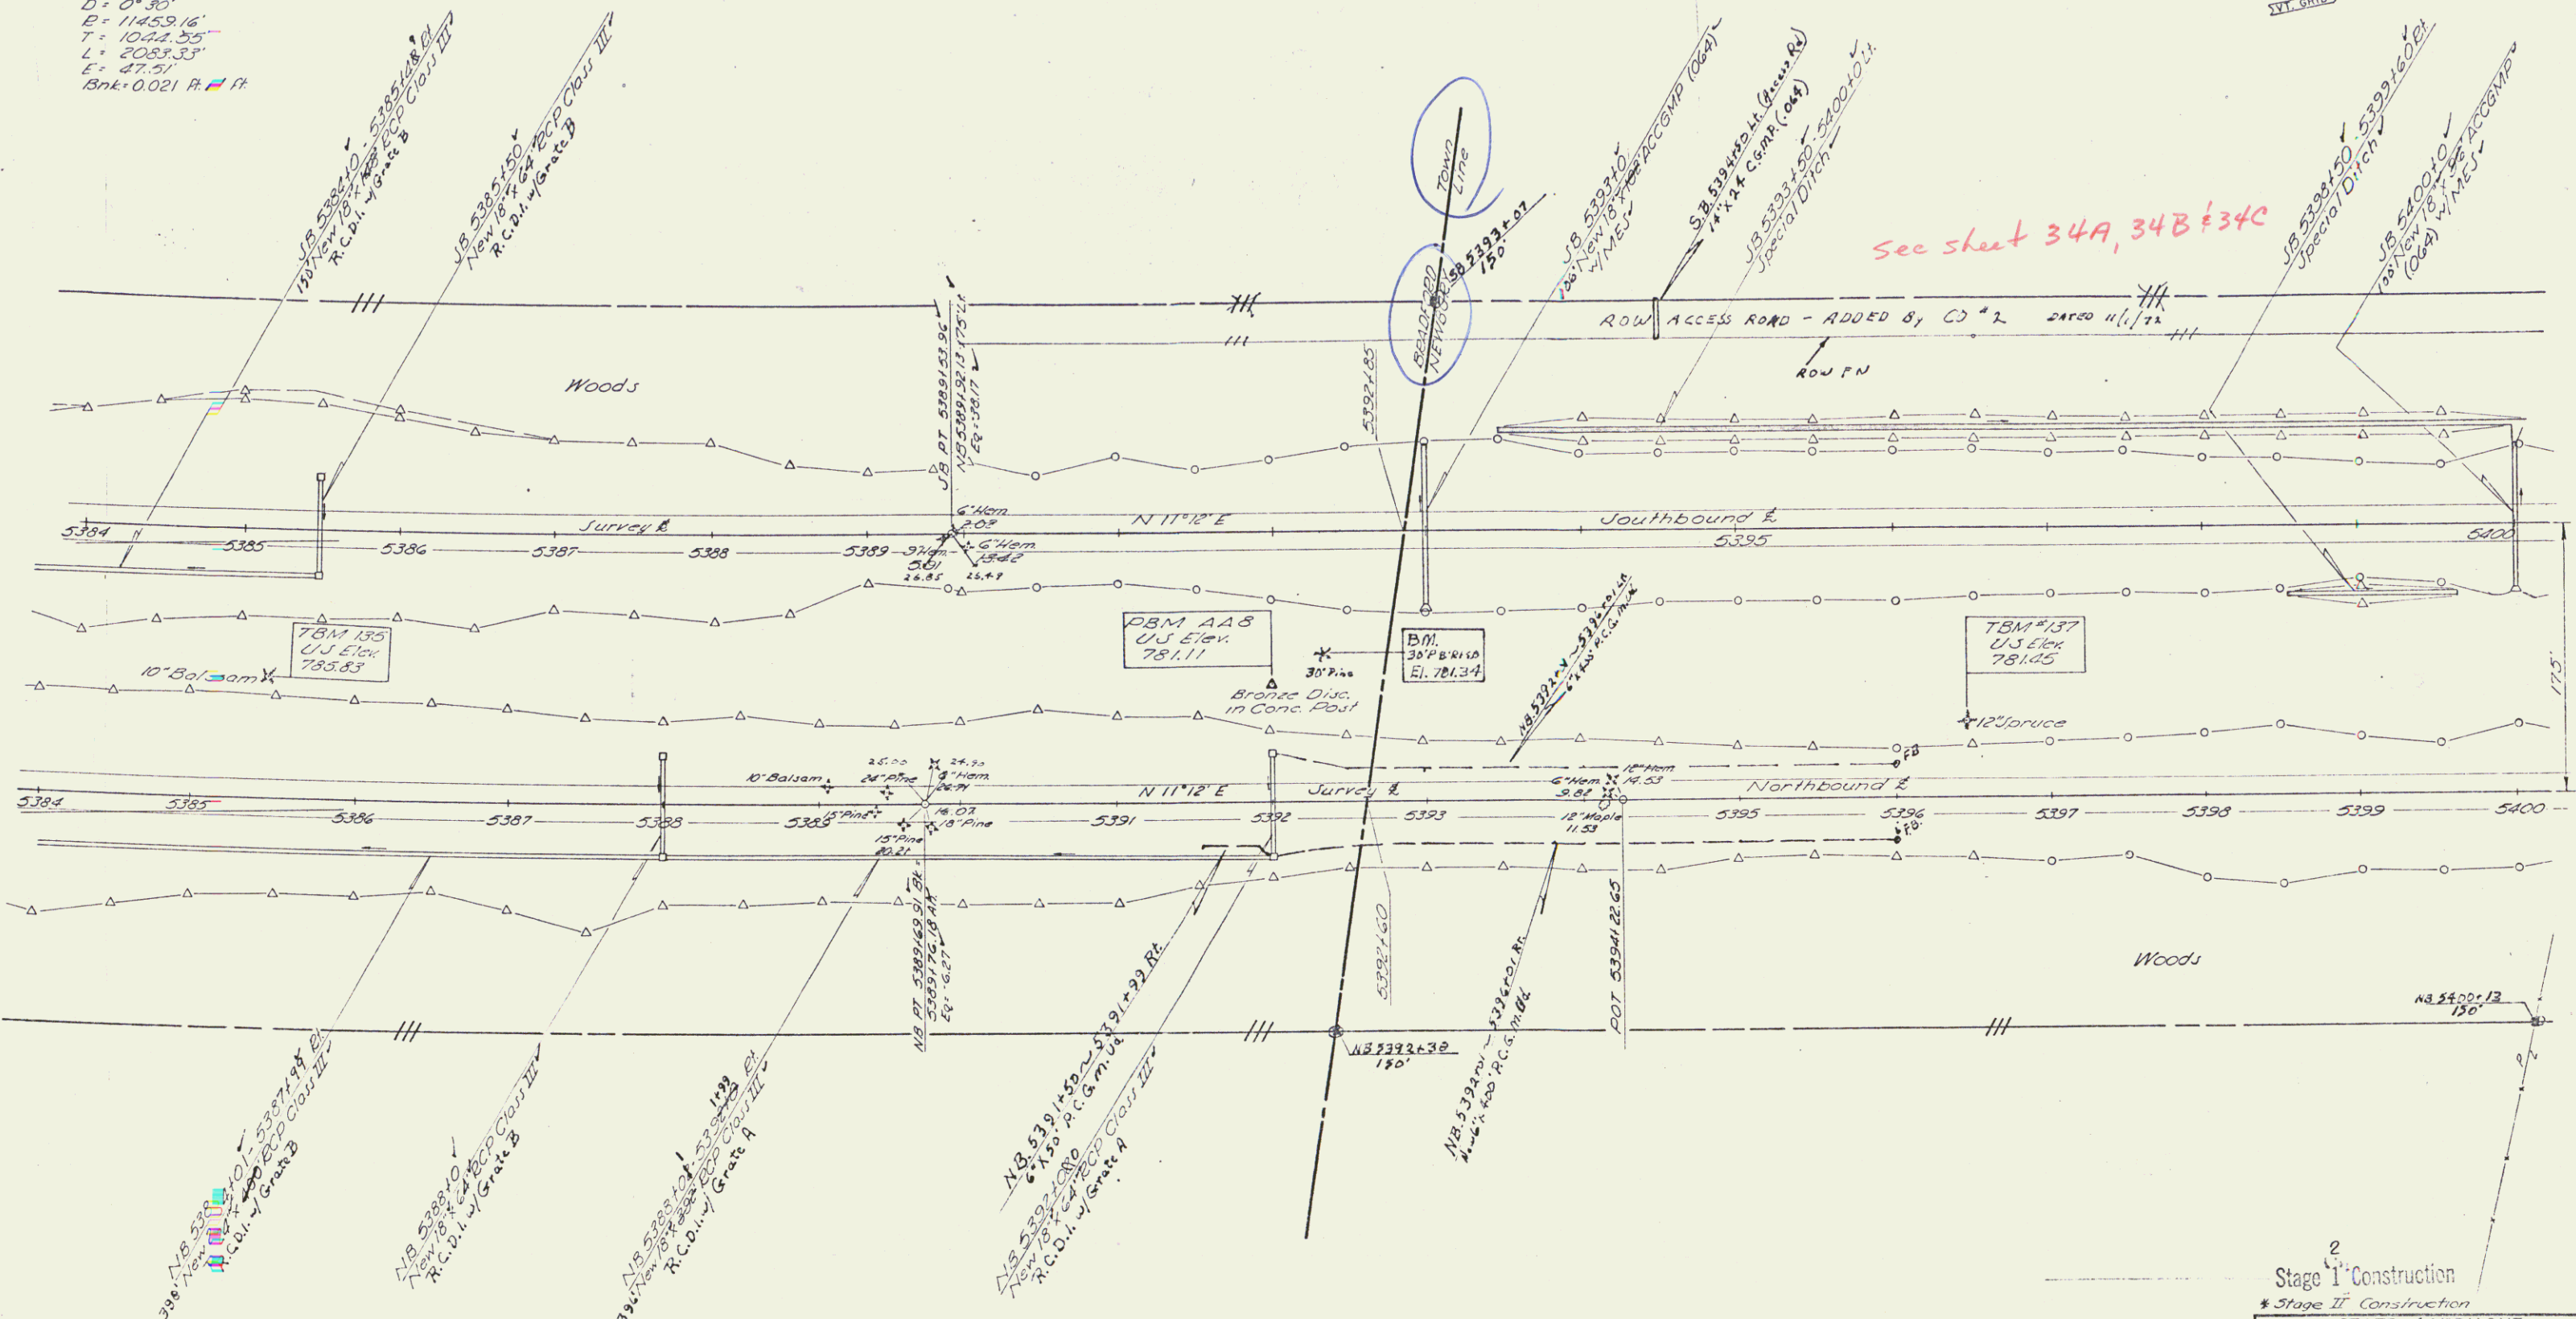

See sheet 34A, 34B & 34C

PLAN  
DATE: 11/1/22  
SCALE: AS SHOWN  
NOTE: BOOK 1, 2, 3, 999, 1000

Control of Access  
Complete on this sheet

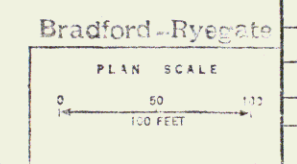

Stage I Construction	
* Stage II Construction	
STATE OF VERMONT DEPARTMENT OF HIGHWAYS BRADFORD-NEWGURY	
McFARLAND-JOHNSON CONSULTING ENGINEERS	
DESIGNED BY: F.A.S.	CHECKED BY: J.C.W.
DRAWN BY: S.P.	DATE: 3/15/24
PROJECT No: 1-912(11)	CONTRACT No: 2 26
SHEET 34 OF 347	

R.D.W./const

97