

Drilling and Blasting of
Solid Rock Subgrade
NB 5416+75 - 5419+25
NB 5421+75 - 5423+25



Sand Borrow
NB 5416+00 - 5417+00

ROW
CONSTRUCT ACCESS ROAD
5416+00 SB LT - 5432+00 SB LT

Woven Wire Fence
T/F Post
JB 5416+00 - 5432+00
NB 5416+00 - 5432+00


Stone Fill, Type II
NB 5420+00 - 5422+55
NB 5420+00 - 5422+55
NB 5423+25 - 5425+45

Sub-Grading
NB 5417+00 - NB 5417+00
NB 5417+00 - NB 5417+00

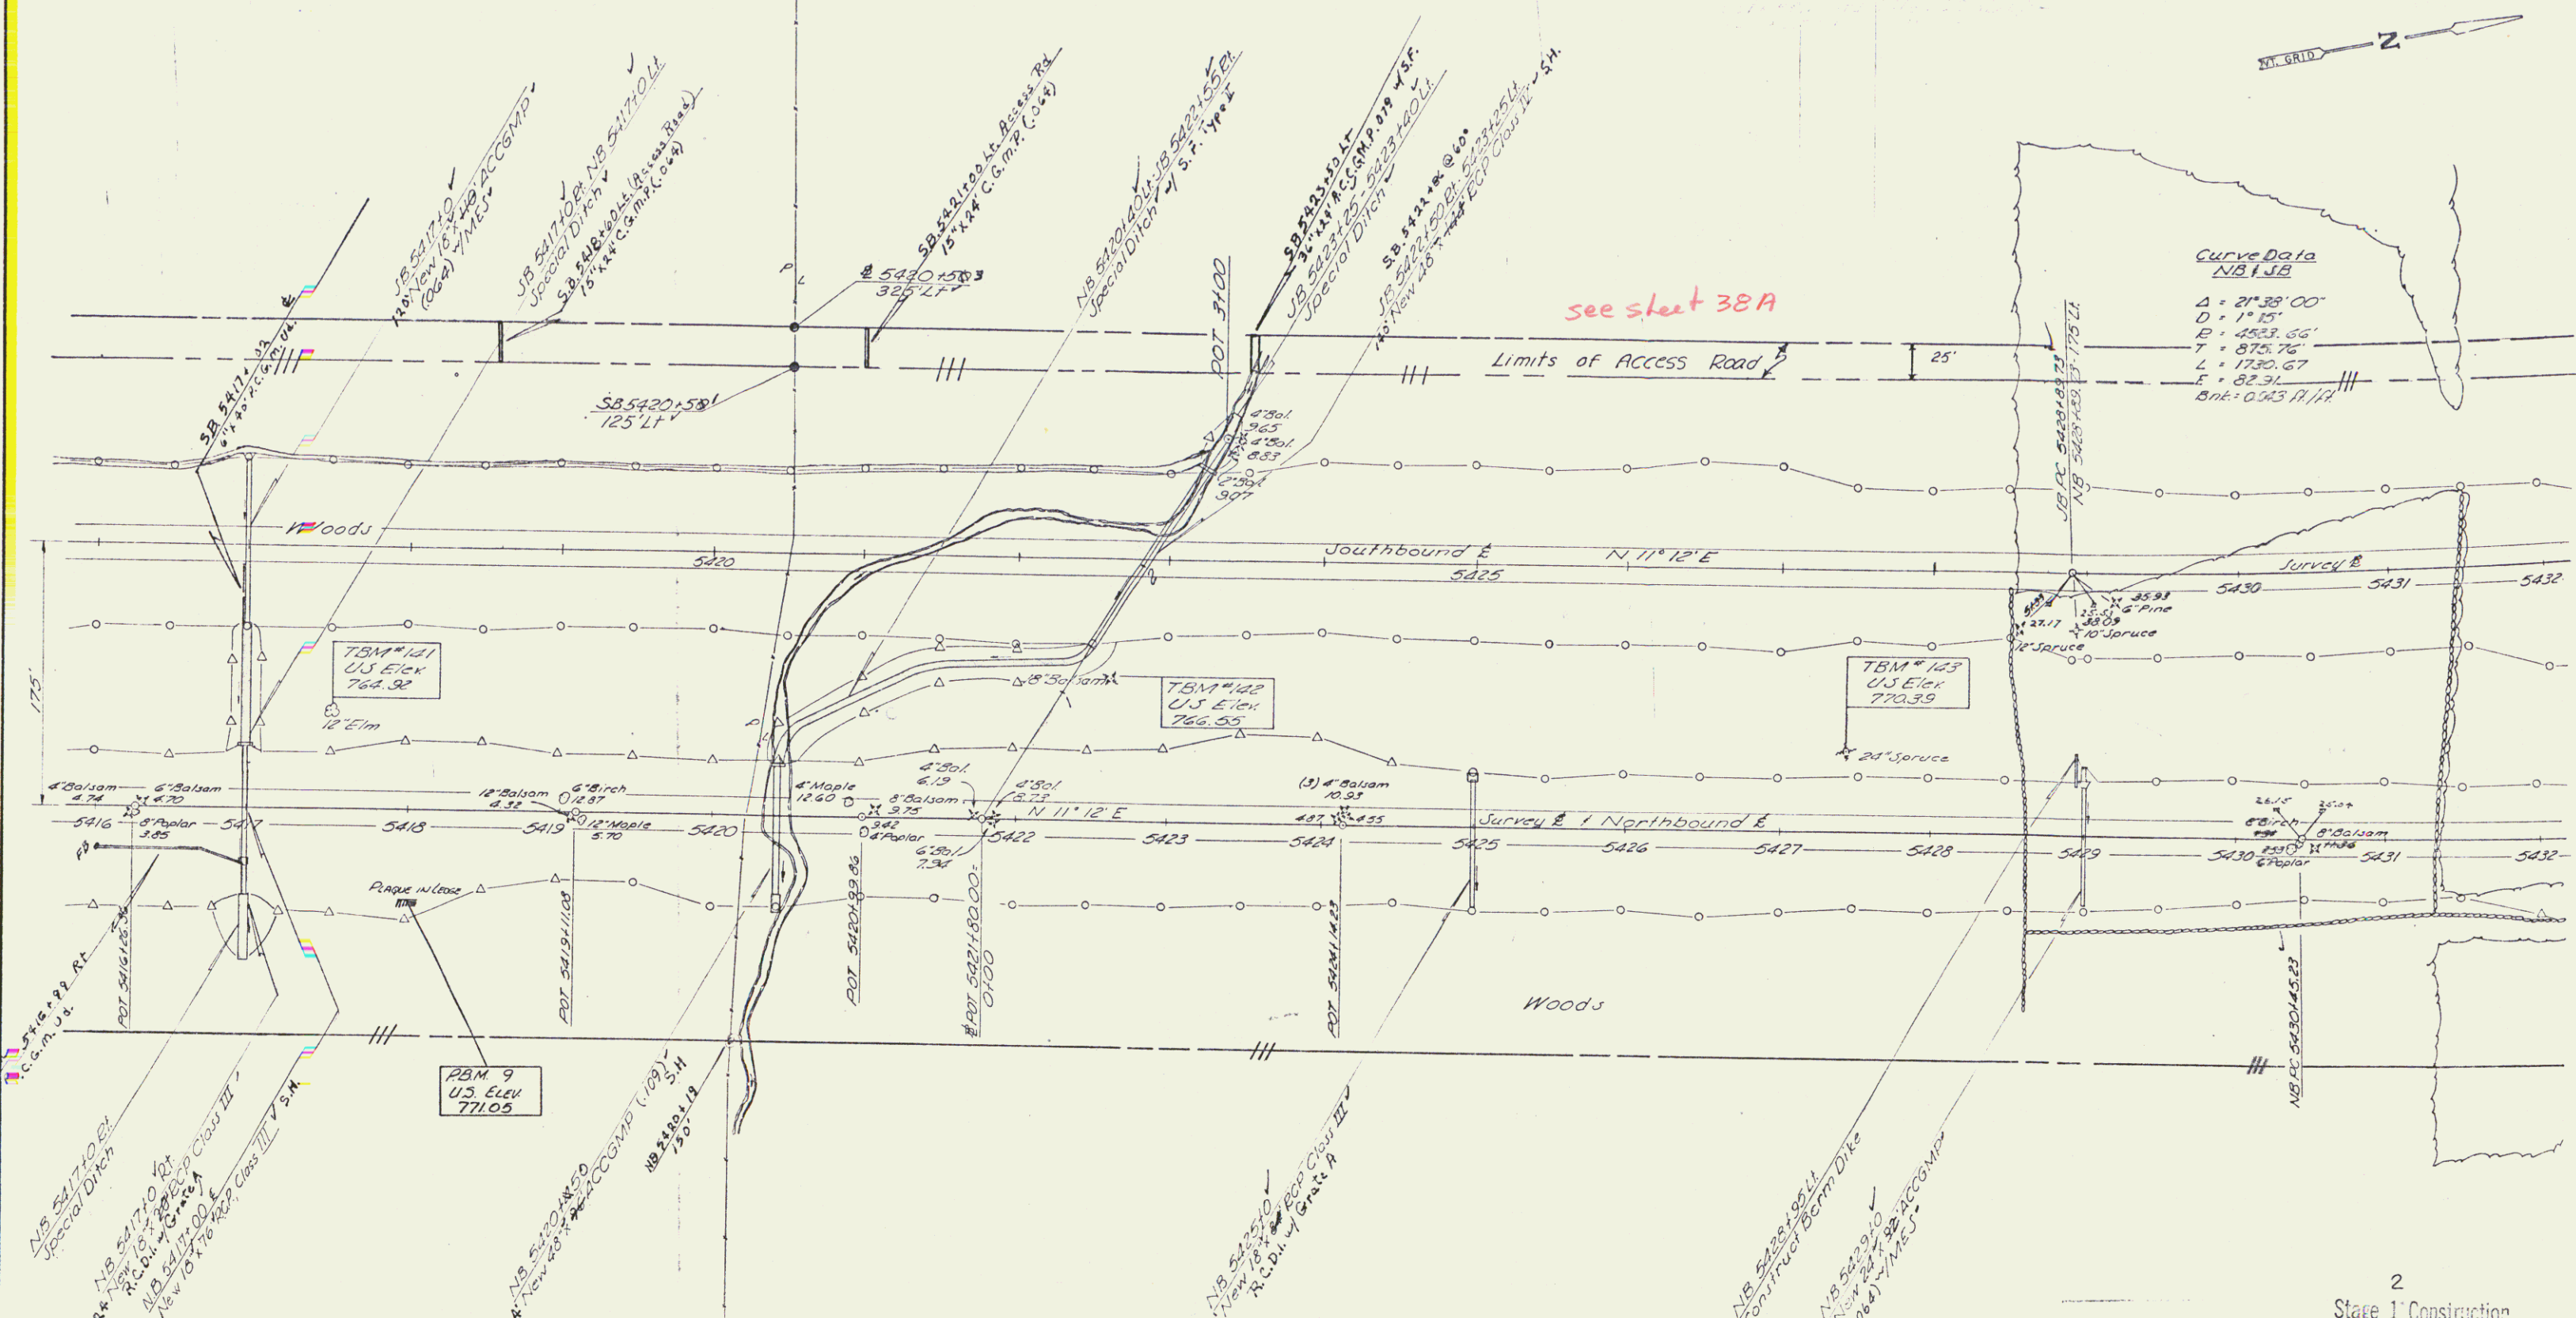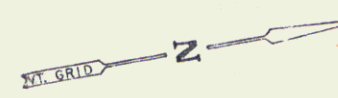

Curve Data
NB 1/2
 $\Delta = 21^{\circ}38'00''$
 $D = 1^{\circ}15'$
 $E = 4523.65'$
 $T = 8745.76'$
 $L = 1730.67'$
 $E = 82.31'$
 $Bst = 0.543 R/112'$

PLAN	DATE
NO. 1	10/1/88
NO. 2	10/1/88
NO. 3	10/1/88
NO. 4	10/1/88
NO. 5	10/1/88
NO. 6	10/1/88
NO. 7	10/1/88
NO. 8	10/1/88
NO. 9	10/1/88
NO. 10	10/1/88

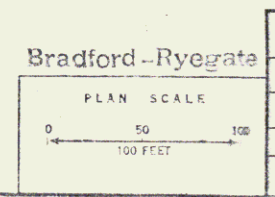

STATE OF VERMONT DEPARTMENT OF HIGHWAYS BRADFORD-NEWBURY McFARLAND-JOHNSON CONSULTING ENGINEERS	
DESIGNED BY: F. J. S.	CHECKED BY: J. E. W.
PROJECT No: 1-91-2(1)	DATE: 3-15-88
CONTRACT No: 2	SHEET 38 OF 347

Control of Access
Complete on this sheet

R.O.W/const 103