

Drilling and Blasting of
Solid Rock Subgrade
NB 5416+75 - 5419+25
NB 5421+75 - 5423+25


Sand Borrow
NB 5416+00 - 5417+00

ROW
CONSTRUCT ACCESS ROAD
5416+00 SB LT - 5432+00 SB LT



Woven Wire Fence
7" Steel Posts
NB 5416+00 - 5432+10
NB 5416+00 - 5432+10
NB 5416+00 - 5432+10

Stone Fill, Type II
NB 5420+00 - NB 5422+50
NB 5420+00 - NB 5422+50
NB 5420+00 - NB 5422+50

Gate Matting
NB 5417+00 - NB 5417+00

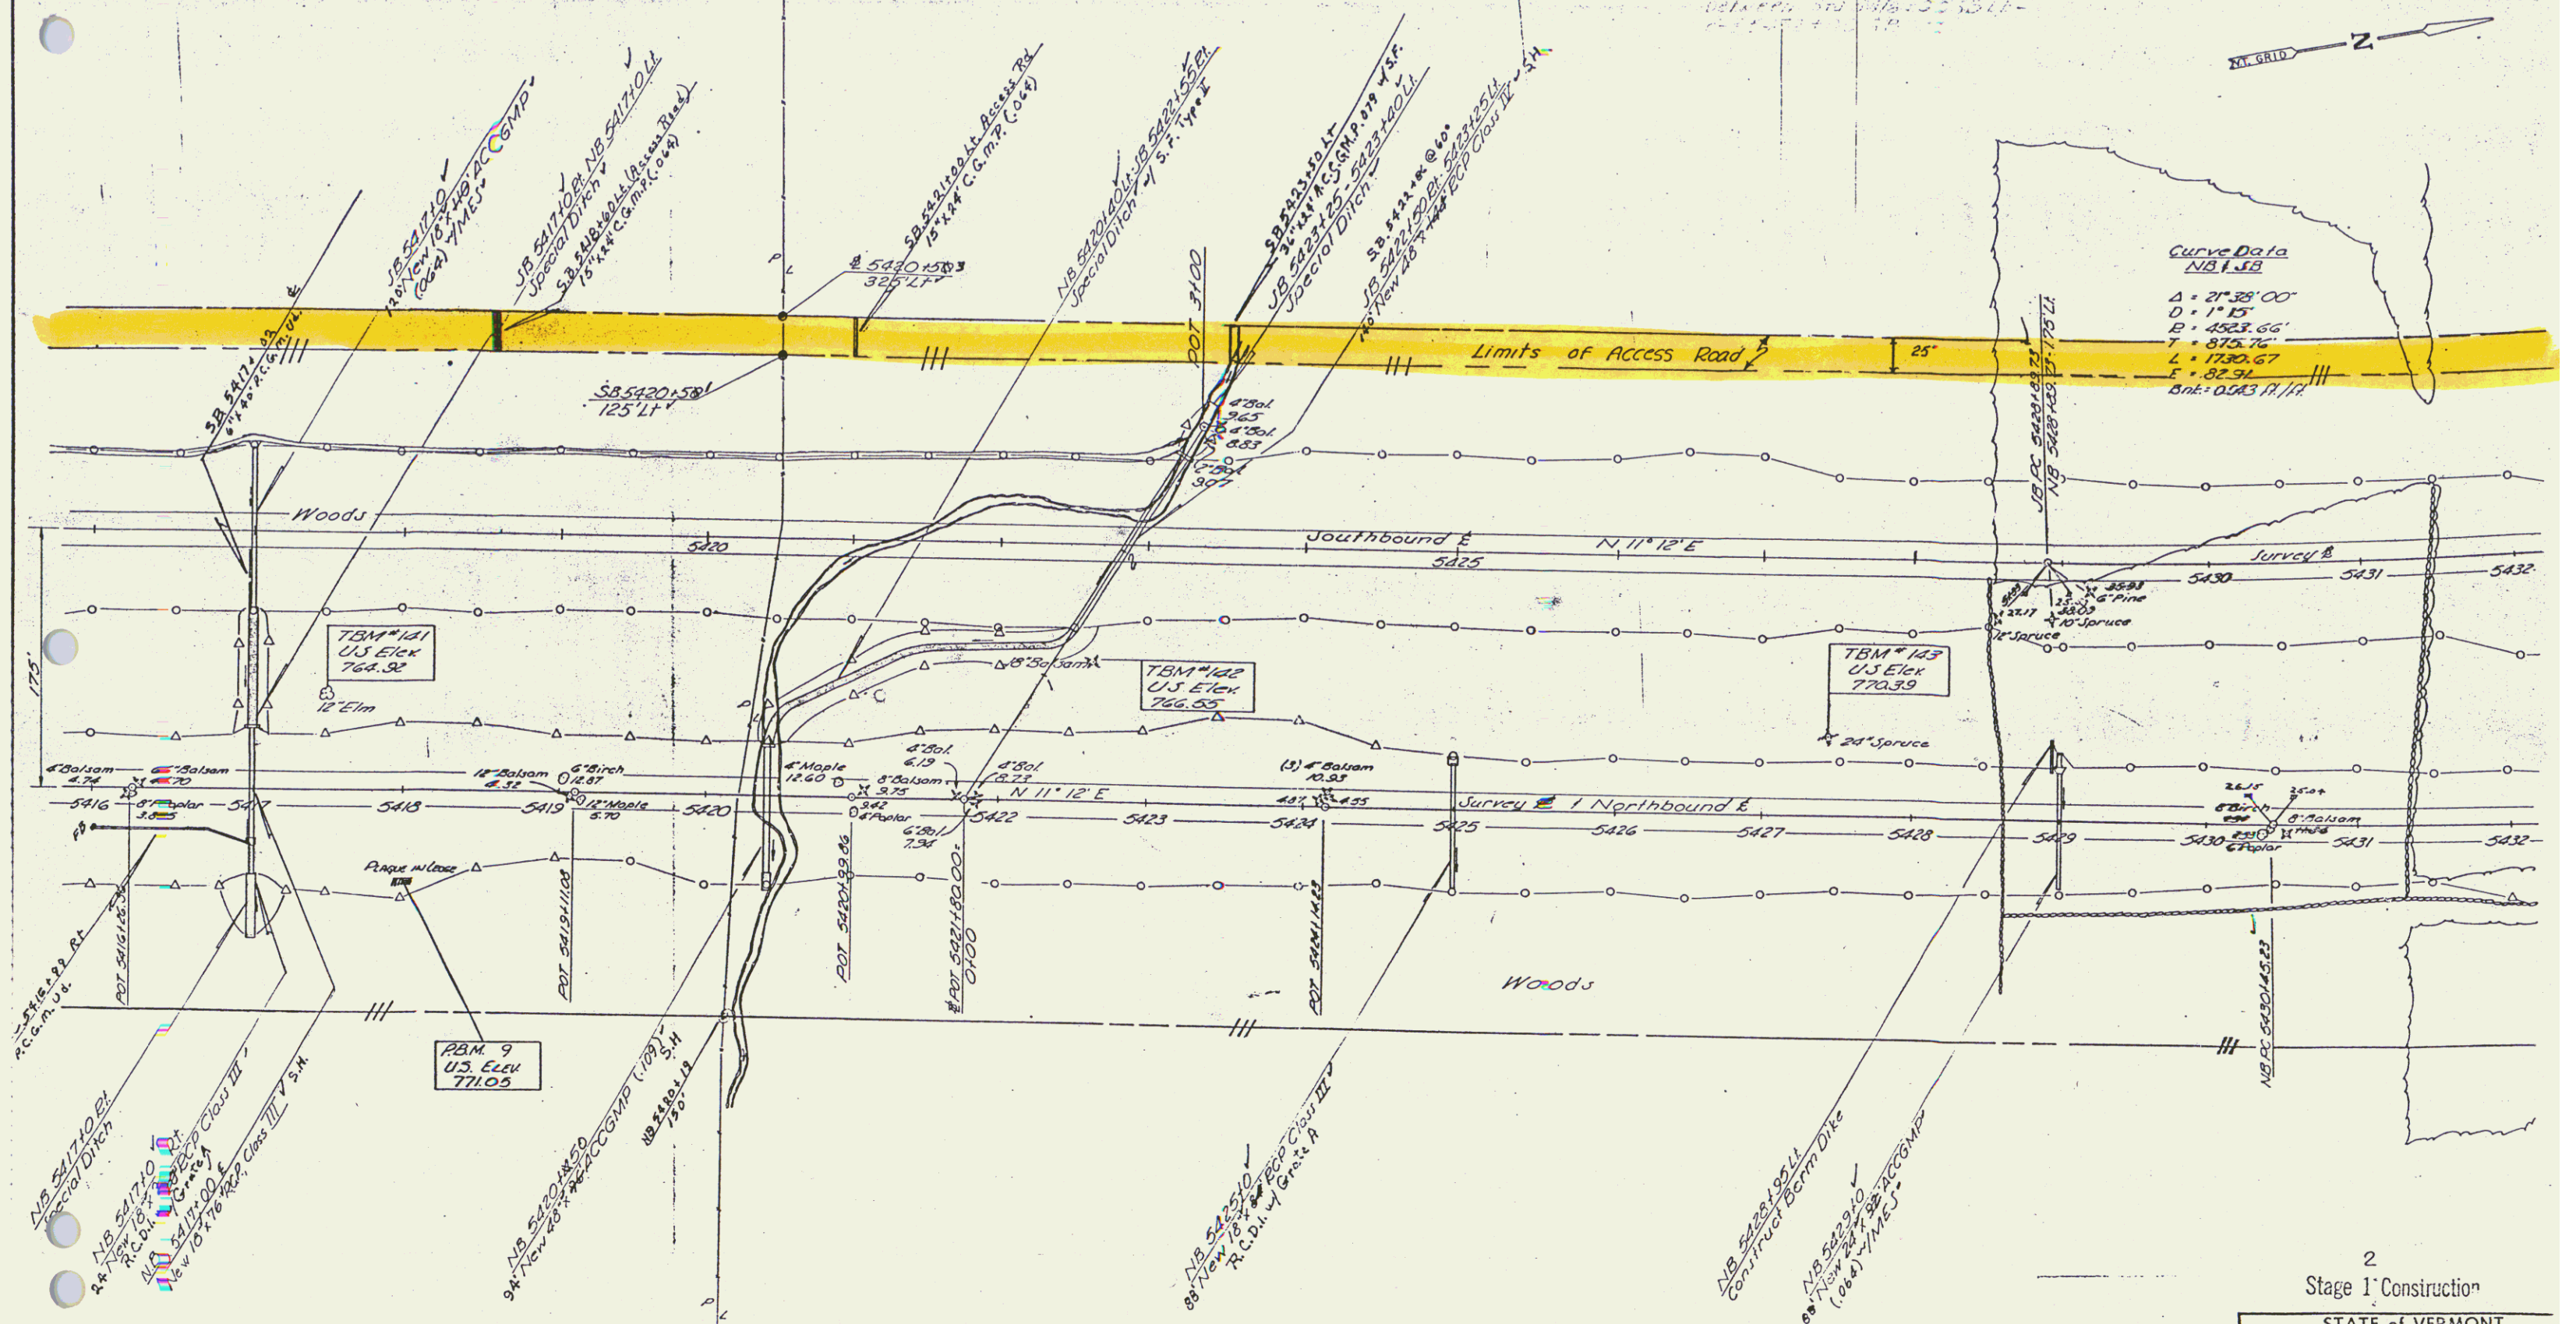

Curve Data
NB 1.5B
Δ = 27°38'00"
D = 11°25'
E = 4523.66'
L = 875.76'
T = 1730.67'
Bt = 82.31'
Bt = 0.043 1/12

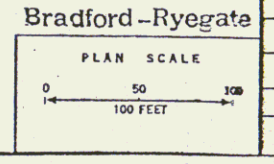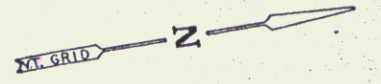

2 Stage 1 Construction	
STATE of VERMONT DEPARTMENT of HIGHWAYS	
BRADFORD-RYEGATE	
McFARLAND-JOHNSON CONSULTING ENGINEERS	
DESIGNED BY: T. J. S.	CHECKED BY: D.E.W.
TRACED BY: E. F.	DATE: 3-15-67
PROJECT No: 1-91-2(11)	SHEET 38 OF 34
CONTRACT No: 2	26

Control of Access
Complete on this sheet

Row/const 104