


Drilling and Blasting of
Solid Rock Subgrade
SB 5449+60 - 5451+10
SB 5458+75 - 5461+75
NB 5462+30 - 5464+0

Woven Wire Fence 4" Steel Posts
NB 5448+00 - 5464+0 Rt.
SB 5448+00 - 5464+0 Lt.

Stone Fill Type I
JB 5458+00 Rt. - NB 5458+0 Lt.
NB 5458+0 Lt.
NB 5458+0 Lt.
NB 5462+0 Rt.

Jute Matting
JB 5463+0 - 5464+0 Lt.
JB 5453+0 - NB 5453+0 Lt.
JB 5462+0 Rt. - NB 5462+0 Lt.

* Guard Rail - Three Cables -
Light Steel Posts -
NB 5448+00 - 5464+0 Rt.

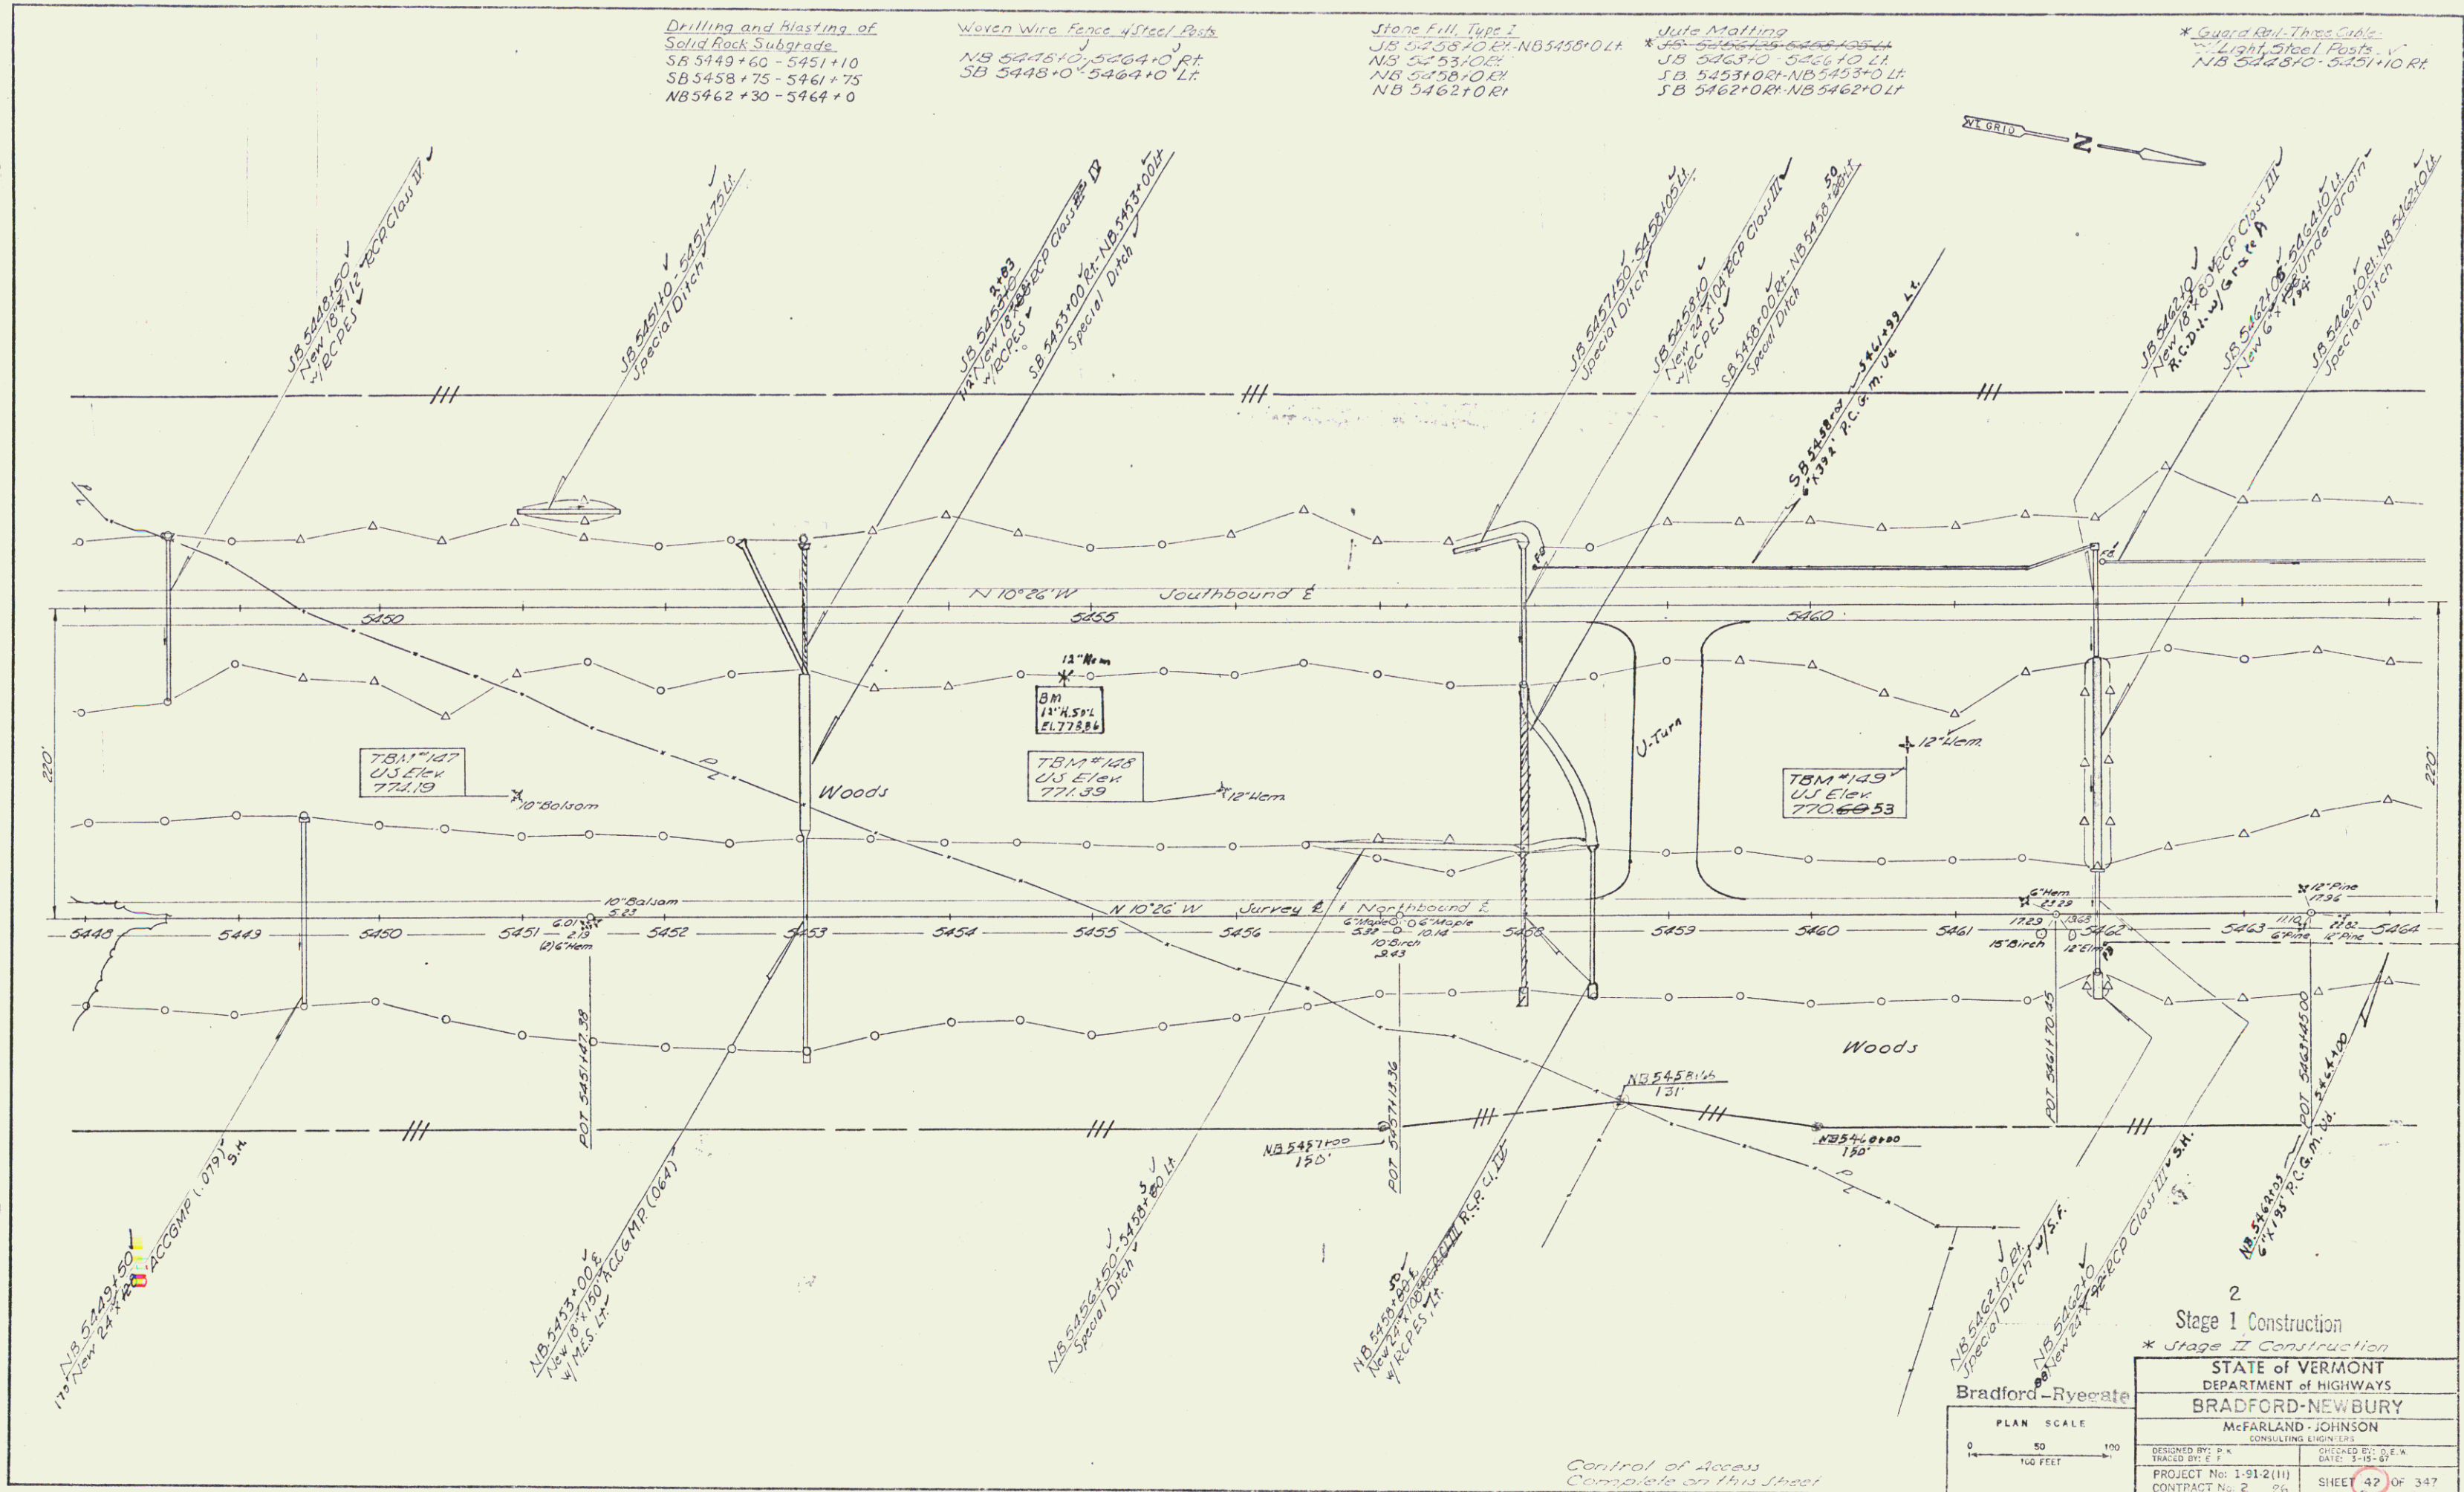

PLAN
NO. 1
DATE: 1-15-61
BY: P. K. TRACY
CHECKED: J. E. H. HARRIS

Bradford-Ryeate
PLAN SCALE
0 50 100
100 FEET

2	
Stage I Construction	
* Stage II Construction	
STATE OF VERMONT DEPARTMENT OF HIGHWAYS BRADFORD-NEWBURY McFARLAND-JOHNSON CONSULTING ENGINEERS	
DESIGNED BY: P. K. TRACY	CHECKED BY: J. E. H. HARRIS
TRACED BY: E. J. HARRIS	DATE: 1-15-61
PROJECT No: 1-91-2(11)	SHEET 42 OF 347
CONTRACT No: 2	

Control of Access
Complete on this Street

R.O.W/const 107