


Drilling and Blasting of
Solid Rock Subgrade
NB 5495+0 - 5504+75
SB 5495+0 - 5502+80


Sand Borrow
SB 5503+00 - 5507+00
NB 5507+50 - 5507+00

Given Wire Fence
Wire Posts
NB 5495+0 - 5507+0
JB 5495+0 - 5507+0

Jobs Marking
NB 5502+75 - 5505+0 LHK
NB 5505+02 - 5507+0 LHK
NB 5505+02 - 5507+0 LHK

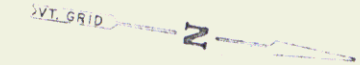

Jobs Marking
NB 5495+0 - 5496+90 AT
NB 5497+00 - 5497+90 AT
SB 5495+0 - 5497+90 AT
SB 5495+0 - 5497+90 AT
NB 5495+0 - 5501+15 AT
NB 5495+0 - 5501+15 AT
NB 5502+75 - 5505+0 AT
NB 5497+02 - 5501+0 AT

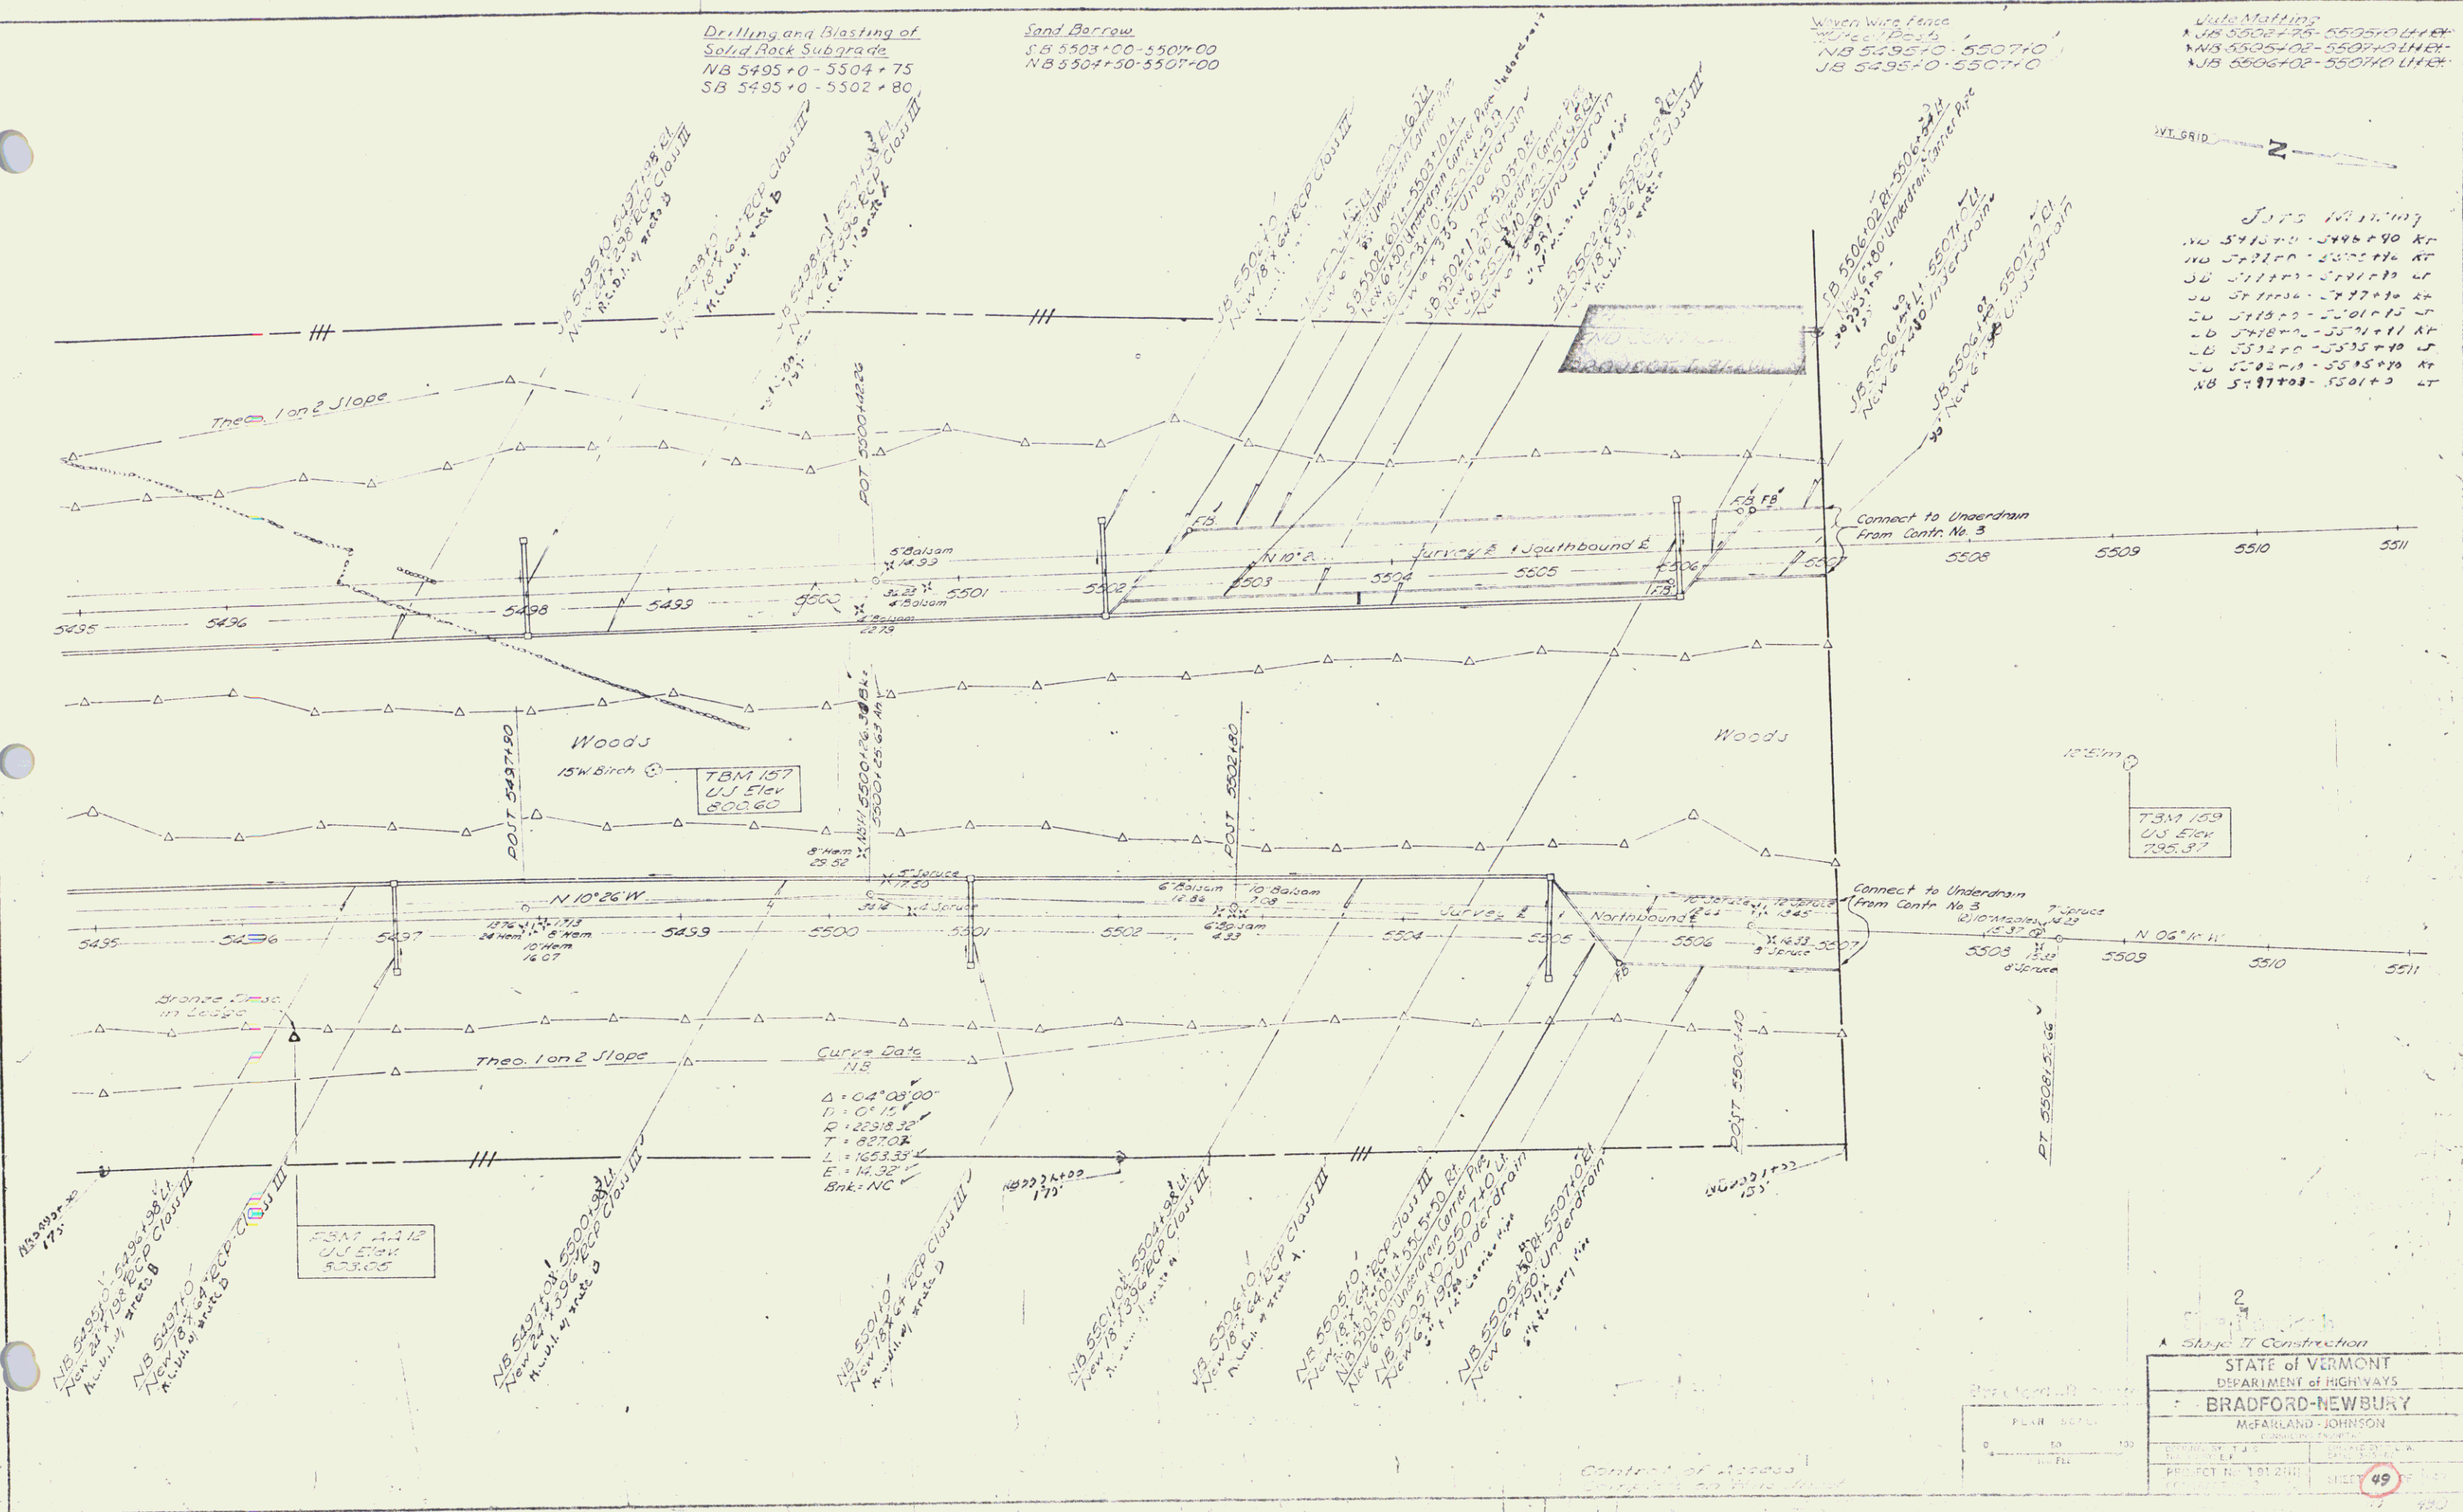

STATE OF VERMONT	
DEPARTMENT OF HIGHWAYS	
BRADFORD-NEWBURY	
McFARLAND-JOHNSON	
PROJECT NO. 101200	49

Raw/const 110