


Drilling & Blasting of Solid Rock Subgrade
 S-B 5507+00 - 5507+25 --

Send Barrow
 SB 5507+00 - 5510+00 -
 NB 5507+00 - 5508+00 --

Woven Wire Fence with Steel Posts
 NB 5507+00 - 5511+00 -
 SB 5507+00 - 5511+00 -

Auto-Matting
 NB 5507+00 - 5511+00 -
 SB 5507+00 - 5511+00 -

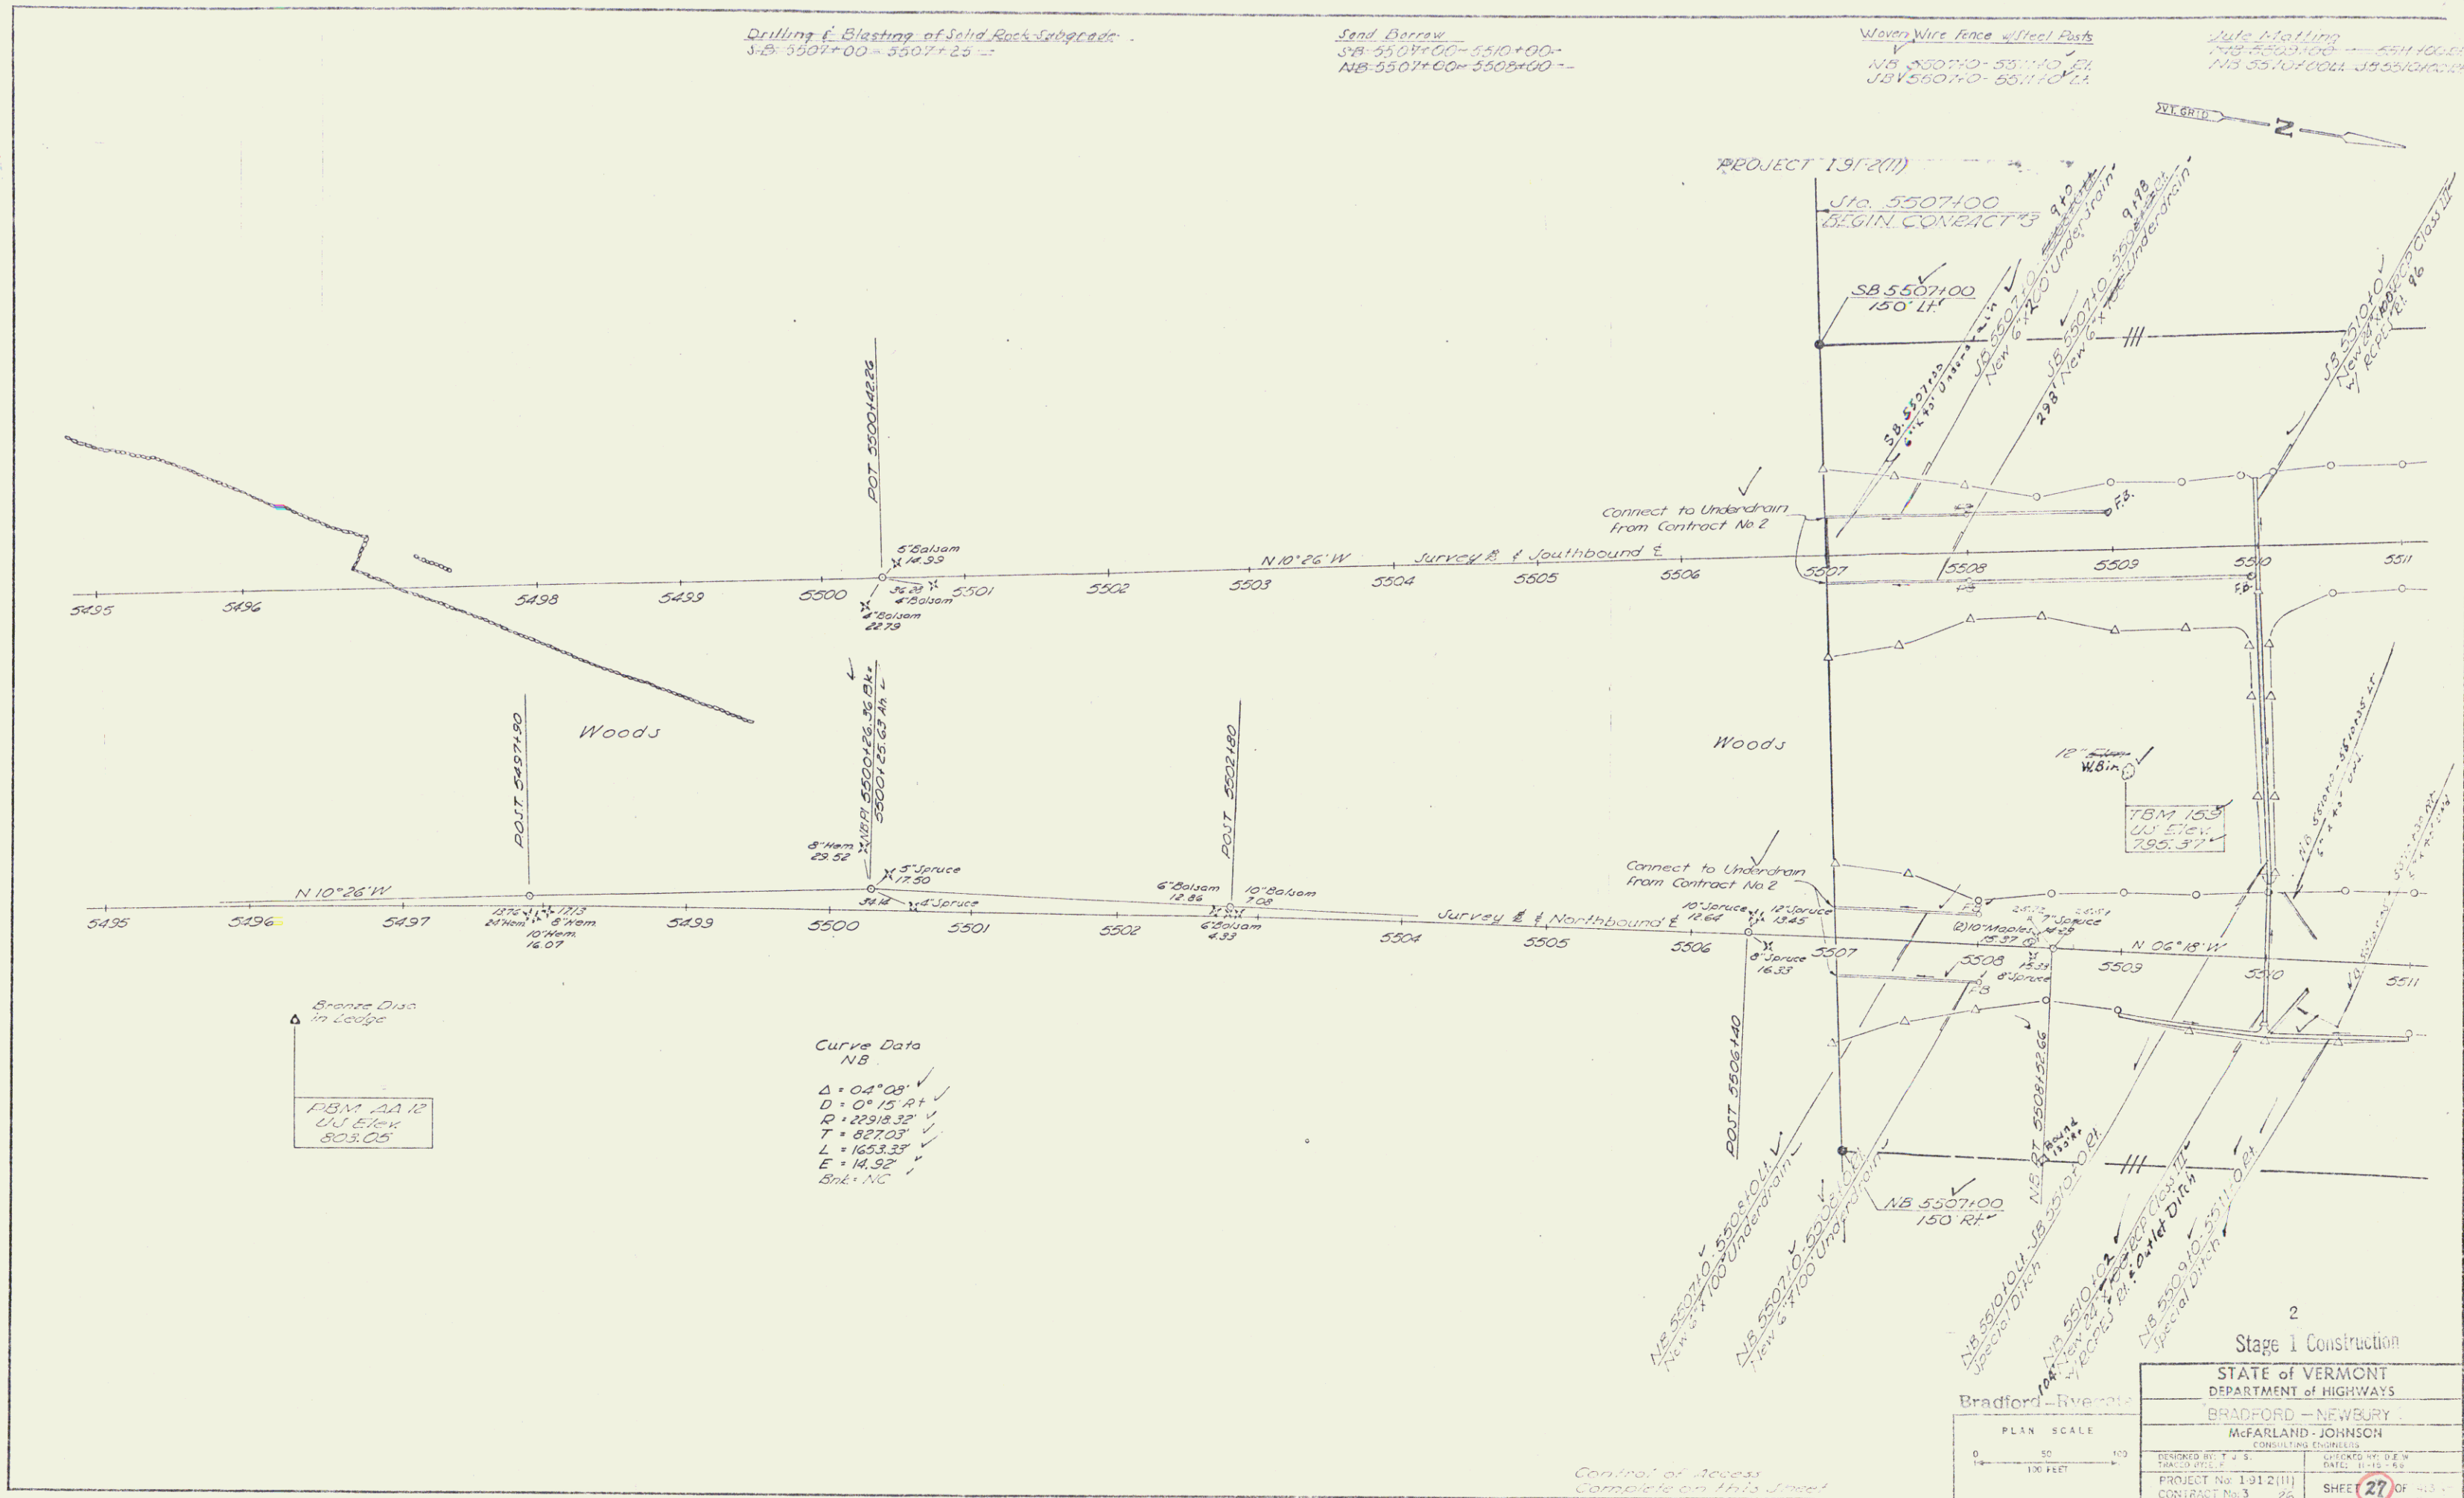

Bench Data
 in Ledger
 B.M. AA.12
 U.S. Elev.
 803.05'

Curve Data
 NB
 Δ = 04° 08' ✓
 D = 0° 15' RT ✓
 R = 22518.32' ✓
 T = 827.03' ✓
 L = 1633.25' ✓
 E = 14.92' ✓
 Bk. = NC ✓

2
 Stage 1 Construction

STATE of VERMONT
 DEPARTMENT of HIGHWAYS
 BRADFORD - NEWBURY
 McFARLAND - JOHNSON
 CONSULTING ENGINEERS

BRADFORD - NEWBURY
 PLAN SCALE
 0 50 100
 1" = 50 FEET

PROJECT No. 1-912(11)
 CONTRACT No. 3
 SHEET 27 OF 28

Control of Access
 Complete on this sheet

R.O.W/const 112