


PLAN
 NOTE: SEE SHEET 114 FOR DETAILS OF
 THE BRADFORD RYE ROAD
 PROJECT.

2
 Stage 1 Construction

STATE of VERMONT DEPARTMENT of HIGHWAYS BRADFORD - RYE ROAD	
McFARLAND - JOHNSON CIVIL ENGINEERS	
DESIGNED BY: T. S. FRENCH, P.E.	DRAWN BY: J. S. W. BROWN, P.E.
PROJECT No: 1-91-2(11)	SHEET 31 OF 31
CONTRACT No: 3	25

125 450

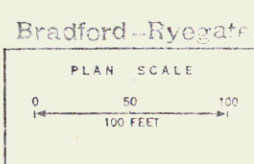

Control of Access
 Complete on this sheet

R.O.W/const, 114