


PLAN  
 DATE  
 DRAWN BY  
 CHECKED BY  
 NO.

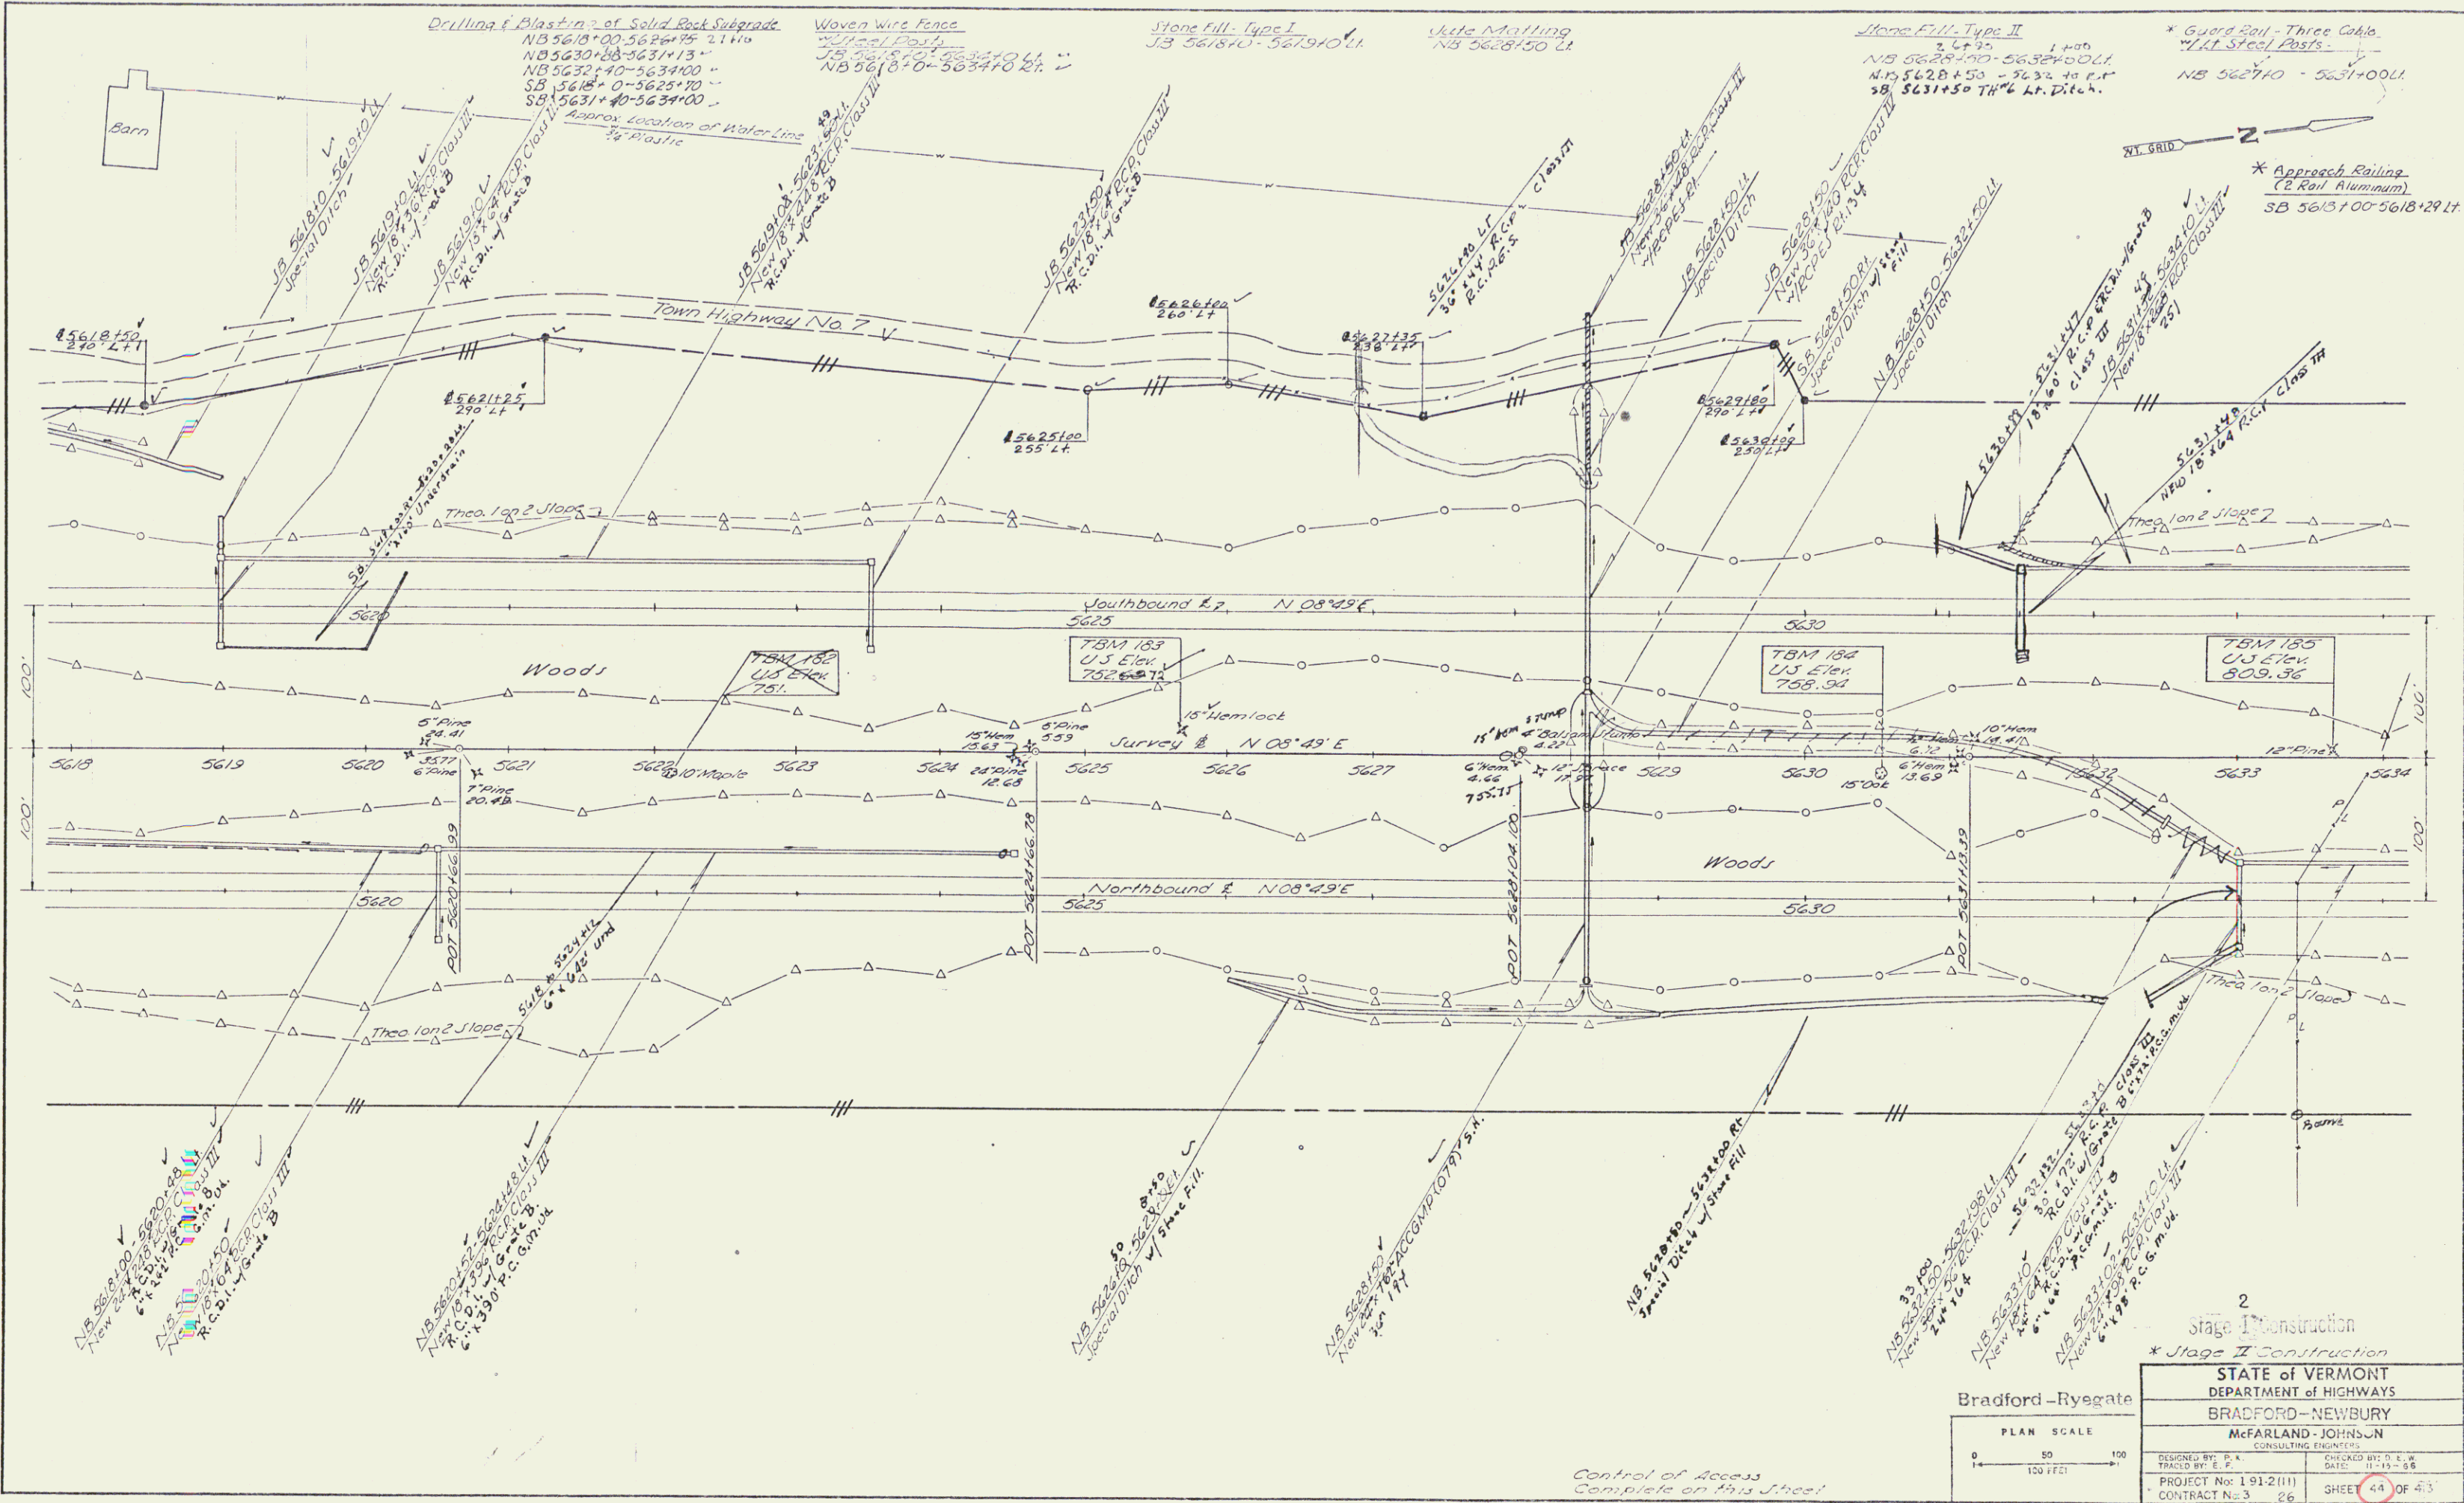

Bradford-Ryegate  
 PLAN SCALE  
 0 50 100  
 1" = 100 FT

2  
 Stage I Construction  
 \* Stage II Construction

STATE OF VERMONT DEPARTMENT OF HIGHWAYS	
BRADFORD-NEWBURY	
McFARLAND-JOHNSON CONSULTING ENGINEERS	
DESIGNED BY: P. A. FRASER	CHECKED BY: S. L. W.
PROJECT No: 191-2(11)	DATE: 11-19-58
CONTRACT No: 3 26	SHEET 44 OF 43

Control of Access  
 Complete on this Sheet

Row/const 120