
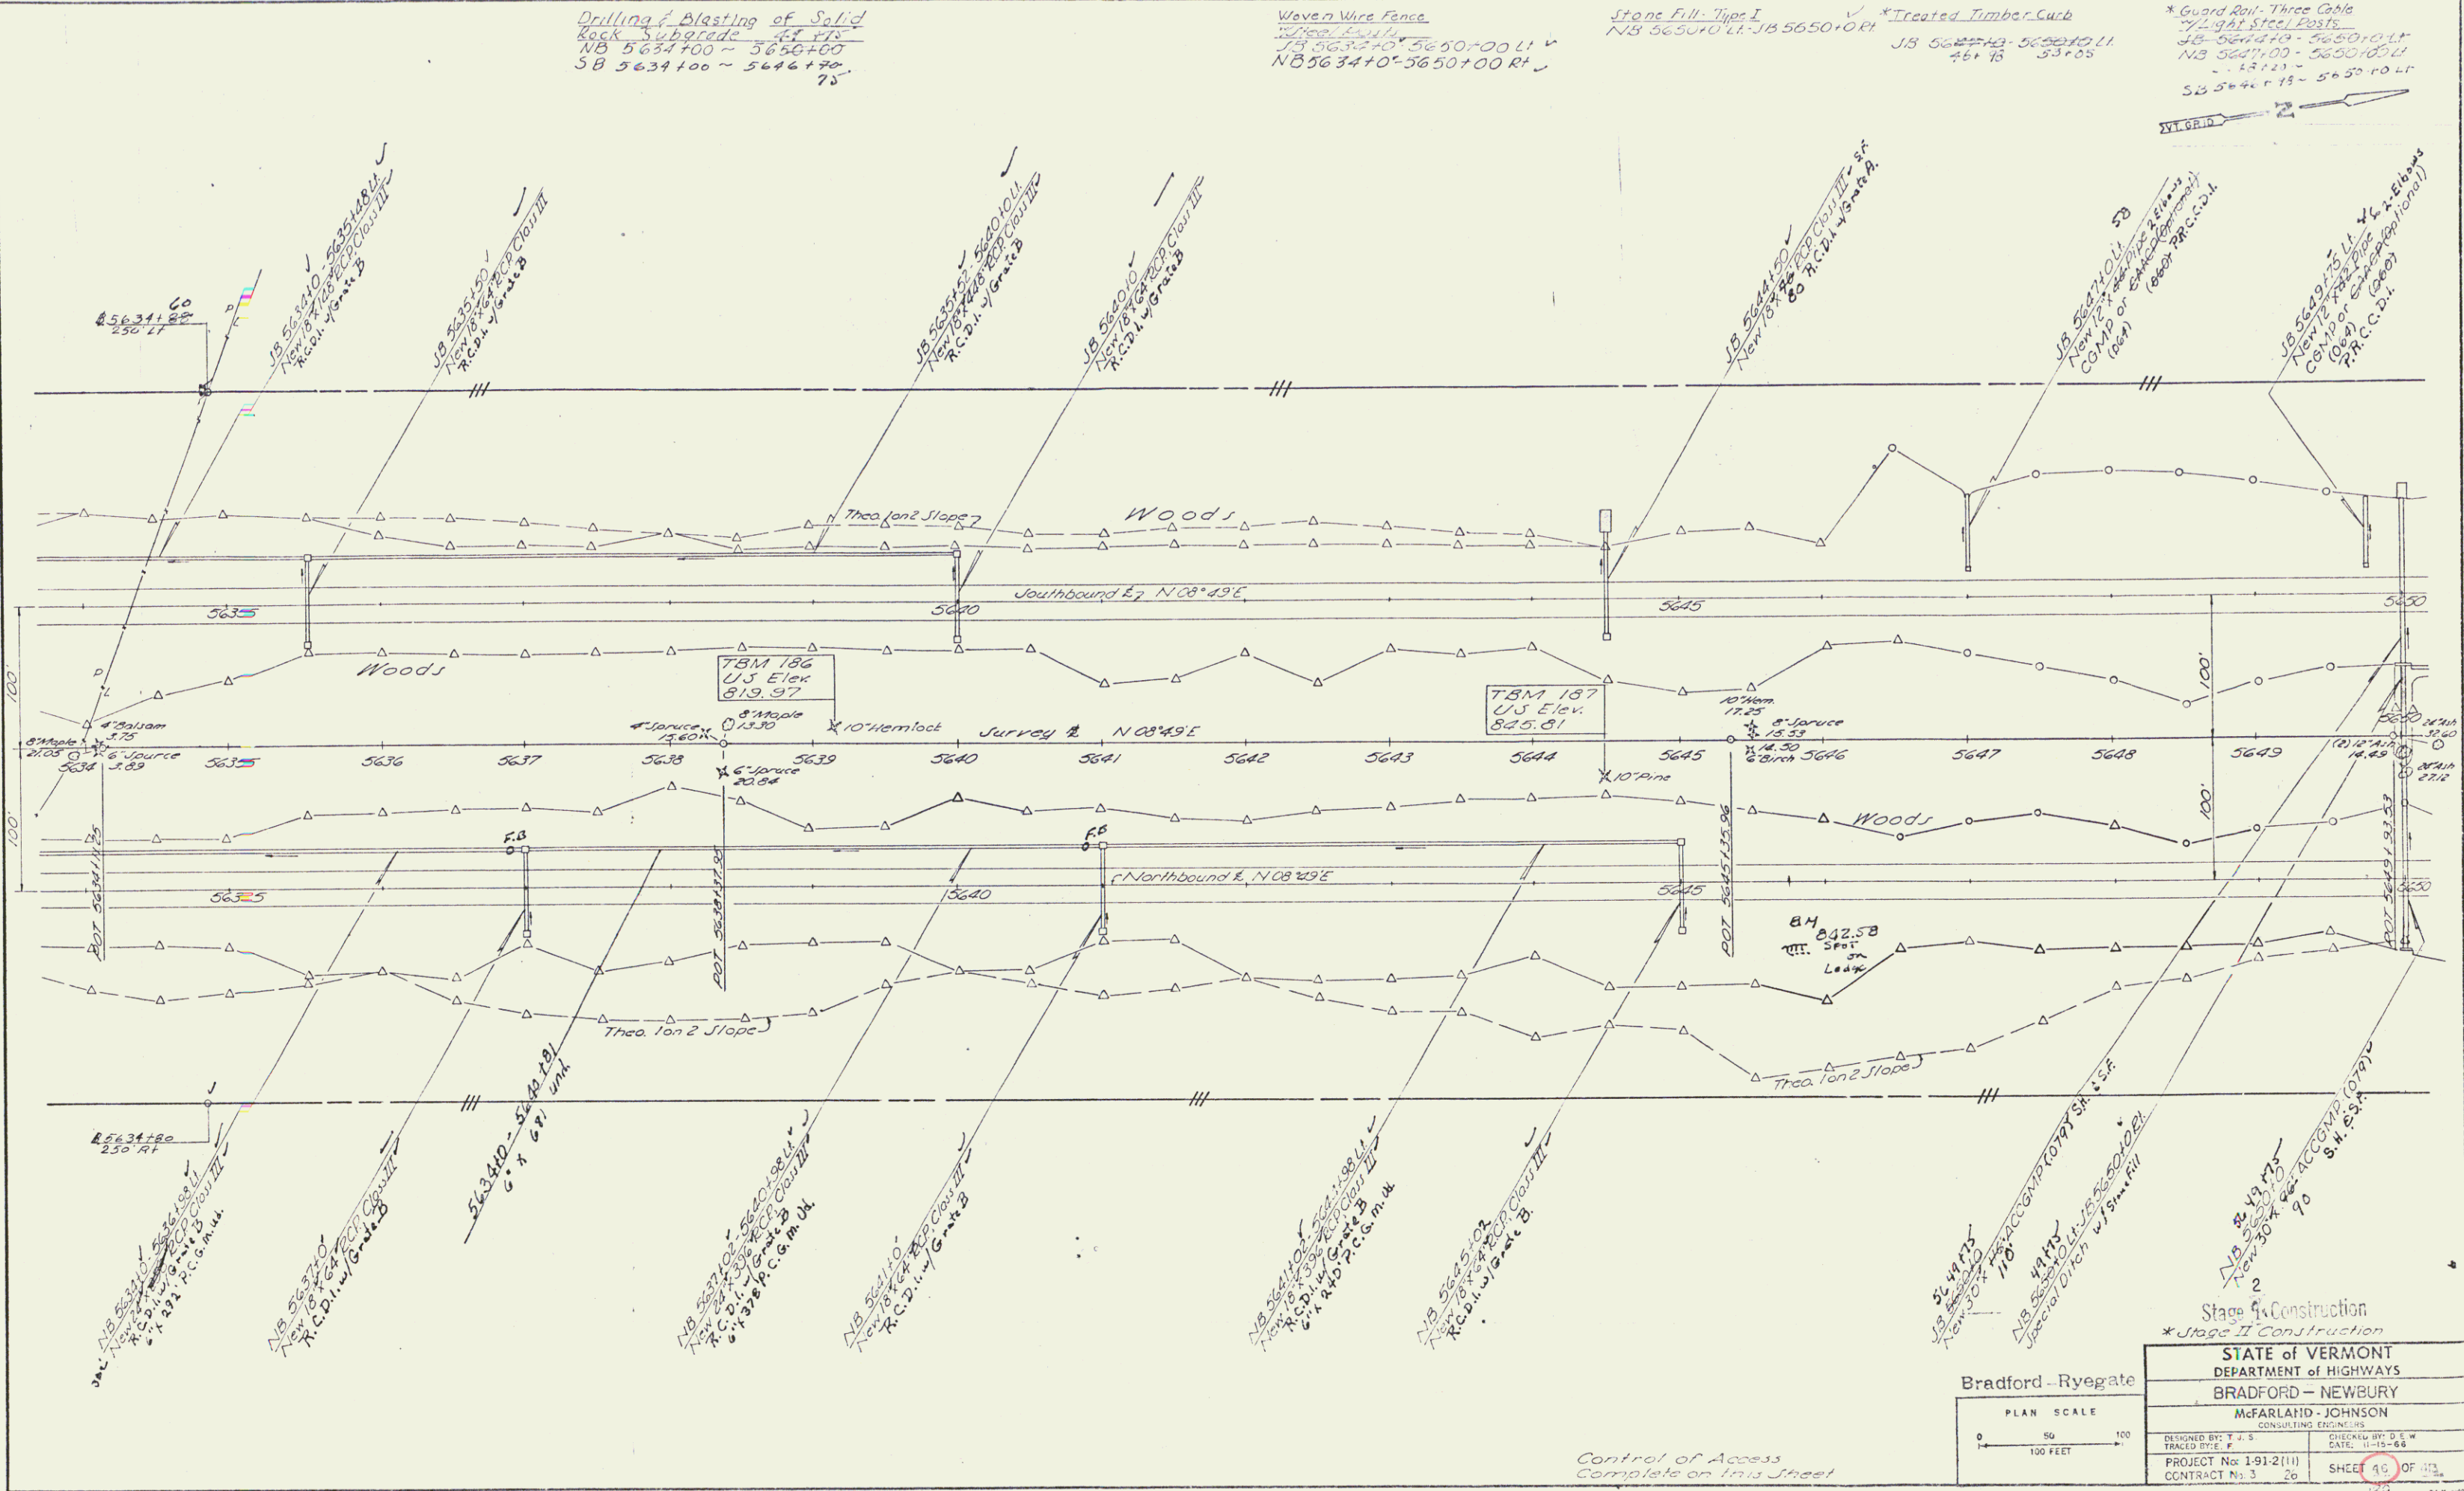


Drilling & Blasting of Solid
Rock Subgrade at r/s
NB 5634+00 - 5650+00
SB 5634+00 - 5646+70
75


Woven Wire Fence
Top of Earth
SB 5634+00 - 5650+00 LI
NB 5634+00 - 5650+00 RT

Stone Fill - Type I
NB 5650+00 LI - JB 5650+00 RT
JB 5650+00 - 5650+00 LI
46+70 53+05

*Treated Timber Curb
*Guard Rail - Three Cable
42" x 42" Steel Posts
JB 5644+00 - 5650+00 LI
NB 5647+00 - 5650+00 LI
- 42+25 -
SB 5644+00 - 5650+00 RT

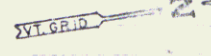

PLAN	DATE	BY
REVISED		
NOTE BOOK		
FILED		
NO.		

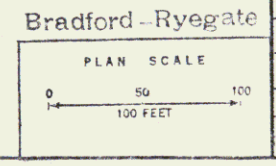

Stage I Construction	
*Stage II Construction	
STATE of VERMONT DEPARTMENT of HIGHWAYS BRADFORD - NEWBURY	
McFARLAND - JOHNSON CONSULTING ENGINEERS	
DESIGNED BY: T. J. S.	CHECKED BY: D. E. W.
DRAWN BY: F. E.	DATE: 10-18-68
PROJECT No: 1-91-2(11)	SHEET 16 OF 17
CONTRACT No: 3	20

Control of Access
Complete on This Street

R.O.W / Const 121