


PLAN
 DATE
 DRAWN BY
 CHECKED BY
 NO. OF SHEETS
 SHEET NO.

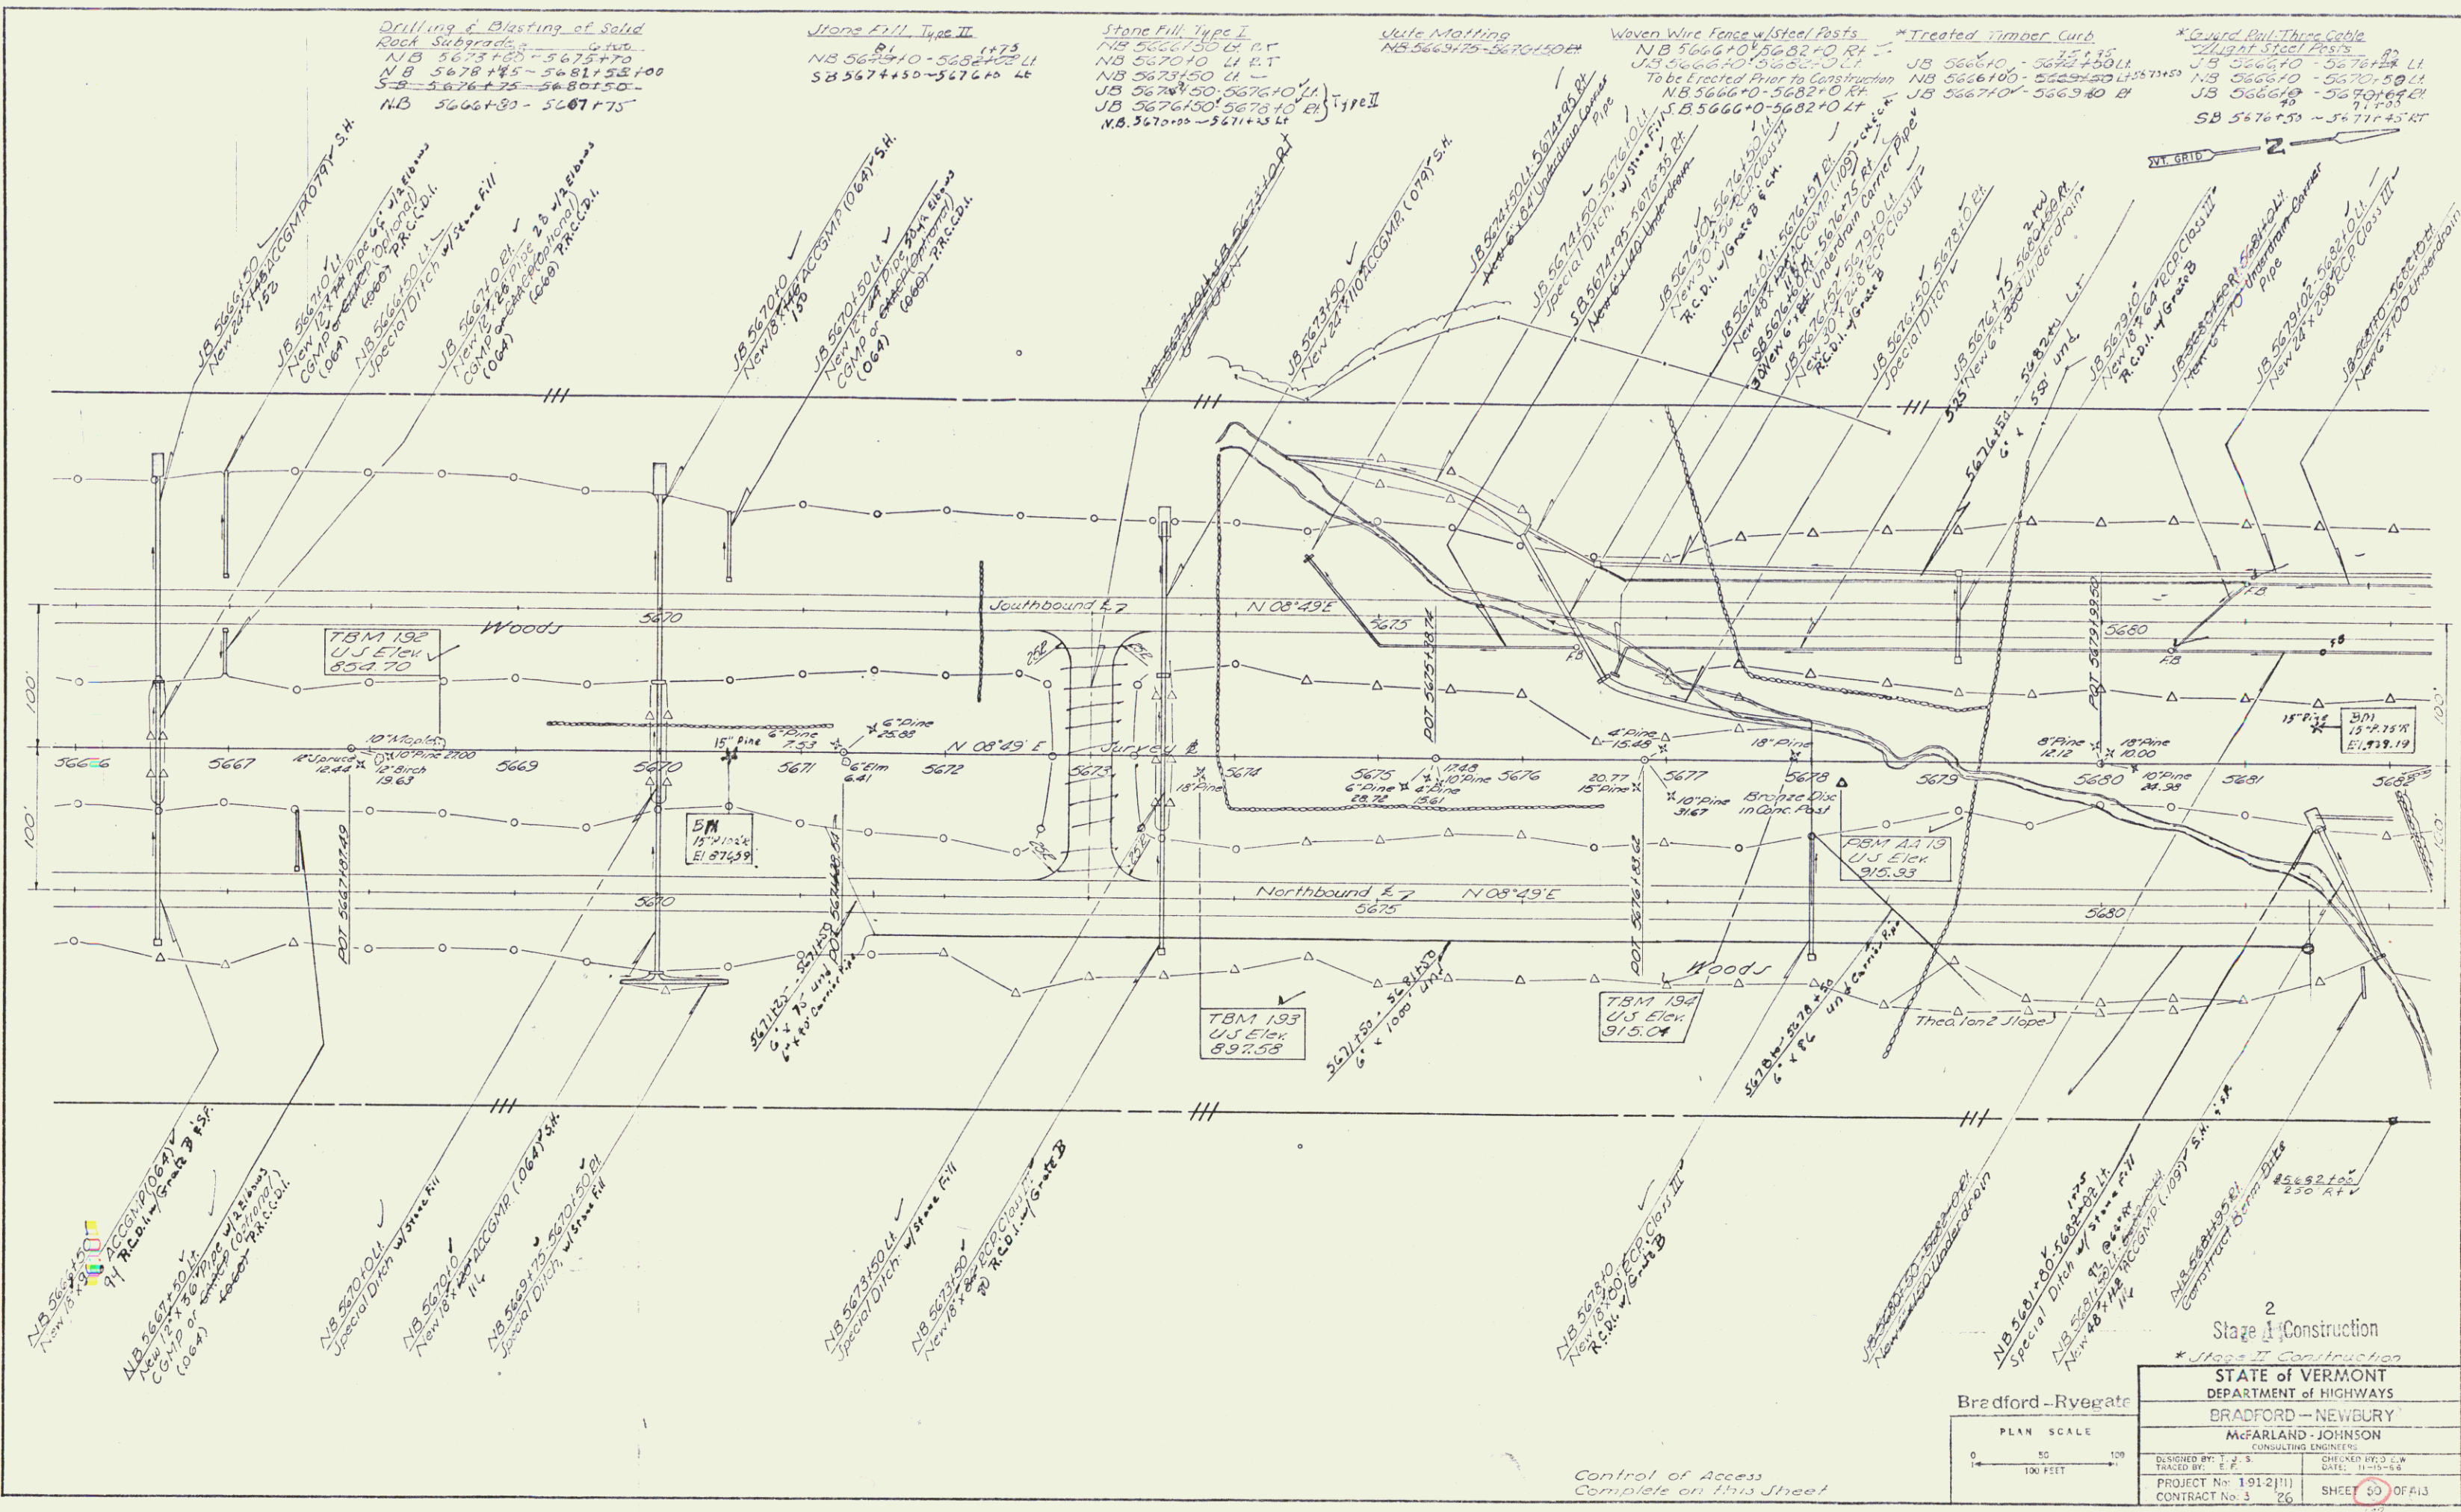

Drilling & Blasting of Solid Rock Subgrade
 NB 5673+00 - 5675+70
 NB 5676+75 - 5681+00
 NB 5666+30 - 5667+75

Stone Fill Type II
 NB 5674+00 - 5675+00 LI
 NB 5674+50 - 5676+00 LI

Stone Fill Type I
 NB 5674+00 - 5675+00 LI
 NB 5674+50 - 5676+00 LI
 NB 5676+00 - 5677+00 LI

Wedge Matting
 NB 5669+75 - 5670+50

Woven Wire Fence w/ Steel Posts
 NB 5666+00 - 5682+00 RT
 NB 5666+00 - 5682+00 LT

Treated Timber Curb
 NB 5666+00 - 5682+00 RT
 NB 5666+00 - 5682+00 LT

Guard Rail Three Cable
 NB 5666+00 - 5682+00 RT
 NB 5666+00 - 5682+00 LT

Bredford - Ryegate
 PLAN SCALE
 0 50 100
 1" = 50 FT

2
 Stage I Construction
 * Stage II Construction
 STATE OF VERMONT
 DEPARTMENT OF HIGHWAYS
 BRADFORD - NEWBURY
 McFARLAND - JOHNSON
 CONSULTING ENGINEERS
 ISSUED BY: J.P.S. CHECKED BY: J.P.S.
 TRACED BY: E.P.S. DATE: 11-15-66
 PROJECT No. 1-91-2(11) SHEET 50 OF 113
 CONTRACT No. 26

Control of Access
 Complete on this sheet

Raw/const 123