


Haven Wire Fence
 N5 5714+0 5715
 JB 5714+0 5715
 To be Erected Prior to C
 SB 5714+0 5720+01

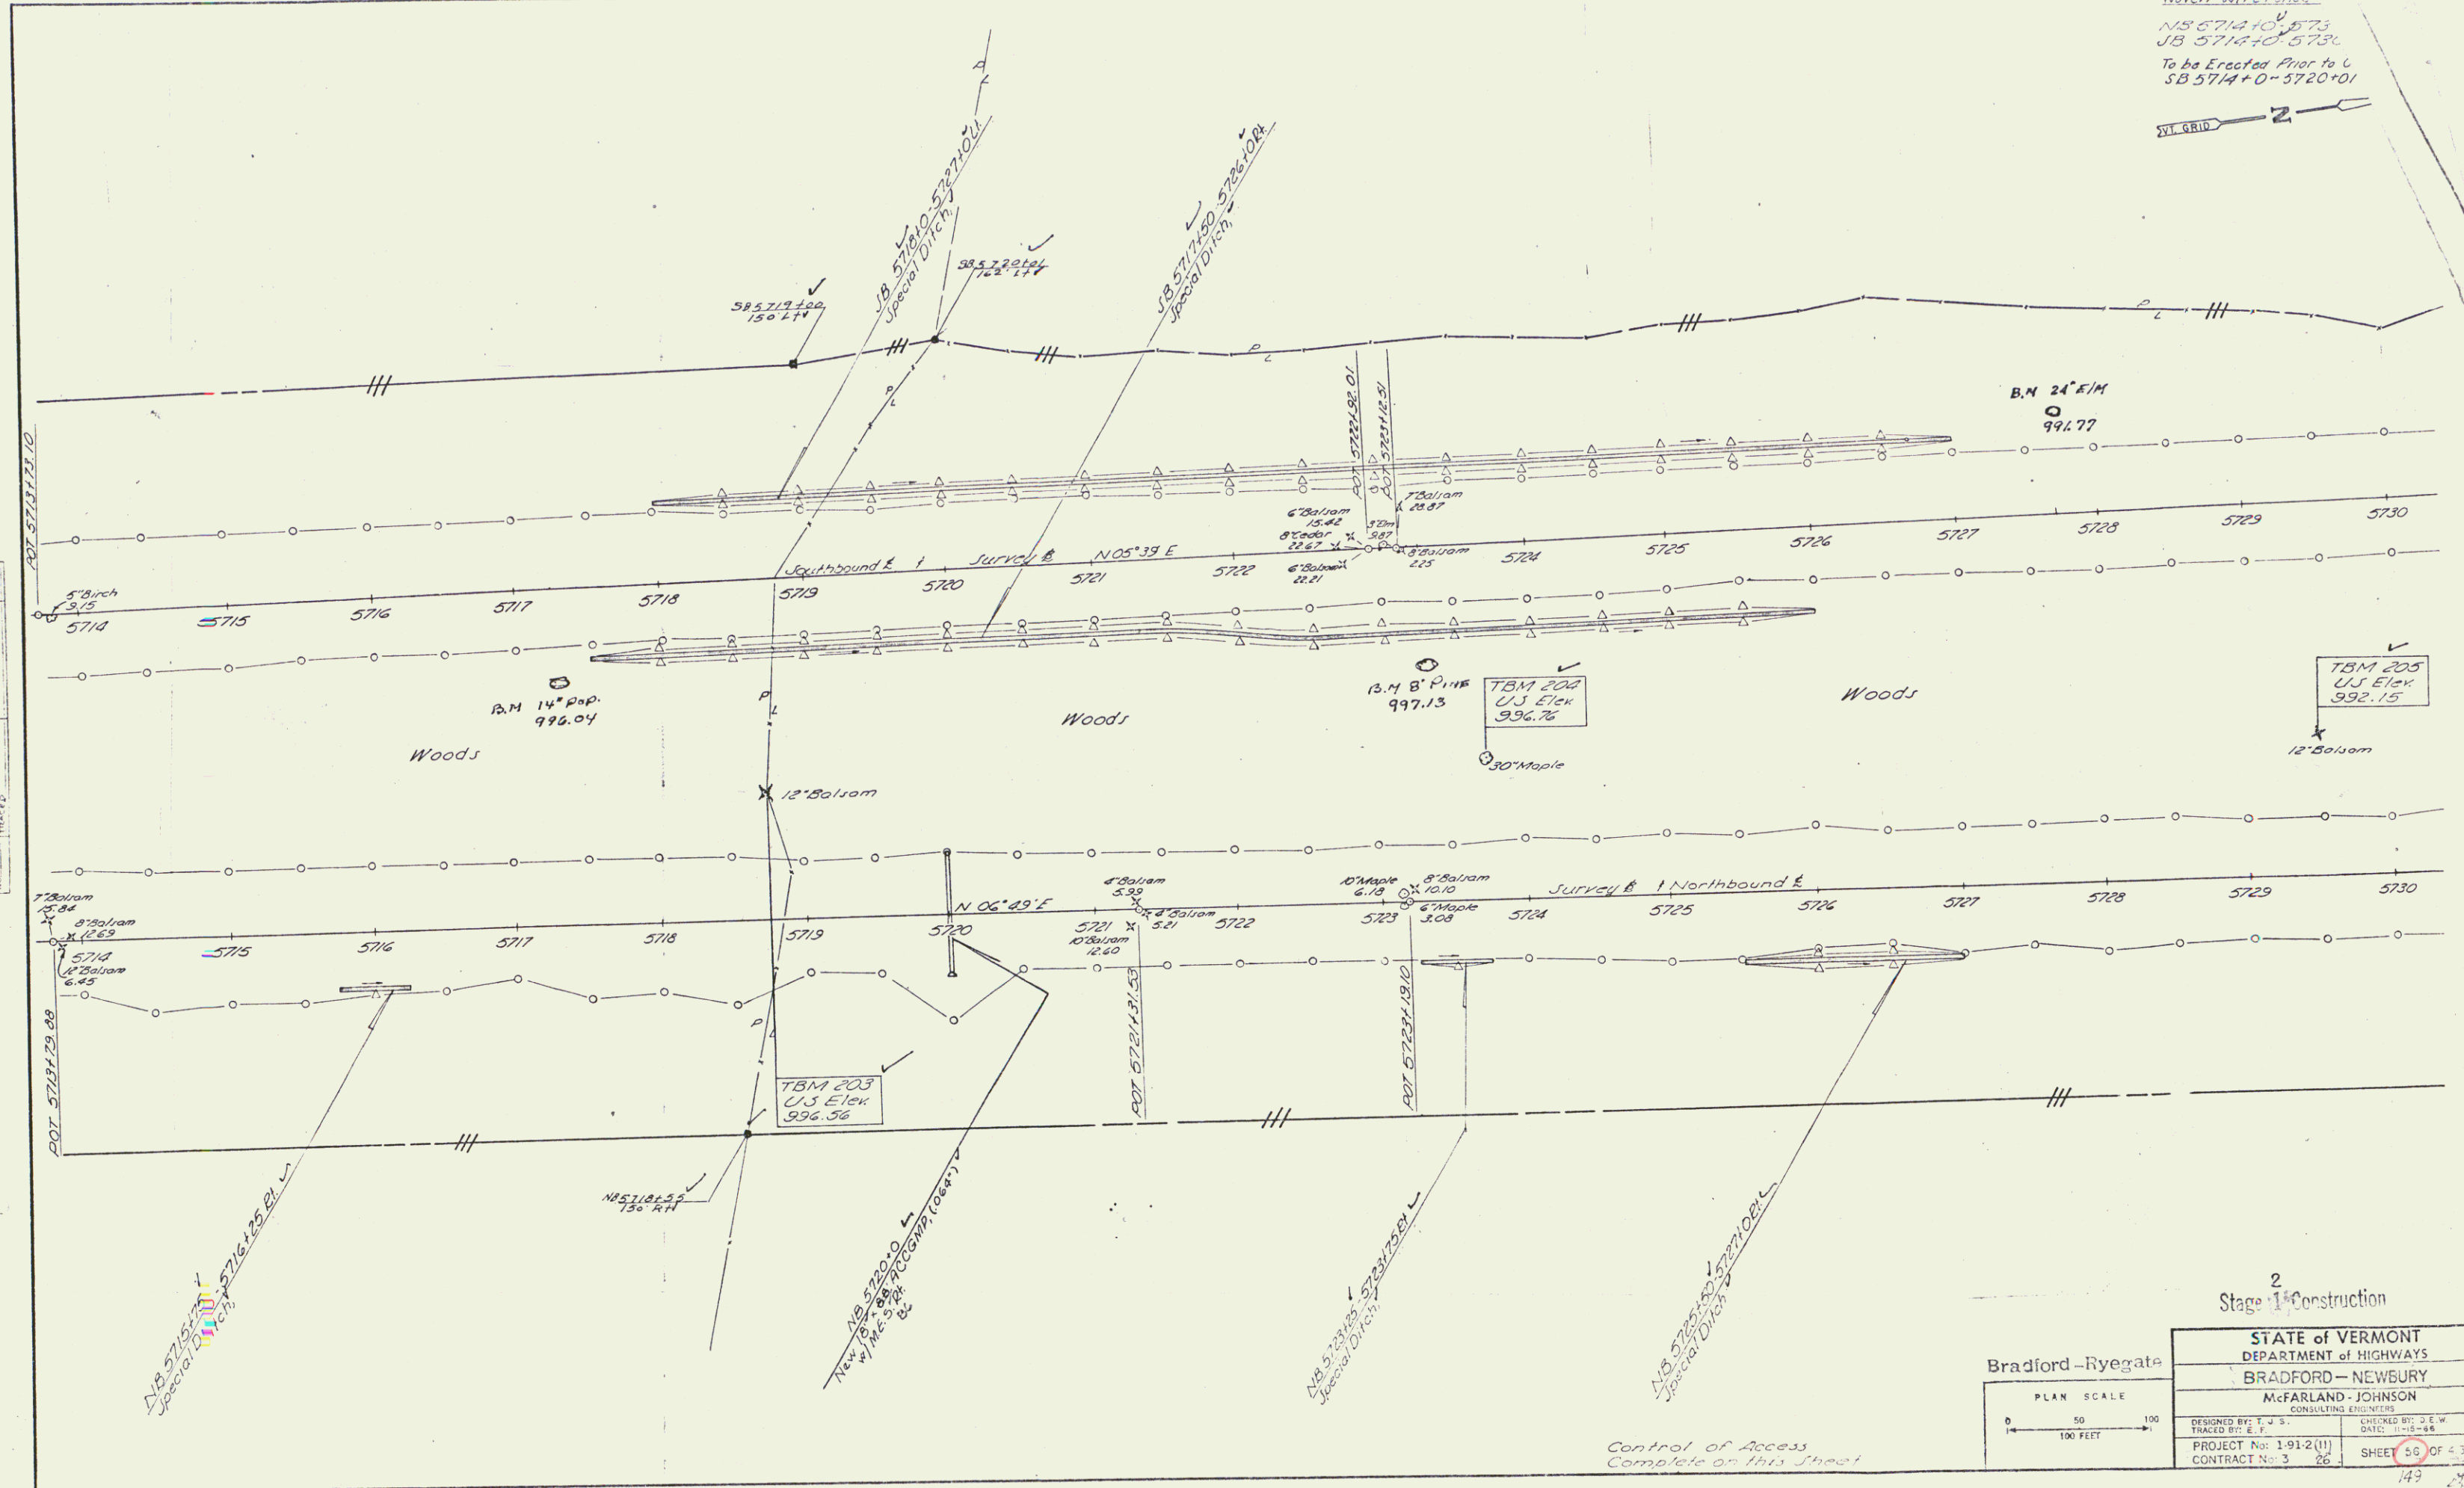

DATE	
BY	
PLAN	
NOTE BOOK	
NO.	

2
 Stage 1st Construction

Bradford-Ryegate

STATE of VERMONT DEPARTMENT of HIGHWAYS	
BRADFORD - NEWBURY	
McFARLAND - JOHNSON CONSULTING ENGINEERS	
DESIGNED BY: E. J. S.	CHECKED BY: J. E. W.
TRACED BY: E. J.	DATE: 11-18-68
PROJECT No: 1-91-2(1)	SHEET 56 OF 43
CONTRACT No: 3 26	

149 126

Control of Access
 Complete on this Street

Row/const 126