
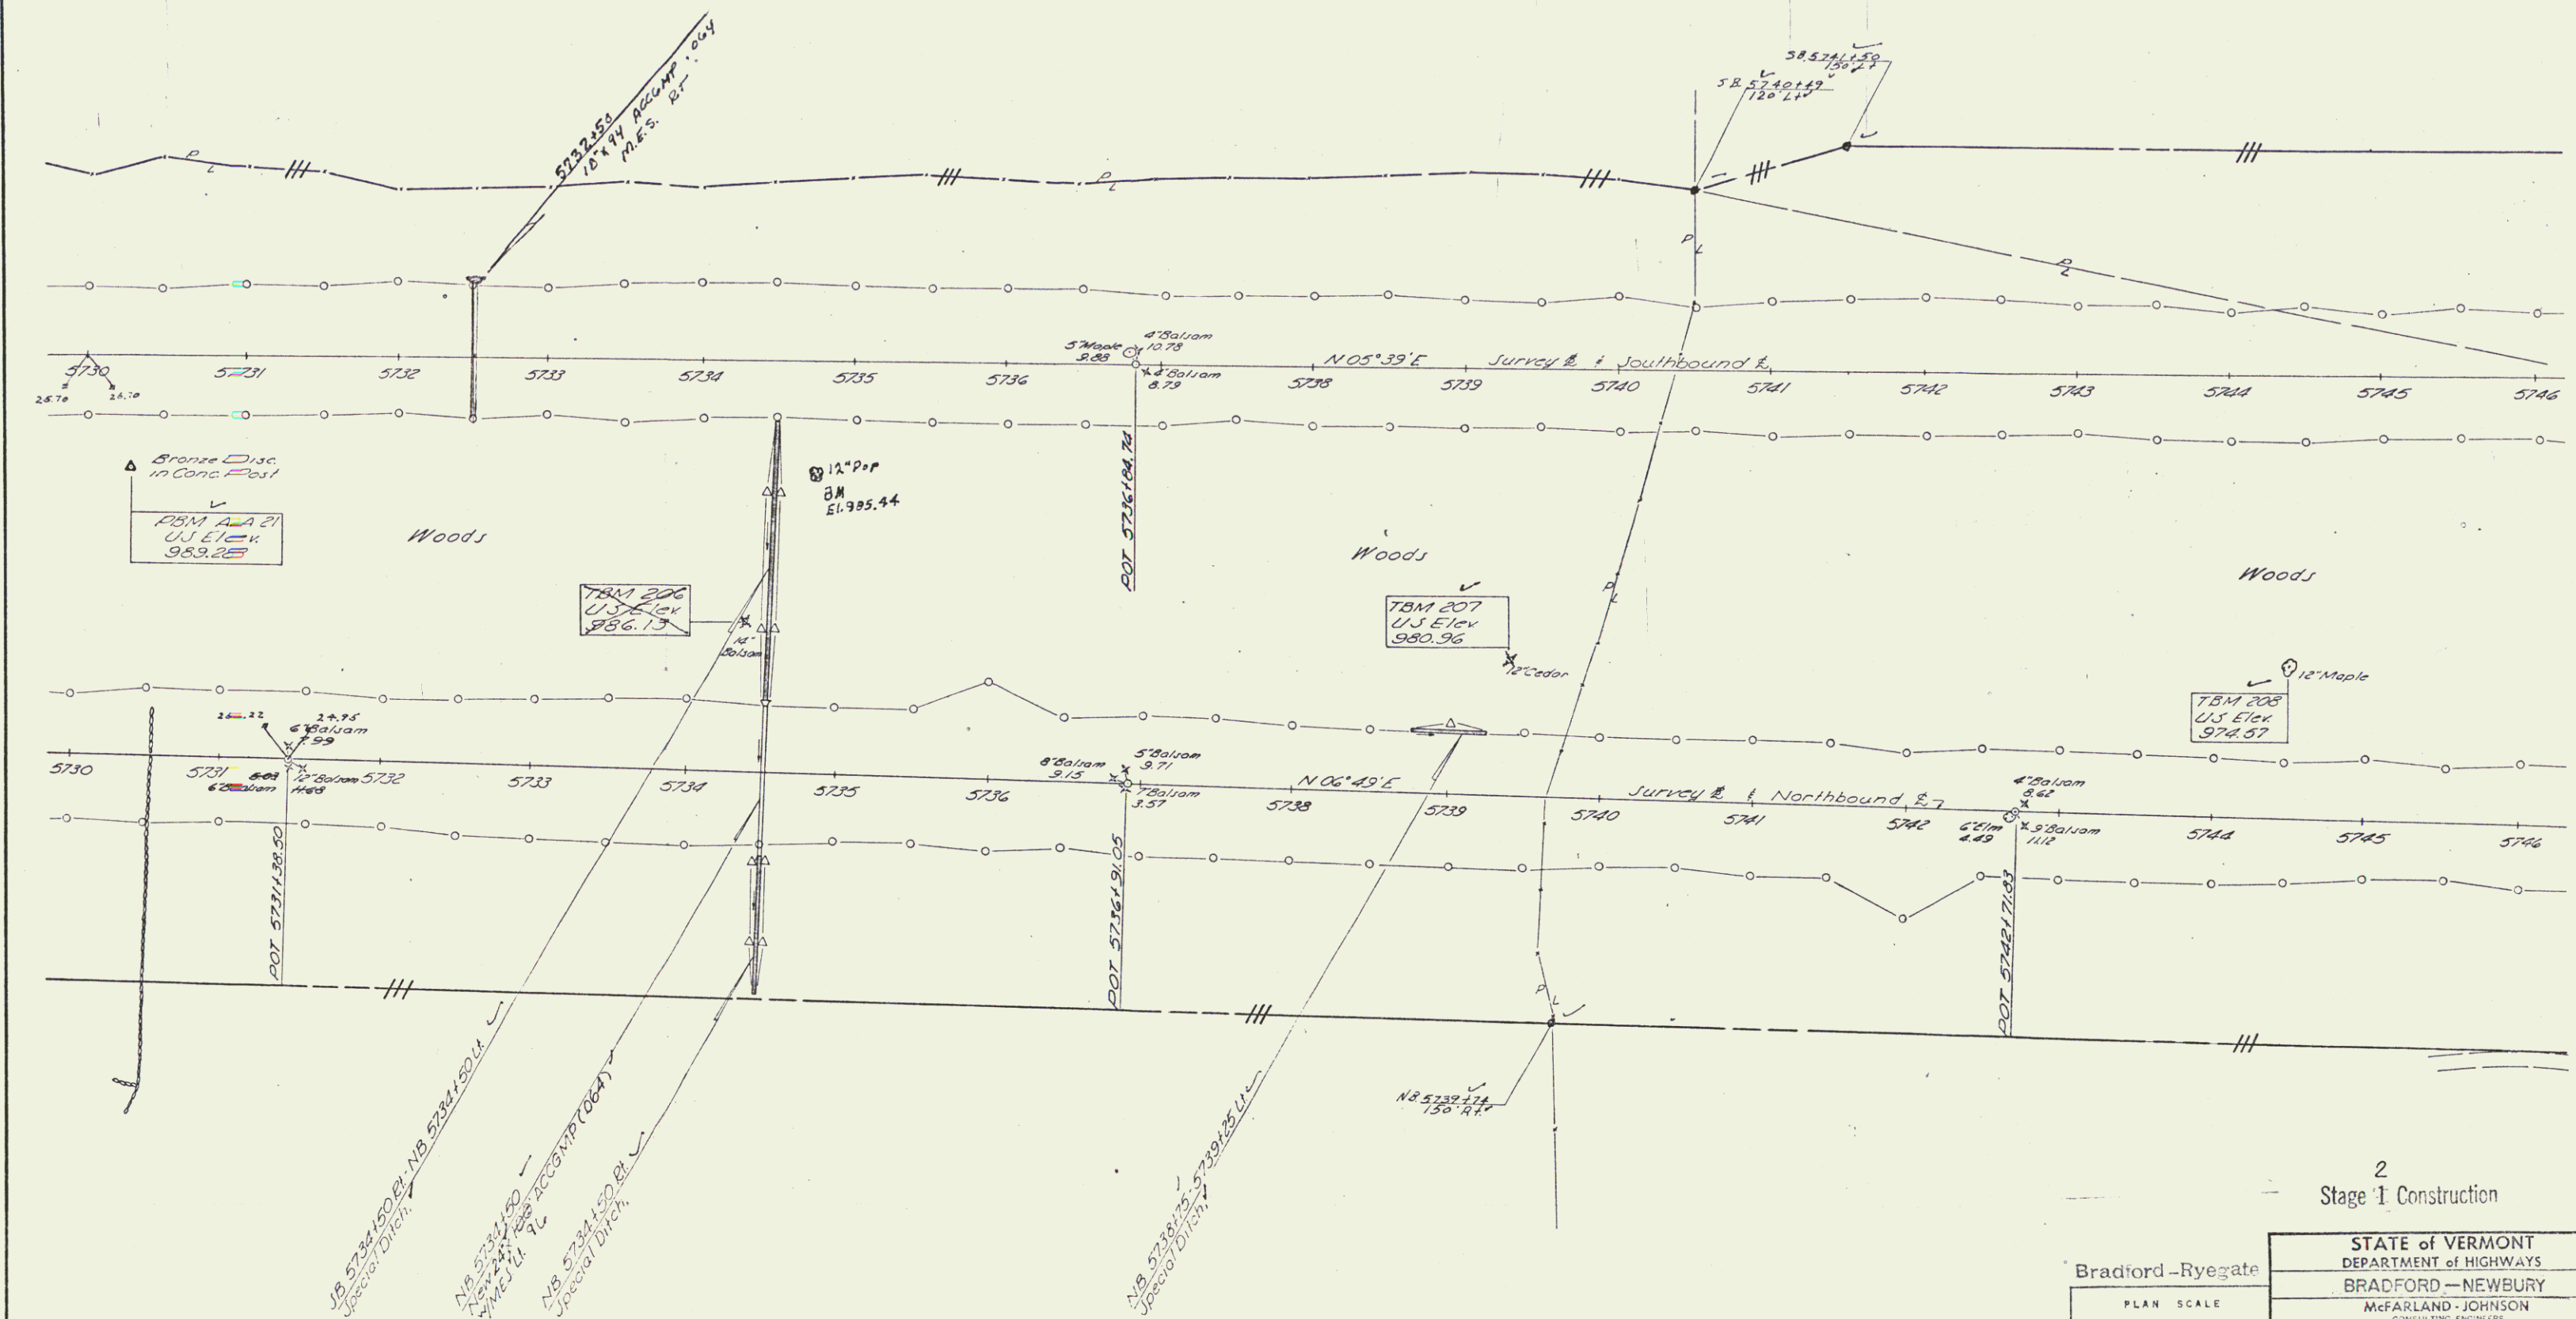


Woven Wire Fence w/Steel Posts


S.B. 5730+00 - 5746+00 LT
N.B. 5730+00 - 5746+00 RT
To be Erected Prior to Construction
N.B. 5739+74RT - 5746+00 RT
S.B. 5740+79LT - 5746+00 LT

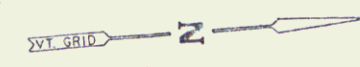

DATE: _____ BY: _____
PLAN: _____
NOTES: _____
NO. OF ANY CHANGES: _____
PROJECT NO.: _____

2
Stage I Construction

Bradford-Ryegate

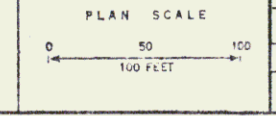

STATE of VERMONT	
DEPARTMENT of HIGHWAYS	
BRADFORD-NEWBURY	
McFARLAND-JOHNSON	
CONSULTING ENGINEERS	
DESIGNED BY: T. J. S.	CHECKED BY: D. E. R.
TRACED BY: E. F.	DATE: 11-15-88
PROJECT No: 1 91-2(11)	SHEET 58 OF 43
CONTRACT No: 3 26	

Control of Access
Complete on this sheet

R.O.W/const 127