
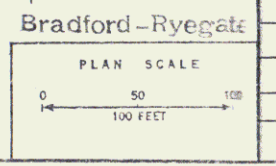


PLAN
 DATE: 5/11/67
 DRAWN BY: J.E.W.
 CHECKED BY: J.E.W.
 SCALE: AS SHOWN

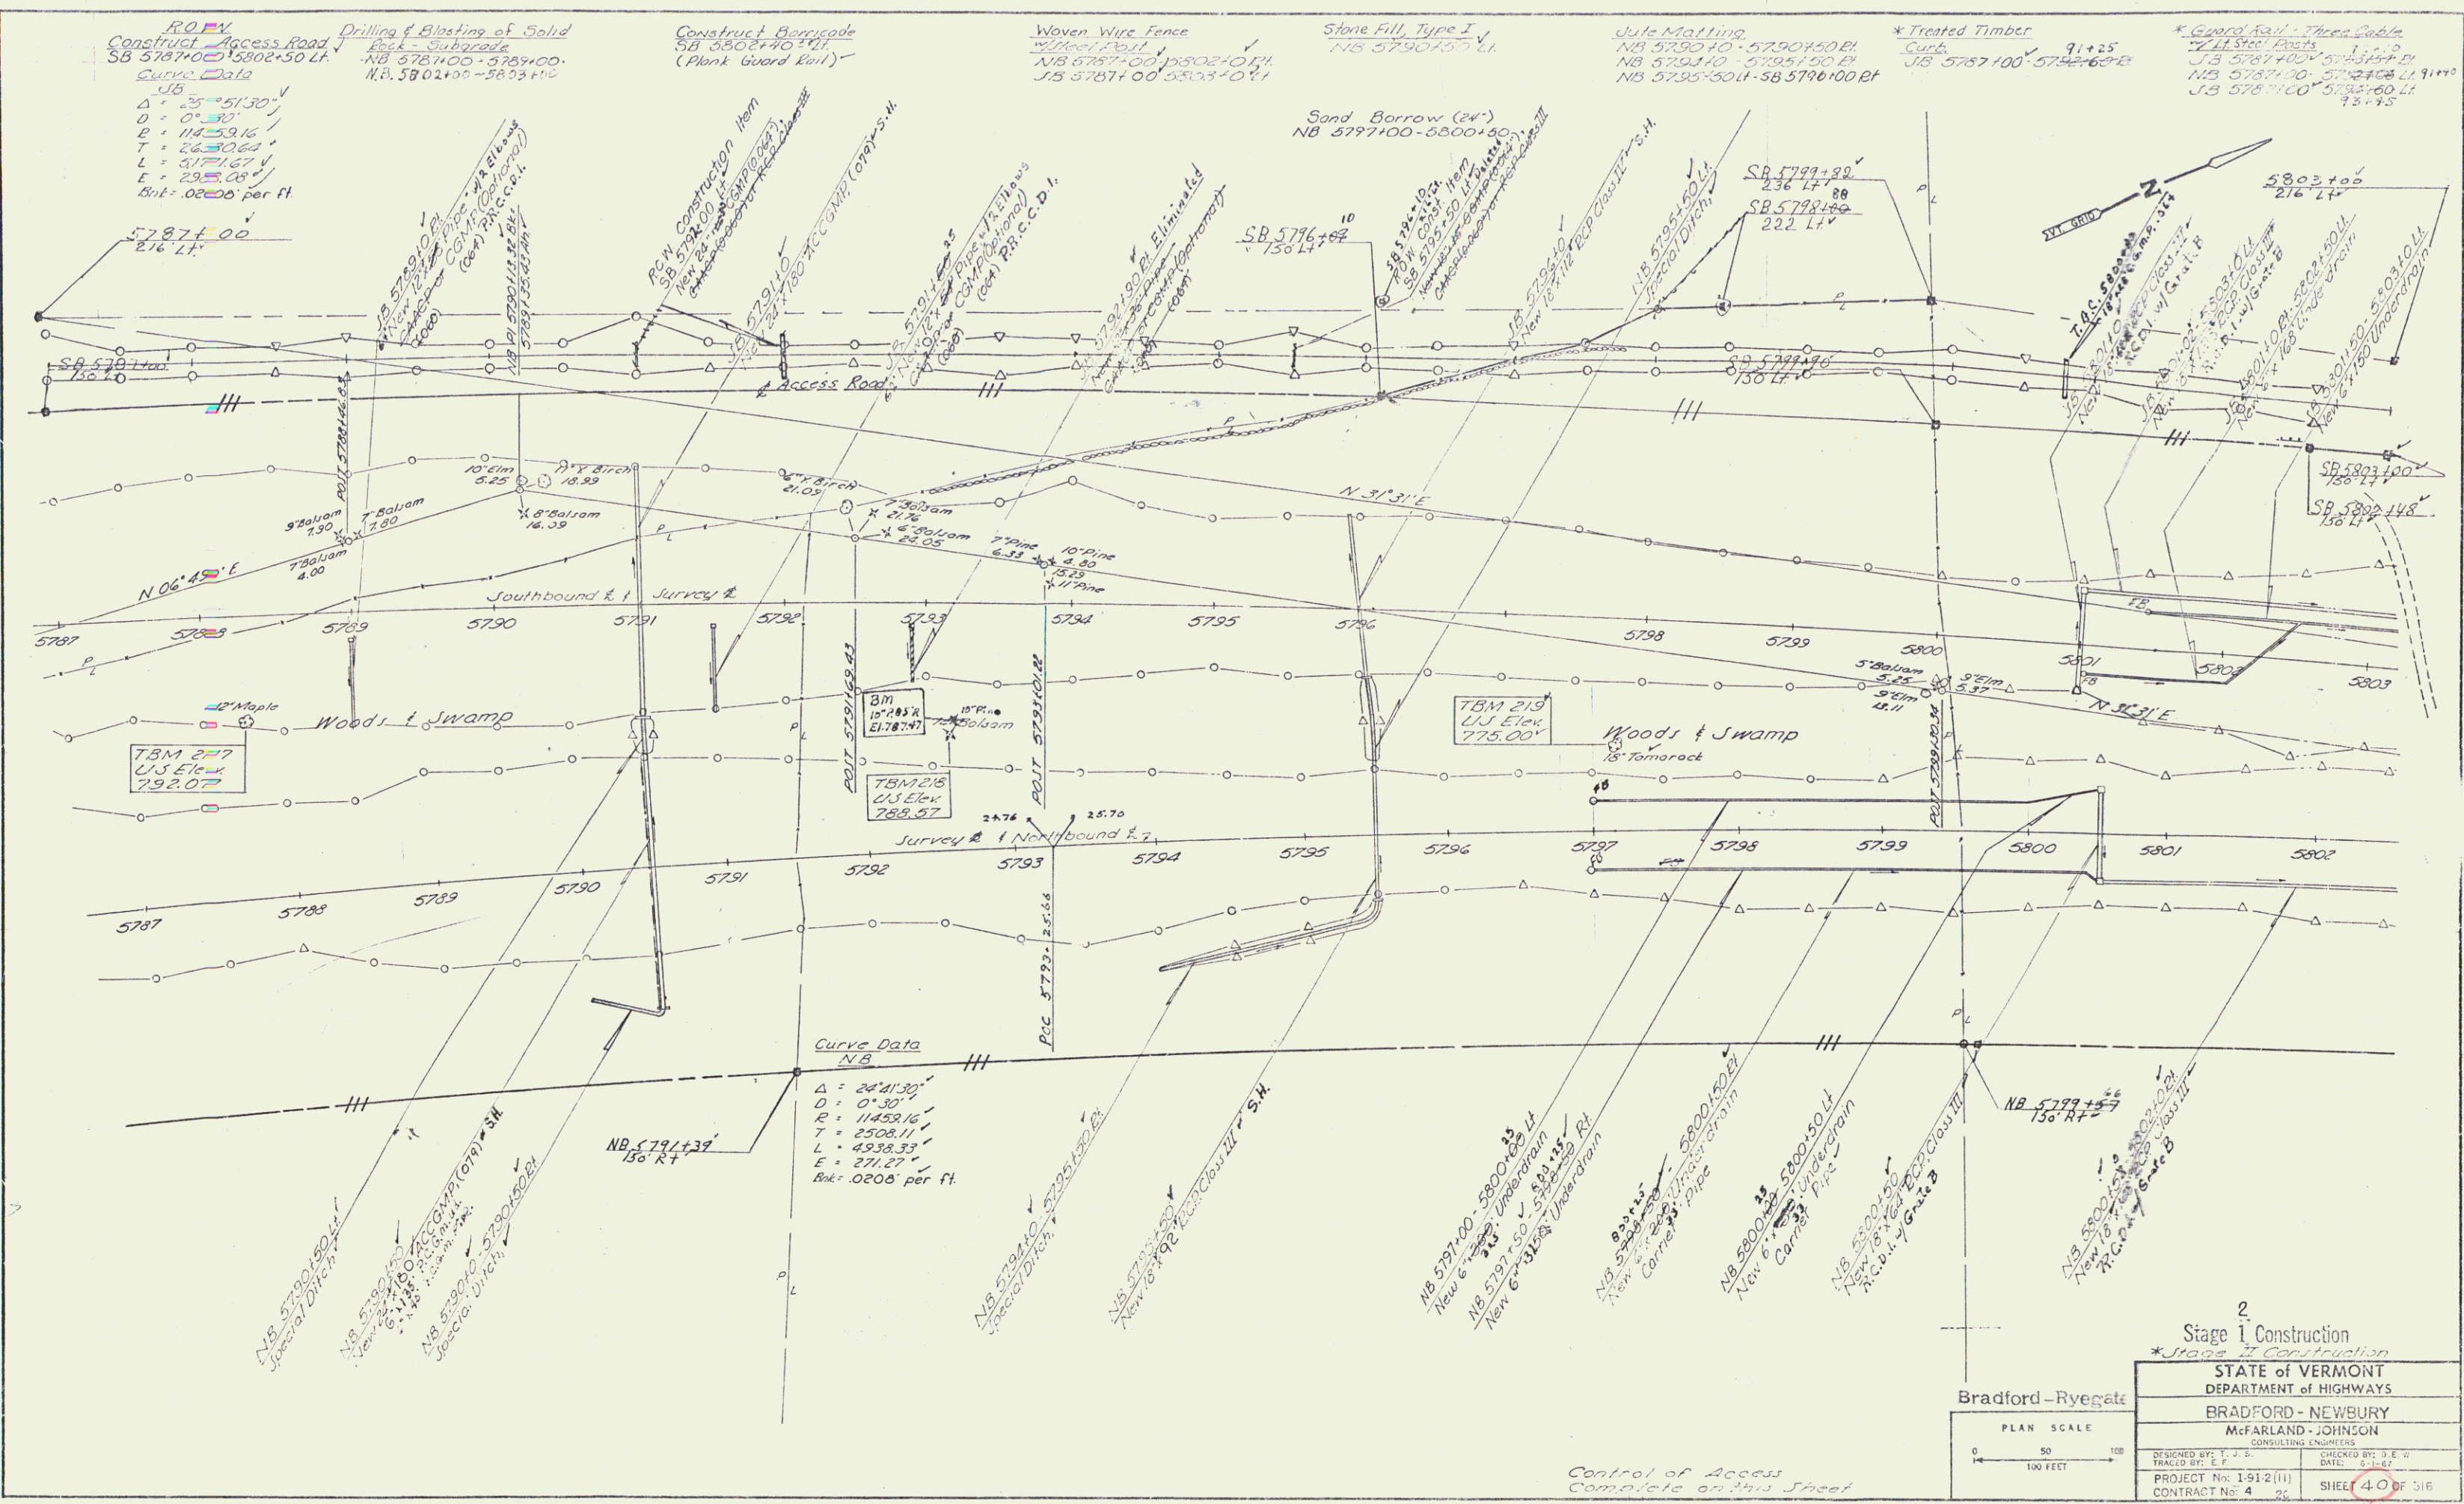

2 Stage 1 Construction *Stage 2 Construction	
STATE OF VERMONT DEPARTMENT OF HIGHWAYS	
BRADFORD - NEWBURY	
McFARLAND - JOHNSON CONSULTING ENGINEERS	
DESIGNED BY: J.E.W.	CHECKED BY: J.E.W.
TRACED BY: J.E.W.	DATE: 5-11-67
PROJECT No: 1-912(11)	SHEET 4 OF 516
CONTRACT No: 4	

Control of Access
 Complete on this Sheet

R.O.Wjconst 133