

Drilling & Blasting of Solid Rock Subgrade
 NB 5872+25-5874+25
 NB 5876+25-5881+19.00
 SE 5876+25-5881+36.18

Demolition and Disposal of Buildings
 NB 5875+15
 NB 5875+15
 NB 5875+15

Woven Wire Fence w/ Steel Posts
 NB 5871+00-5881+62.11
 NB 5871+00-5880+37.24

Mane Fill, Type II
 NB 5871+00-5871+75.24



Plant Guard Rail w/ 4200 Posts
 NB 5871+03

Auto-Matting, 45'
 NB 5872+50-5876+20.11
 NB 5876+25-5877+0
 NB 5877+0-433+50

Treated Timber Curb
 NB 5871+10-5875+41.11

Guard Rail-Standard Steel Beam w/ Steel Posts, Type II
 NB 5871+00-5876+62.11

PLAN	DATE
REVISED	
DATE	
BY	
NO.	

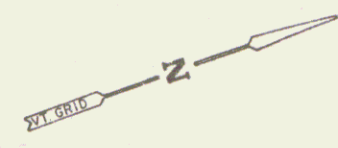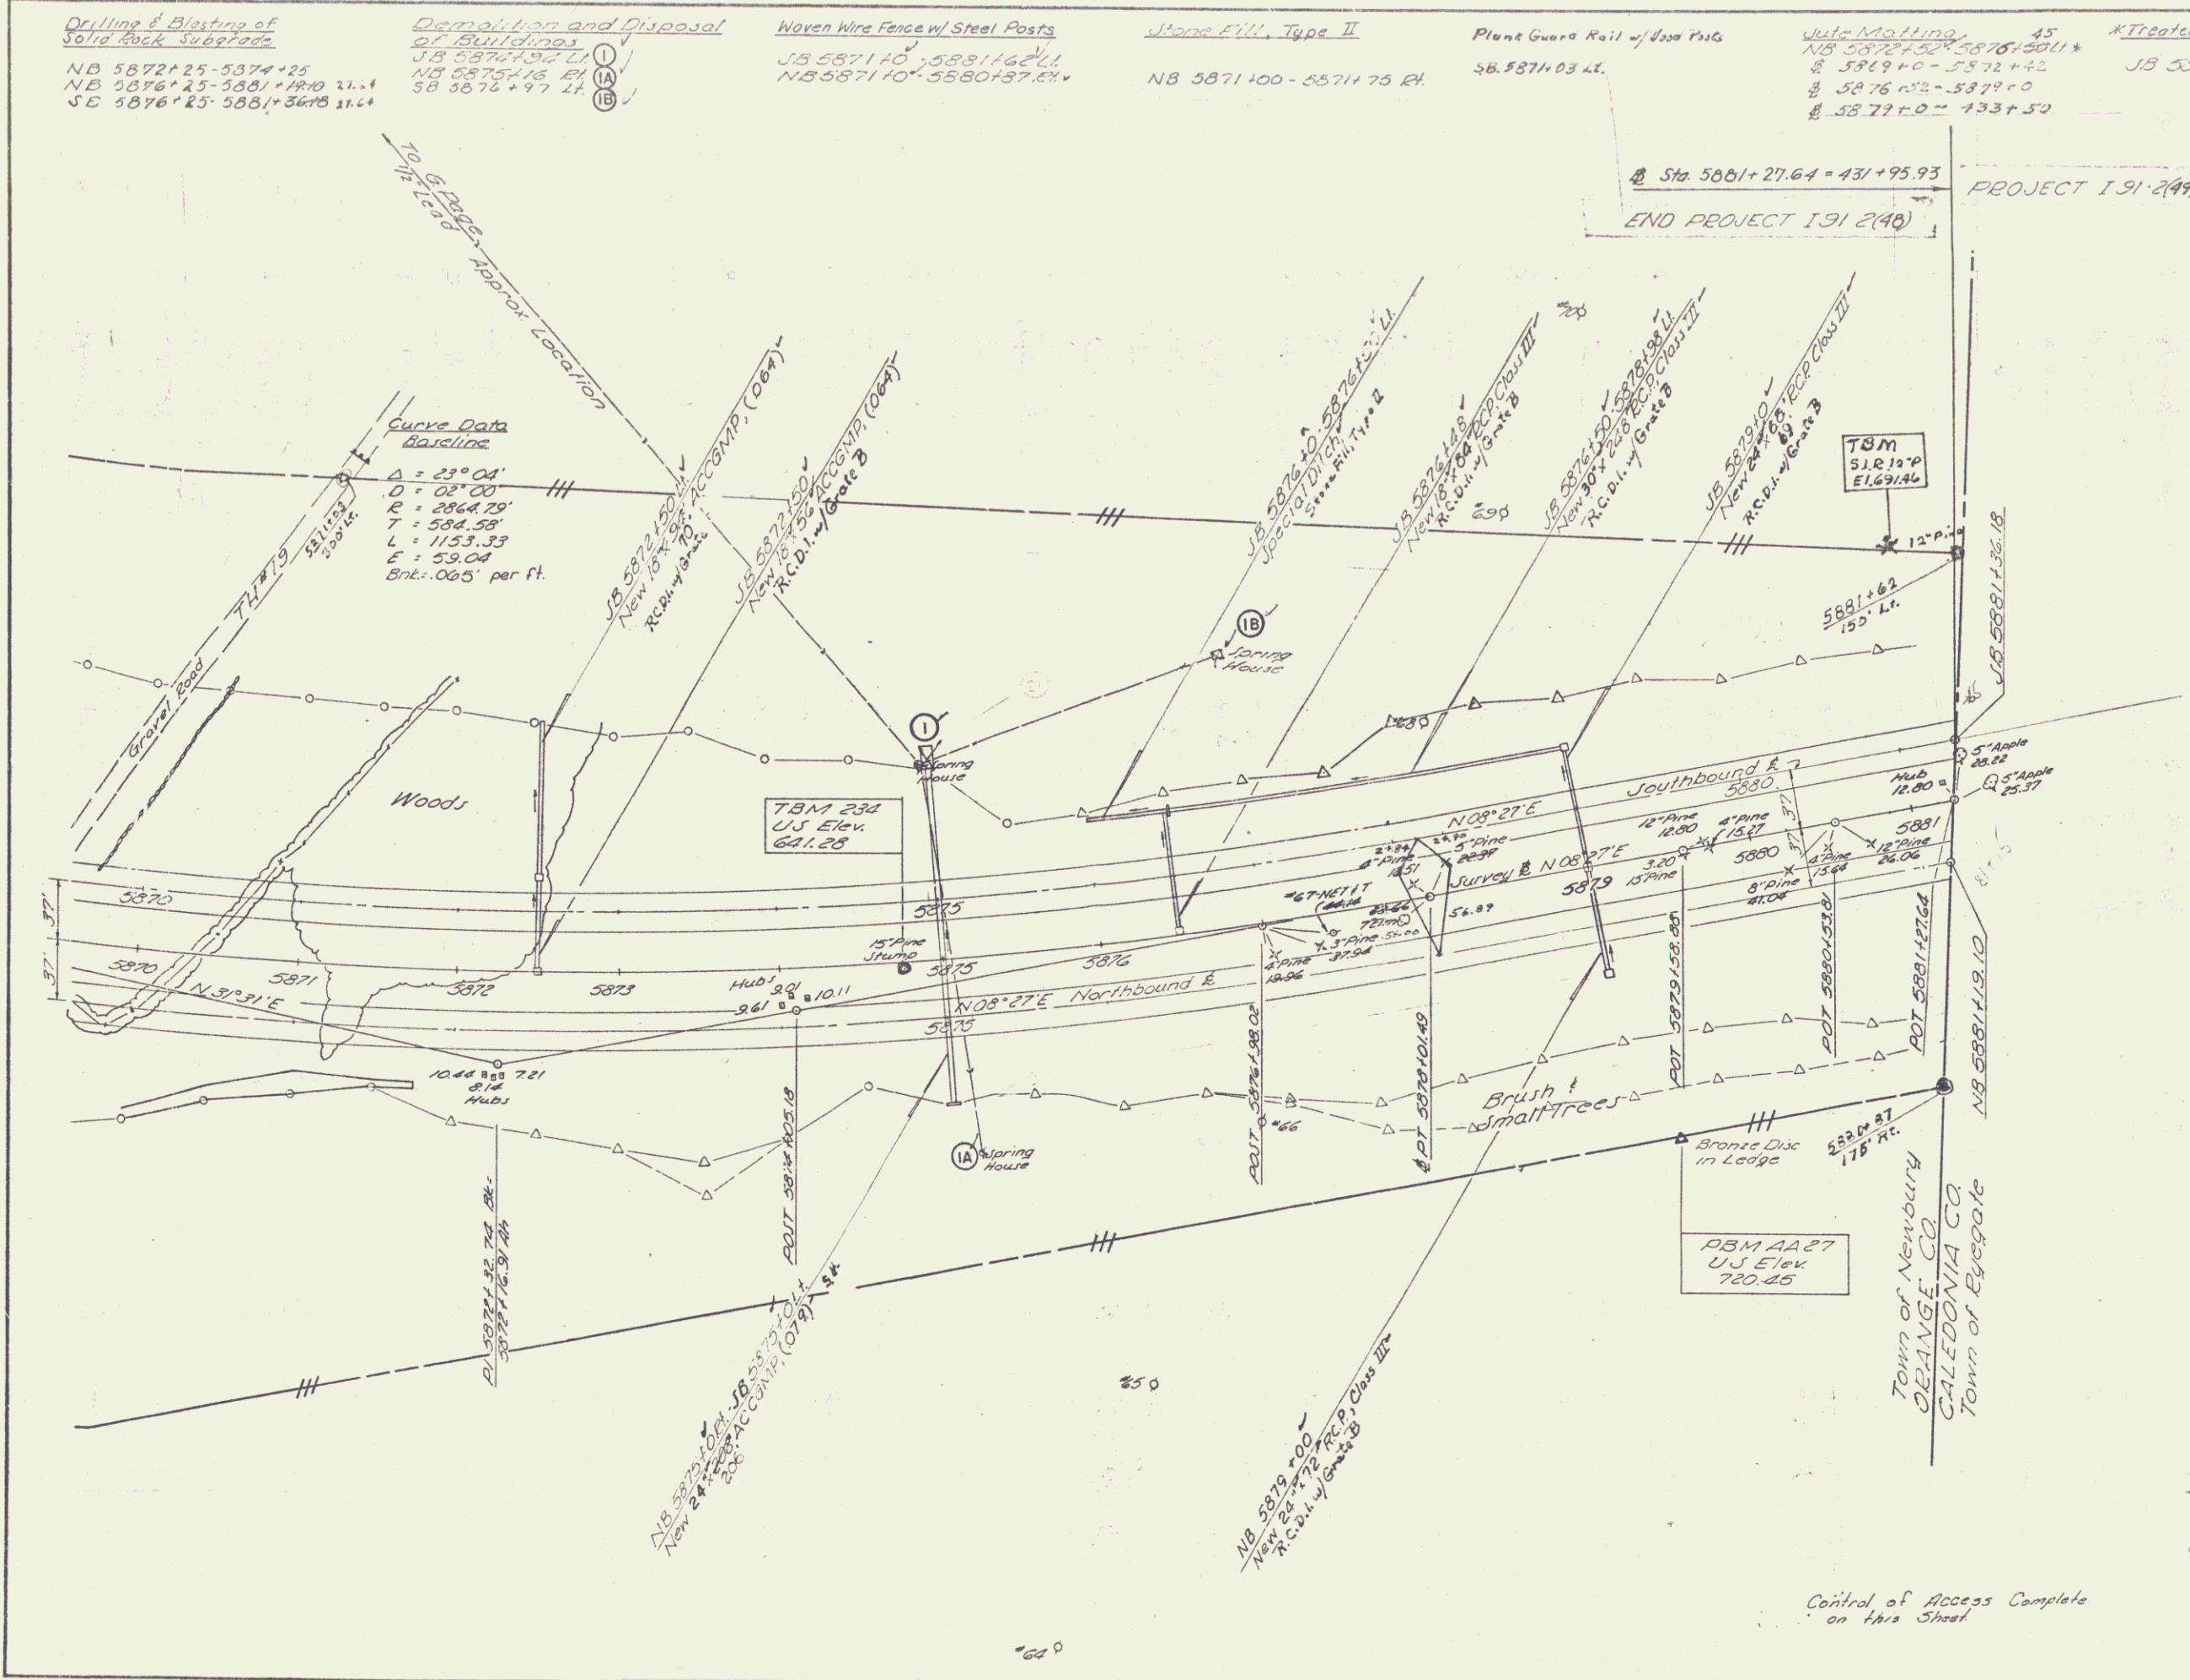

Stage 1 Construction
 * Stage 2 Construction

Bradford-Ry gate

DESIGNED BY: T. J. S.	CHECKED BY: D. E. W.
TRACED BY: E. J. H.	DATE: 8-1-57
PROJECT No: 1-91-249	
SHEET 37 OF 73	

178 430

R.O.W/const 145