

CONTINUOUS CONCRETE CURB  
ITEM 433  
N.B. STA 444+50 - 445+00, RT.

W/TE MATING - ITEM 432  
N.B. STA 444+50 - 445+00 Median

STONE FILL FOR SLOPE PROTECTION  
ITEM 434  
S.B. STA 433+70 - 50 FT. TO 35 FT.  
N.B. STA 444+15 - 445+00, RT.

THREE CABLE GUARD RAIL  
W/STEEL POSTS - ITEM 432  
S.B. STA 443+30 - 445+00, LT  
N.B. STA 444+22 - 445+00, RT.

GRILLING & BLASTING OF  
SOLID ROCK SURFACE - ITEM 435  
S.B. STA 443+00 - 443+50  
S.B. STA 443+50 - 444+25  
N.B. STA 443+00 - 444+25

PROPERTY LINE FENCE  
W/STEEL POSTS - ITEM 563 - I, MOD.  
S.B. STA 432+04.47 - 445+03, LT  
N.B. STA 431+87.39 - 445+00, RT.

GRADED RUBBLE PAVING - ITEM 413 - B  
S.B. STA 438+00.47 LT TO 88' LT  
S.B. STA 431+30.42 LT TO 68' LT.

END CONTRACT NO.  
END PROJECT 191-2 (II)  
S.B. STA. 588+36.18

BEGIN CONTRACT NO. 1  
BEGIN PROJECT 191-2 (S)  
S.B. STA 432+04.47

S.B. 432+58  
239'

98

Longmore ROW  
from Green

S.B. & P.C. 440+77.90

S.B. & P.O.C. 444+00.00

NB 431+55  
BEGIN PROJECT  
I-91-2 (20) ROW

NB 431+55  
138'

IA

N.B. & P.C. 436+95.79

1347'

S.B. #2  
U.S. Elev.  
745.59


END CONTRACT NO.  
END PROJECT 191-2 (II)

BEGIN CONTRACT NO. 1  
BEGIN PROJECT 191-2 (II)  
N.B. STA 431+87.39

DEMOLITION AND DISPOSAL  
OF EXISTING STRUCTURES

POOR ORIGINAL COPY

Note: \*Indicates Stage 2 Construction

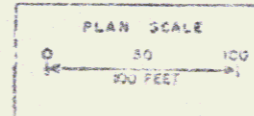

PLAN STA. 431+87.39 TO 445+00 N.B.  
Stage 1 Construction  
DATE 1/29/88

In Charge of: A.J.P.  
Made by: S.E.P.  
Checked by: J.E.  
Drawn by: E.D.L.  
Control by: J.P.