


CONSTRUCT DRIVE  
APPROX. STA. 1+80 LT.

Rev Curve  
Δ 22°45'03" LT  
R 1432.40  
T 238.18  
L 508.77  
E 28.71  
Bank 0.032171 ft

Match B-B

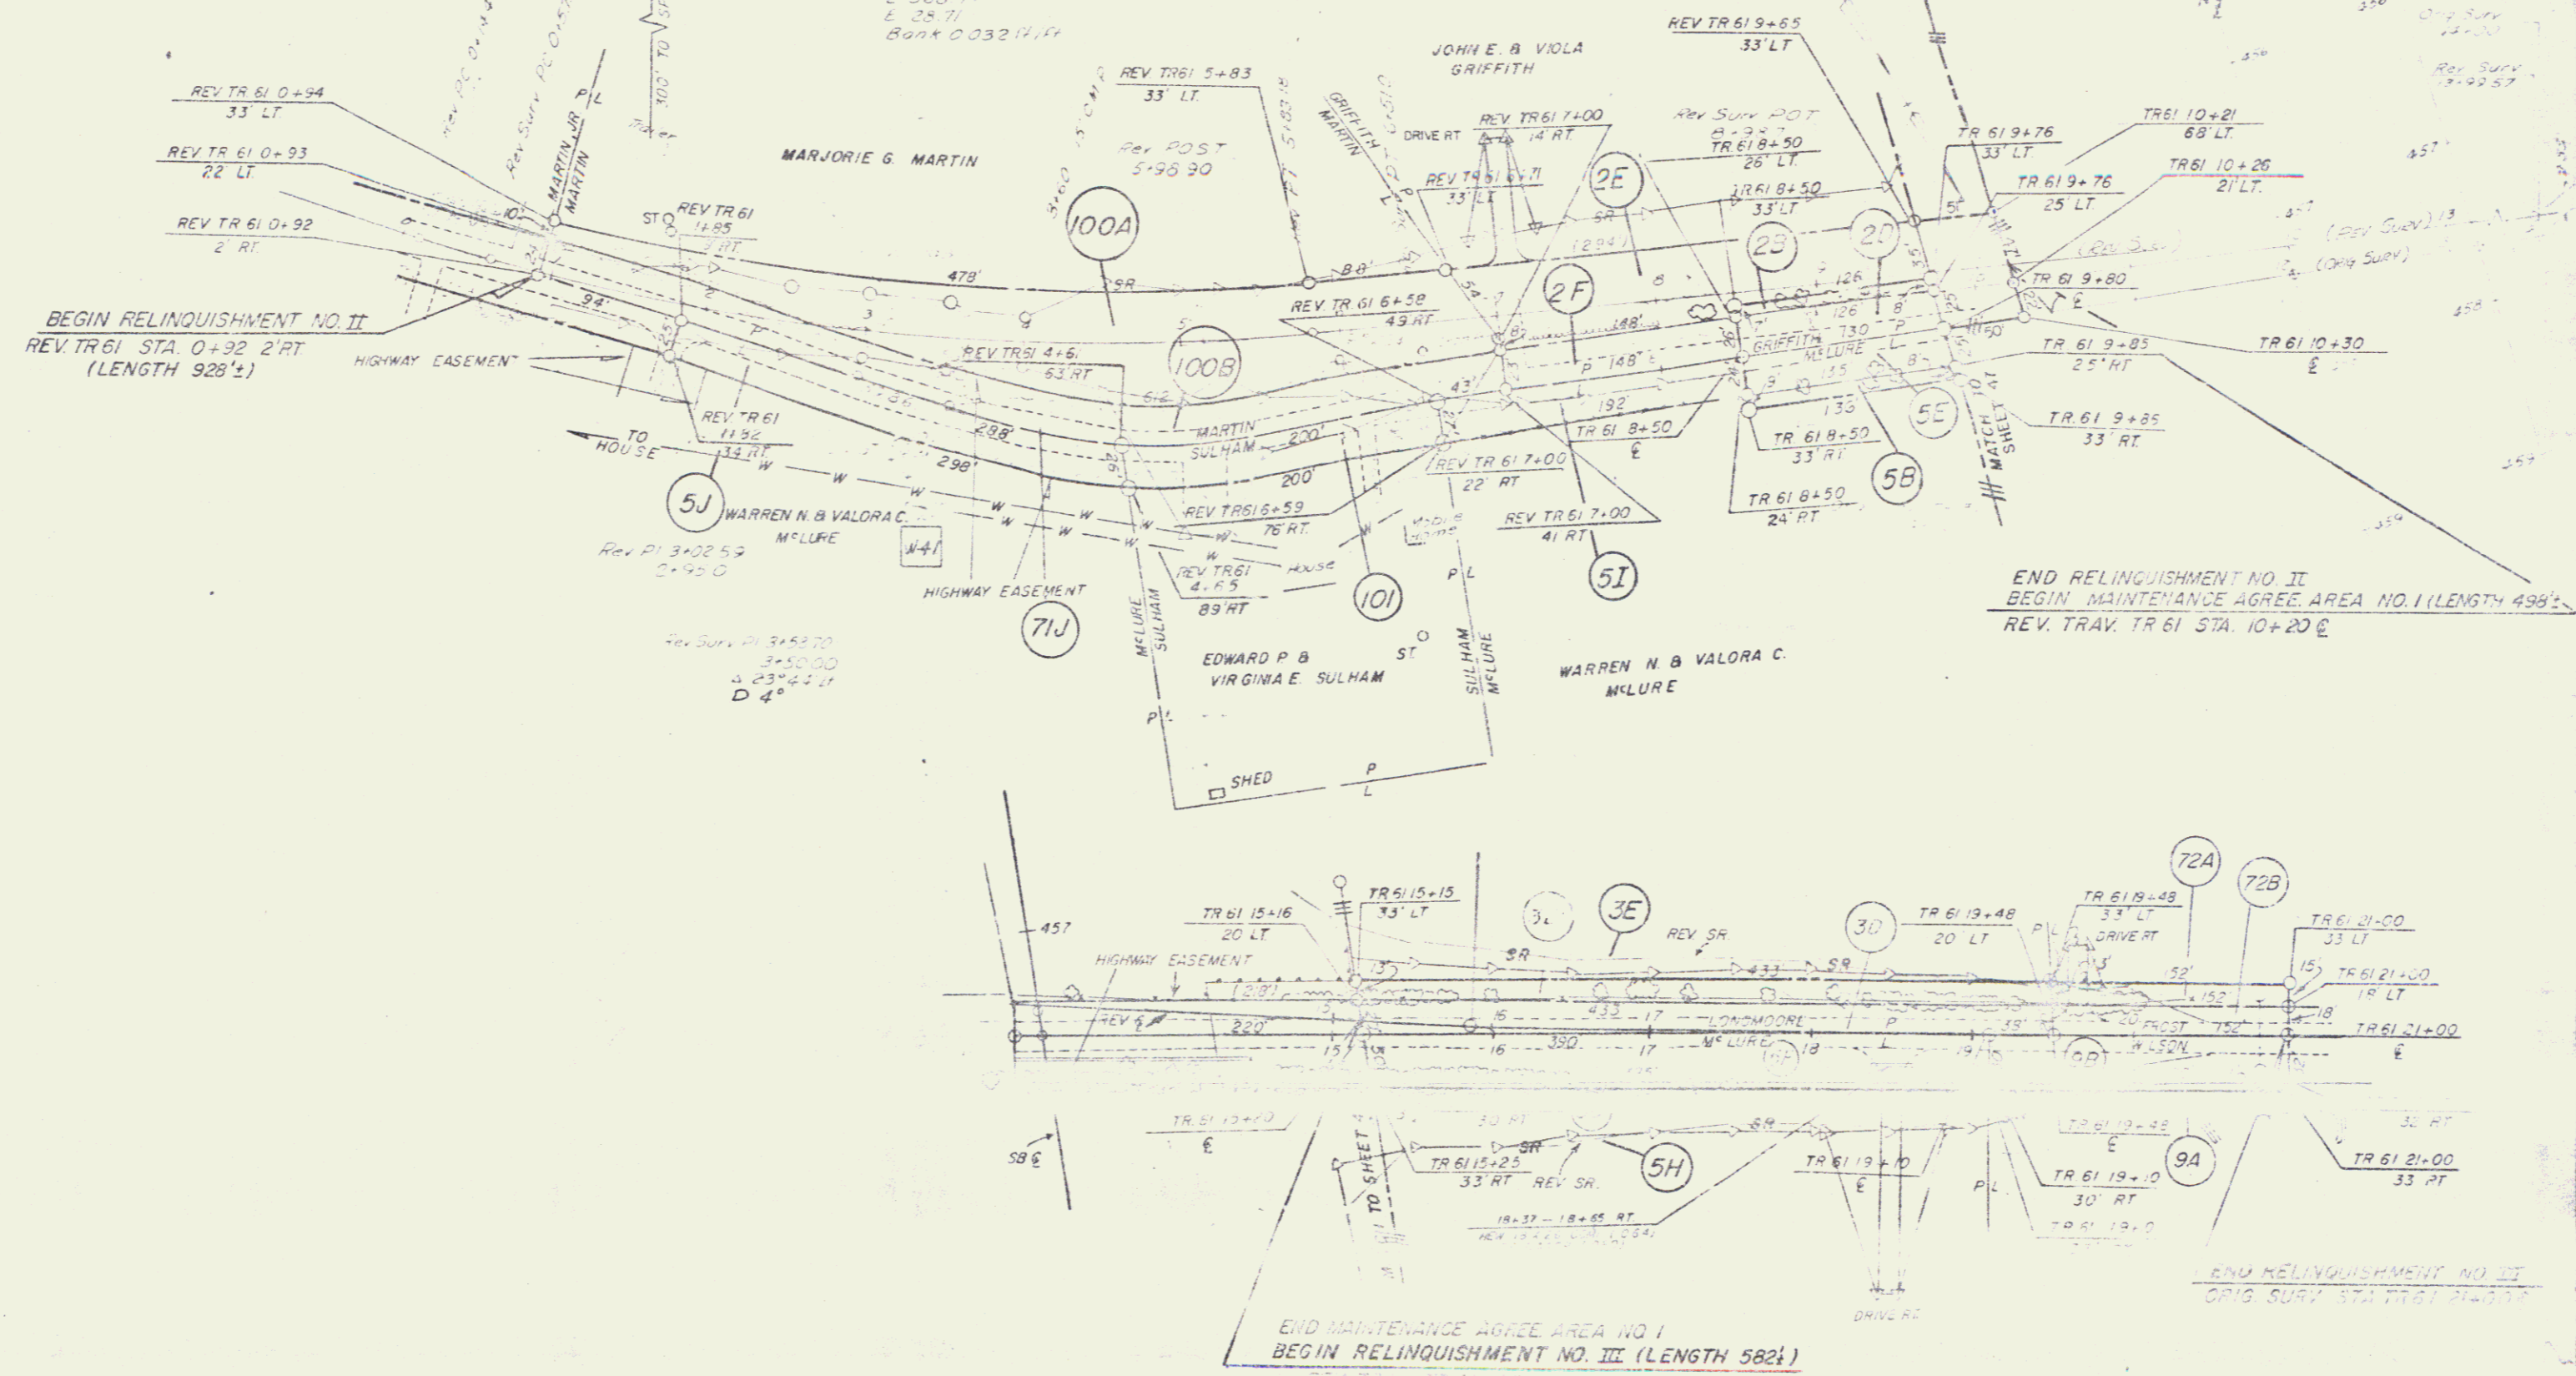

PLAN  
SCALE  
DATE

PROJECT RYEGATE-BARNET  
 NO IS1-2 (20)  
 SHEET 72A OF 139