


PROPERTY LINE FENCE
W/ STEEL POSTS - ITEM 583 - 11 MOD.
S.B. Sta. 533+00 - 545+04, LT.
S.B. Sta. 545+79 - 549+47, LT.
N.B. Sta. 533+00 - 545+10, RT.

ALUMINUM COATED STEEL
CHAIN LINK FENCE - ITEM 580 - I - B
N.B. Sta. 545+10 - 549+50, RT.

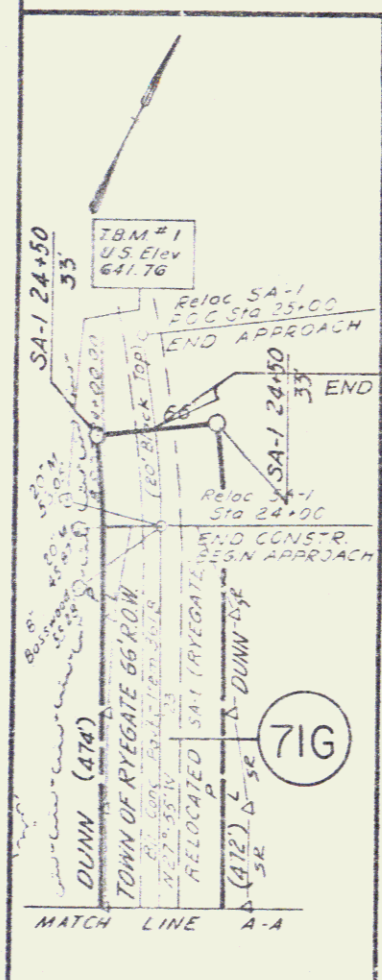

STONE FILL FOR SLOPE PROTECTION
(LIGHT TYPE) - ITEM 512
N.B. Sta. 547+70, RT.
S.B. Sta. 539+00 - 539+40, RT.
SA-1 Sta. 11+00, RT.


JUTE MATTING - ITEM 623
S.B. Sta. 540+00 - 540+75, LT.
SA-1 Sta. 11+00 - 12+75, RT.
N.B. Sta. 543+00 - 544+00, RT.
S.B. Sta. 541+00 - 542+00, LT.
S.B. Sta. 533+00 - 544+50, RT.
S.B. Sta. 546+10 - 547+75, LT.
S.B. Sta. 546+20 - 547+20, LT.
S.B. Sta. 546+00 - 546+75, RT.

THREE CABLE GUARD RAIL
W/ STEEL POSTS - ITEM 542
N.B. Sta. 540+00 - 540+75, LT.
S.B. Sta. 539+00 - 540+00, LT.
S.B. Sta. 541+00 - 542+00, LT.
S.B. Sta. 543+00 - 544+00, LT.
S.B. Sta. 545+00 - 546+00, LT.
S.B. Sta. 547+00 - 548+00, LT.
S.B. Sta. 549+00 - 550+00, LT.

RELOC SA-1 RYEGATE
CURVE DATA
Δ 41°-04'-10" RT
D 71'-38"-22"
R 750.00'
T 280.93'
L 537.60'
E 51.00'
Bank 7 1/4"
P.I. N 612.012.021
E 612.012.021

TR 48 RELOC
CURVE DATA
L 48'-50"-26"
D 19°-05'-55"
R 300.20'
T 136.53'
L 256.25'
E 29.61'
Bank 3/4"
P.I. N 619.039.196
E 611.832.926

REMOVAL & DISPOSAL
OF BUILDING - ITEM 586
S.B. Sta. 544+00, 85 LT.
S.B. Sta. 544+01, 60 LT.
S.B. Sta. 544+50, 35 RT.

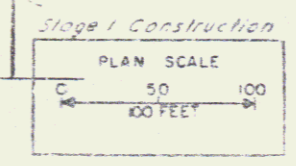

PLAN STA. 533+00 TO 549+50 N.B.
RELOCATED SA-1 (RYEGATE), TOWN RD #44 RELOC. 'A'
191-2-20

DATE	BY	DESCRIPTION
5/13/22	EDL	CONSTRUCTION

In Charge of AJP
Made by S.V.
Checked by A.V.
Traced by EDL W. LETSIE
Checked by S.V.

Note: * indicates Stage 2 Construction

PROJECT 191-2(16)
BEGIN CONTRACT NO. 2
N.B. & S.B. STA. 533+0000