


Sheet 86

PLAN STA. 324 + 50 N.B. TO END OF CONTRACT
 REF. SA-1 (PURNETT) RAMP 2, B.C. R.D.

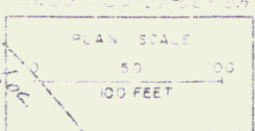

Note: See Sheet BR 200 Series for the SA-1 Structure

In Charge of: R.P.D.
 Made by: V.B.A.T.V.
 Checked by: J.L.V.
 Drawn by: E.C. GUMBLE

RYECATE BARNET
 191-2120

GOODING & COGA
 828.67

POOR ORIGINAL COPY

Sheet 85 828.67

45