

Parcels 111 and 132
conveyed to M. McIndoe
Falls Fire District No. 3
by QCD dated 6/28/94
& recorded in BK 90, pg 437, 438


JOHN C. & MARGARET D.
HARDEN

111

SEE SHEET 'O' OF 'P'
FOR LOCATION ON PROJECT

see sheet 89 B

Approx
1 mile
from Filtration plant

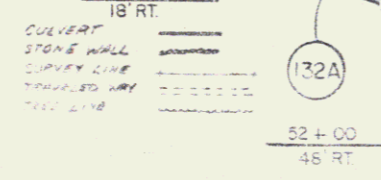

HAROLD A. & CROTHY S. KIRK - LESSOR
CALVIN BOURTELLE - LESSEE

RYEGATE - BARNET
I 91 - 2 (200)
TOWN OF BARNET

89 A 139

54

