


STATE OF VERMONT TO PETER BAKER BY Q.C. DEED
 DATED NOV 12, 1980 RECORDED DEC. 5, 1980 BK. 65
 PAGE 503-504 (FORMERLY PARCELS 13 G & 23 B)

13G PPM 80-1 Rr 7a (2)

See sheets 30A & B

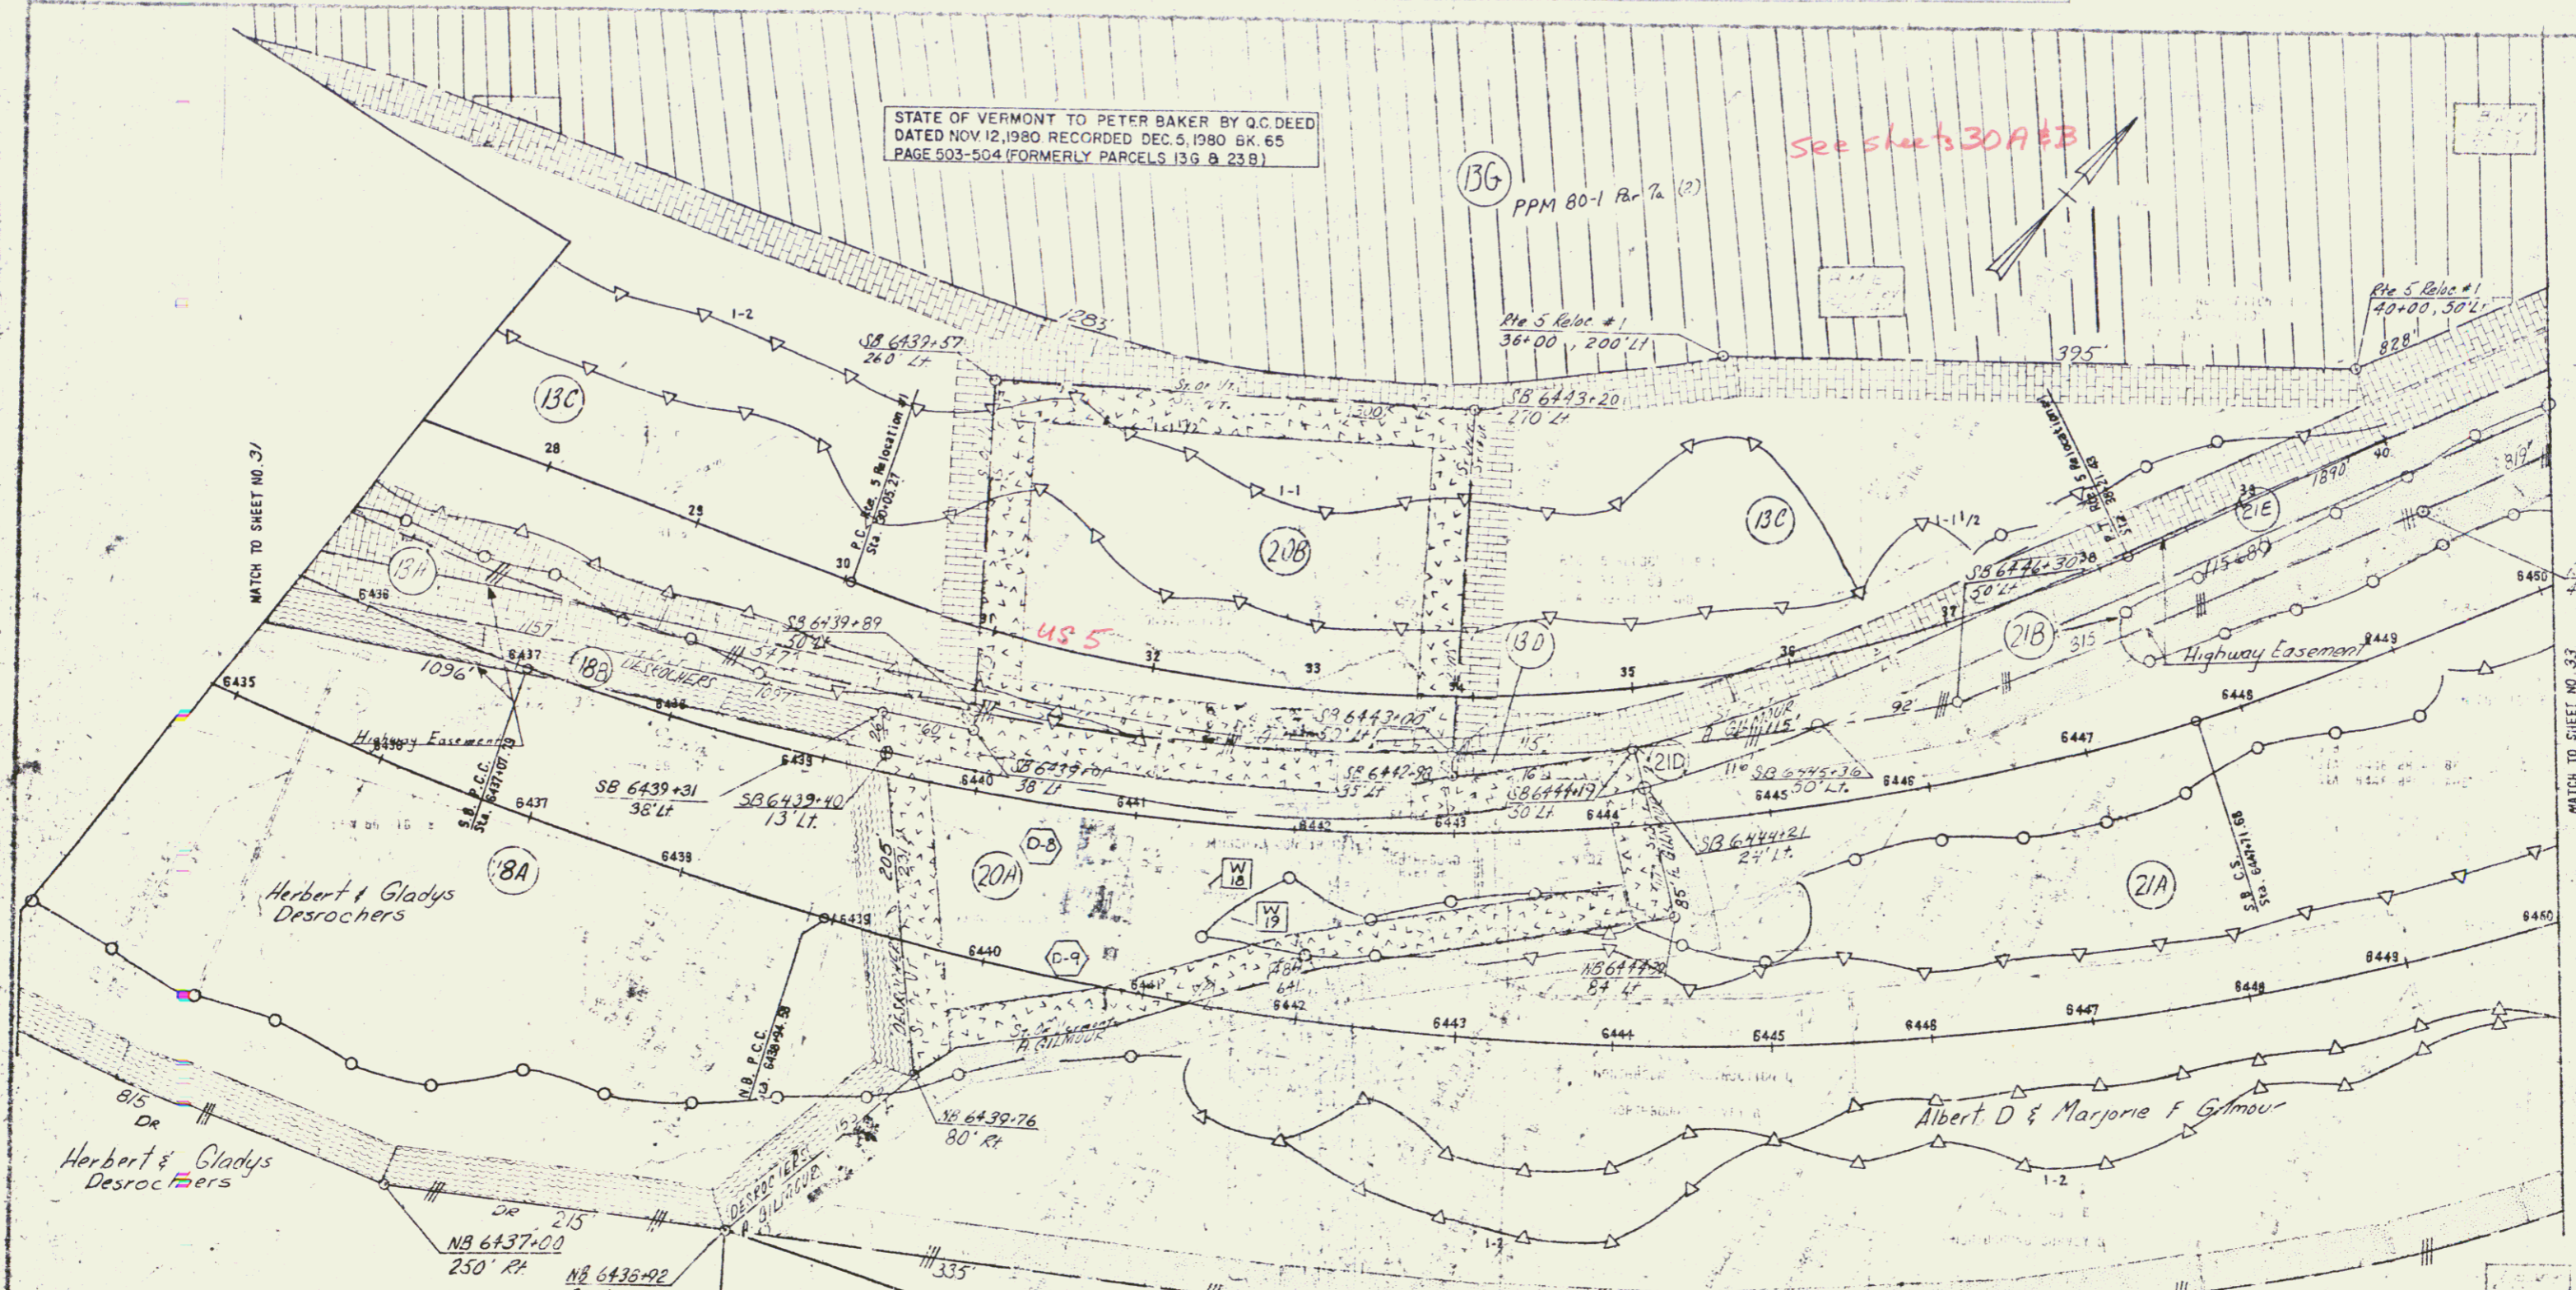

NOTE: SEE EXPLANATION

41	32	19	10	45	2	20
57	20	11	10	27	20	20
134	21	26	1	38	8	8
47	2	6	1	63	1	1
48	10	11	1	131	2	2
4	1	6	1	1	1	1

MATCH TO SHEET 32A
 NB 6442+00
 180' Rr

21I ALL DRIVES AS INDICATED ON
 PLANS ARE SUBJECT TO PER-
 MITS PURSUANT TO TITLE 19,
 SECTION 13 V.S.A.

STATE OF VERMONT
 DEPARTMENT OF CONSERVATION
 TOWN OF BARNET - St Johnsbury

POOR ORIGINAL COPY

PROJECT NO. 151 (21) (2)
 SHEET 32 OF 150

JAN 10 1984