


STATE OF VERMONT TO PETER BAKER BY Q.C. DEED
DATED NOV 12, 1980. RECORDED DEC 5, 1980 BK 65
PG 503-504 (FORMERLY PARCELS 13G & 23B)

STATE OF VERMONT TO TOWN OF BARNET
BY Q.C. DEED DATED SEP 16, 1981
RECORDED OCT 1, 1981, BK 66 PG 347-9

ALL DRIVES AS INDICATED ON
PLANS ARE SUBJECT TO PER-
MITS PURSUANT TO TITLE 19,
SECTION 43, V.S.A.

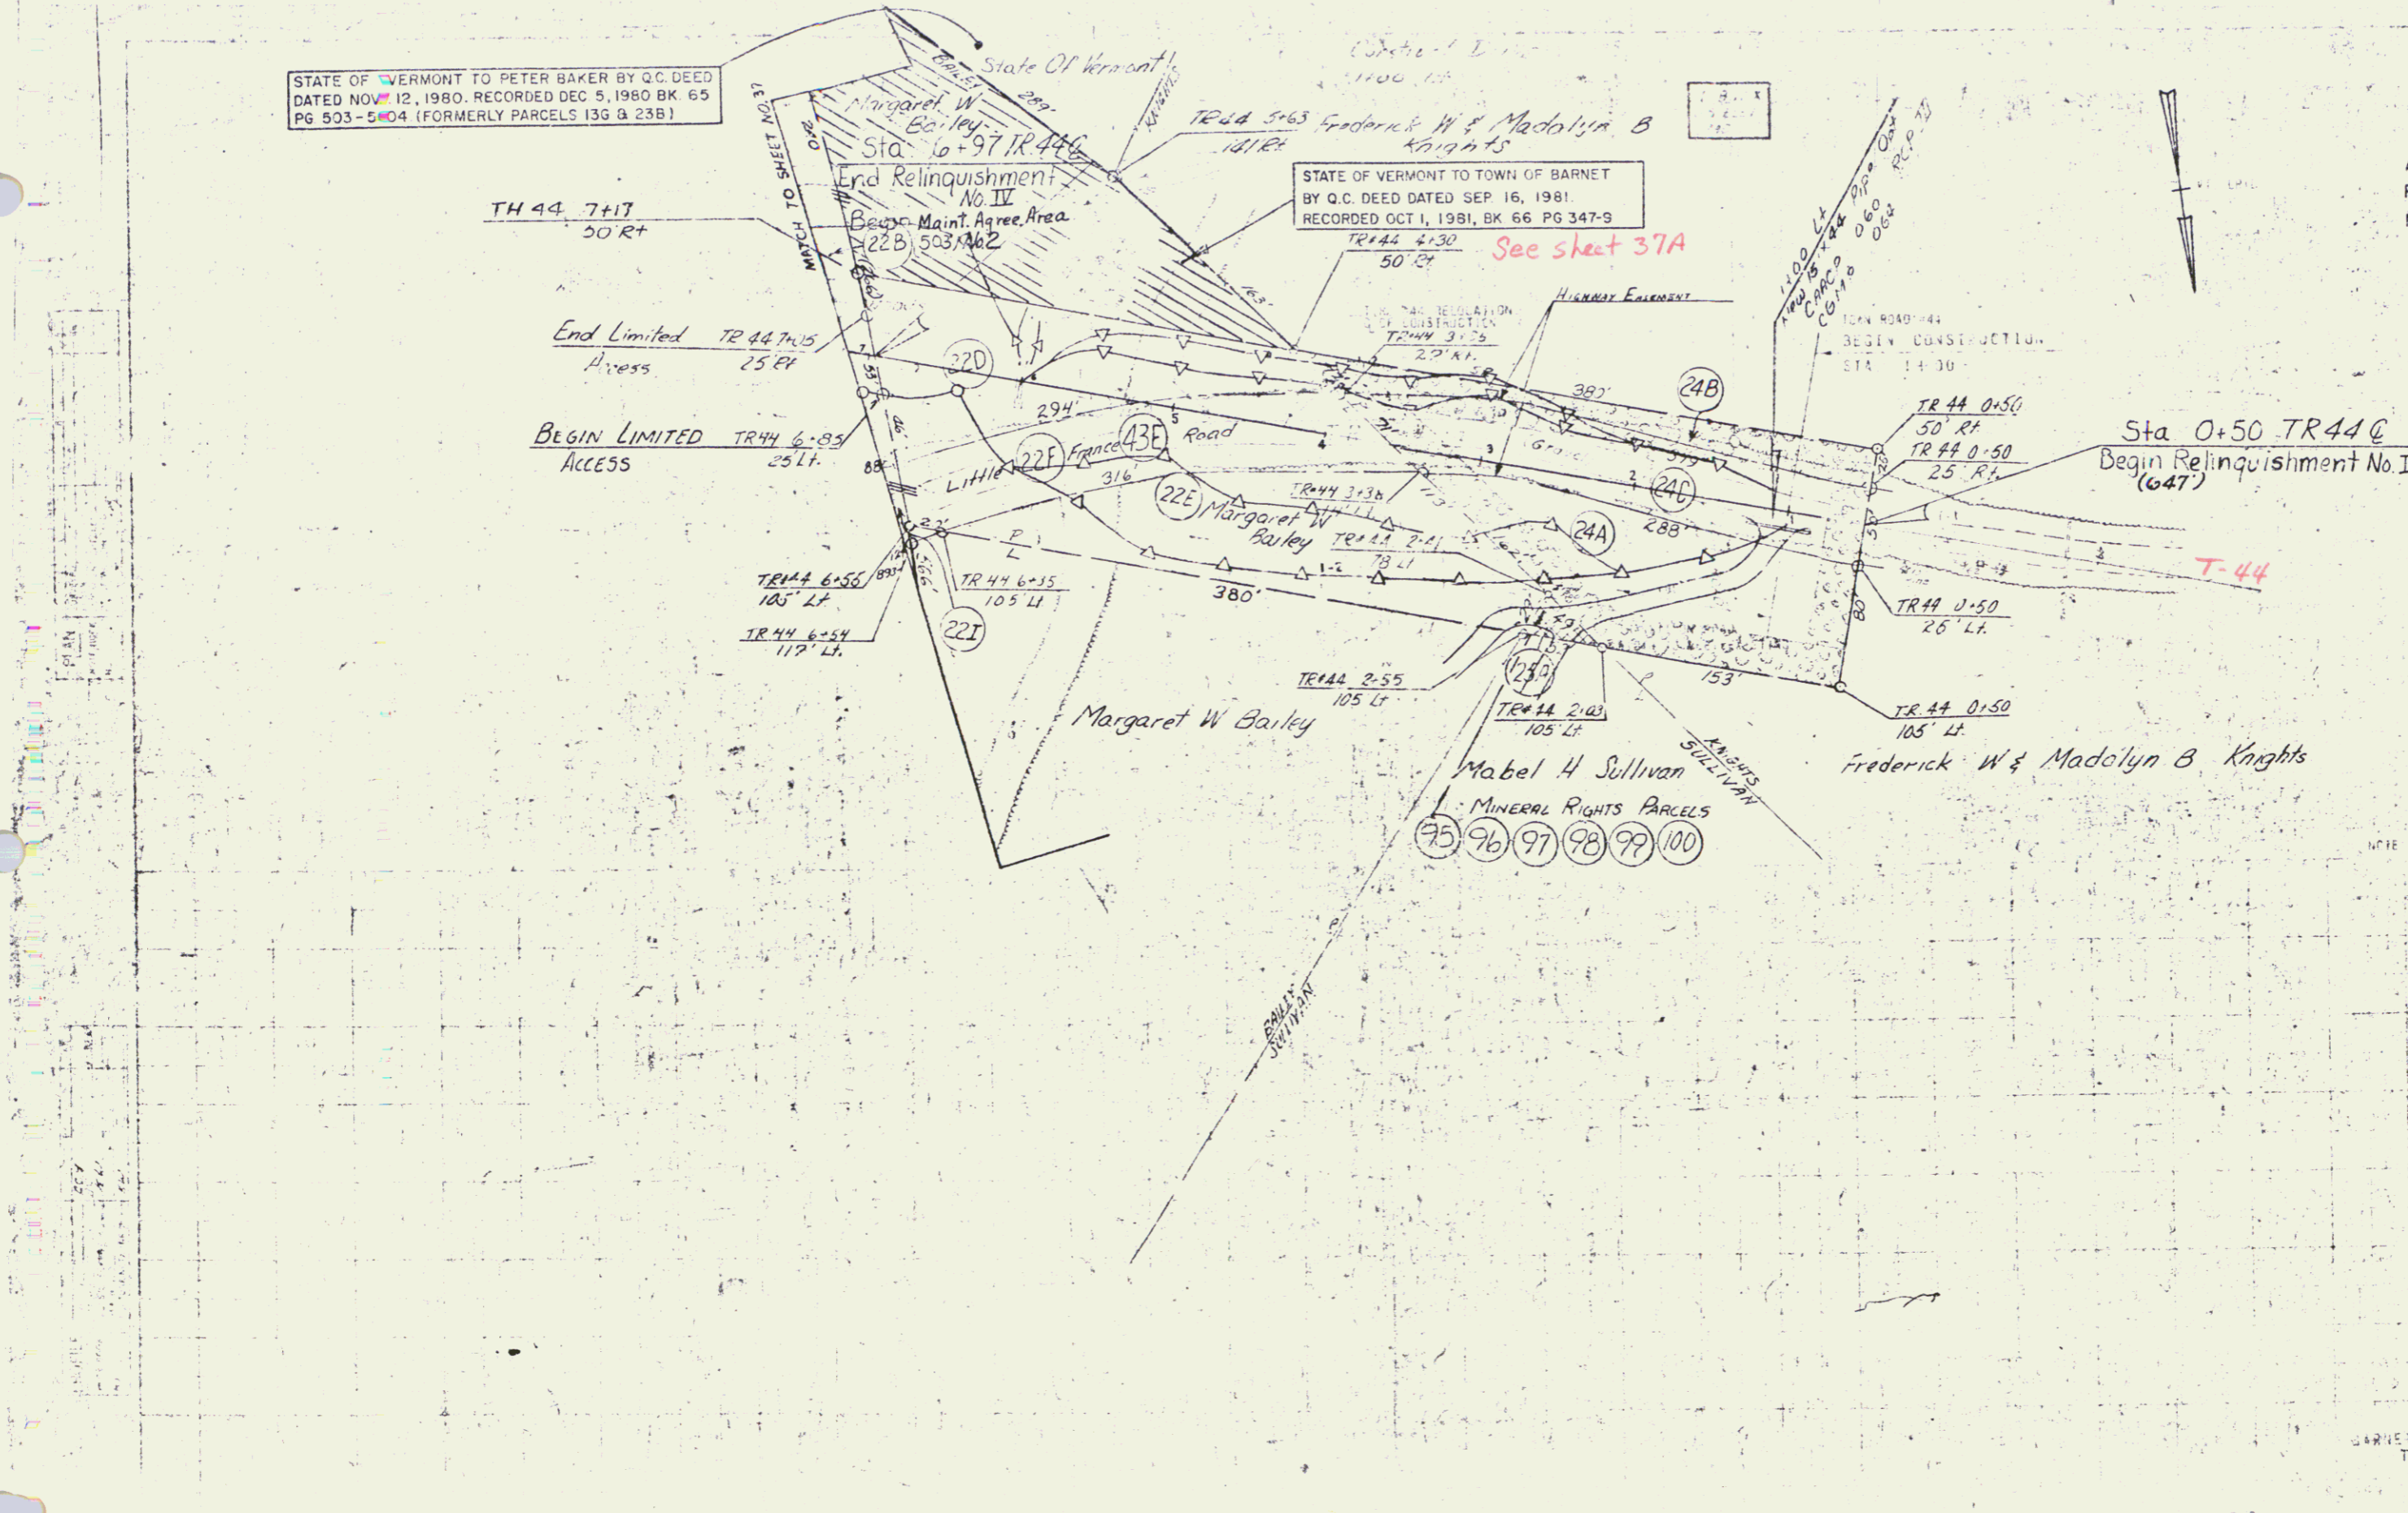

POOR ORIGINAL COPY

38