


62+75 Rt

Leigh B. & Beverly M. Larocque

Δ 13' 00" Lt  
D 4'  
R 1452'  
T 185'  
L 3288'  
E 9.98'

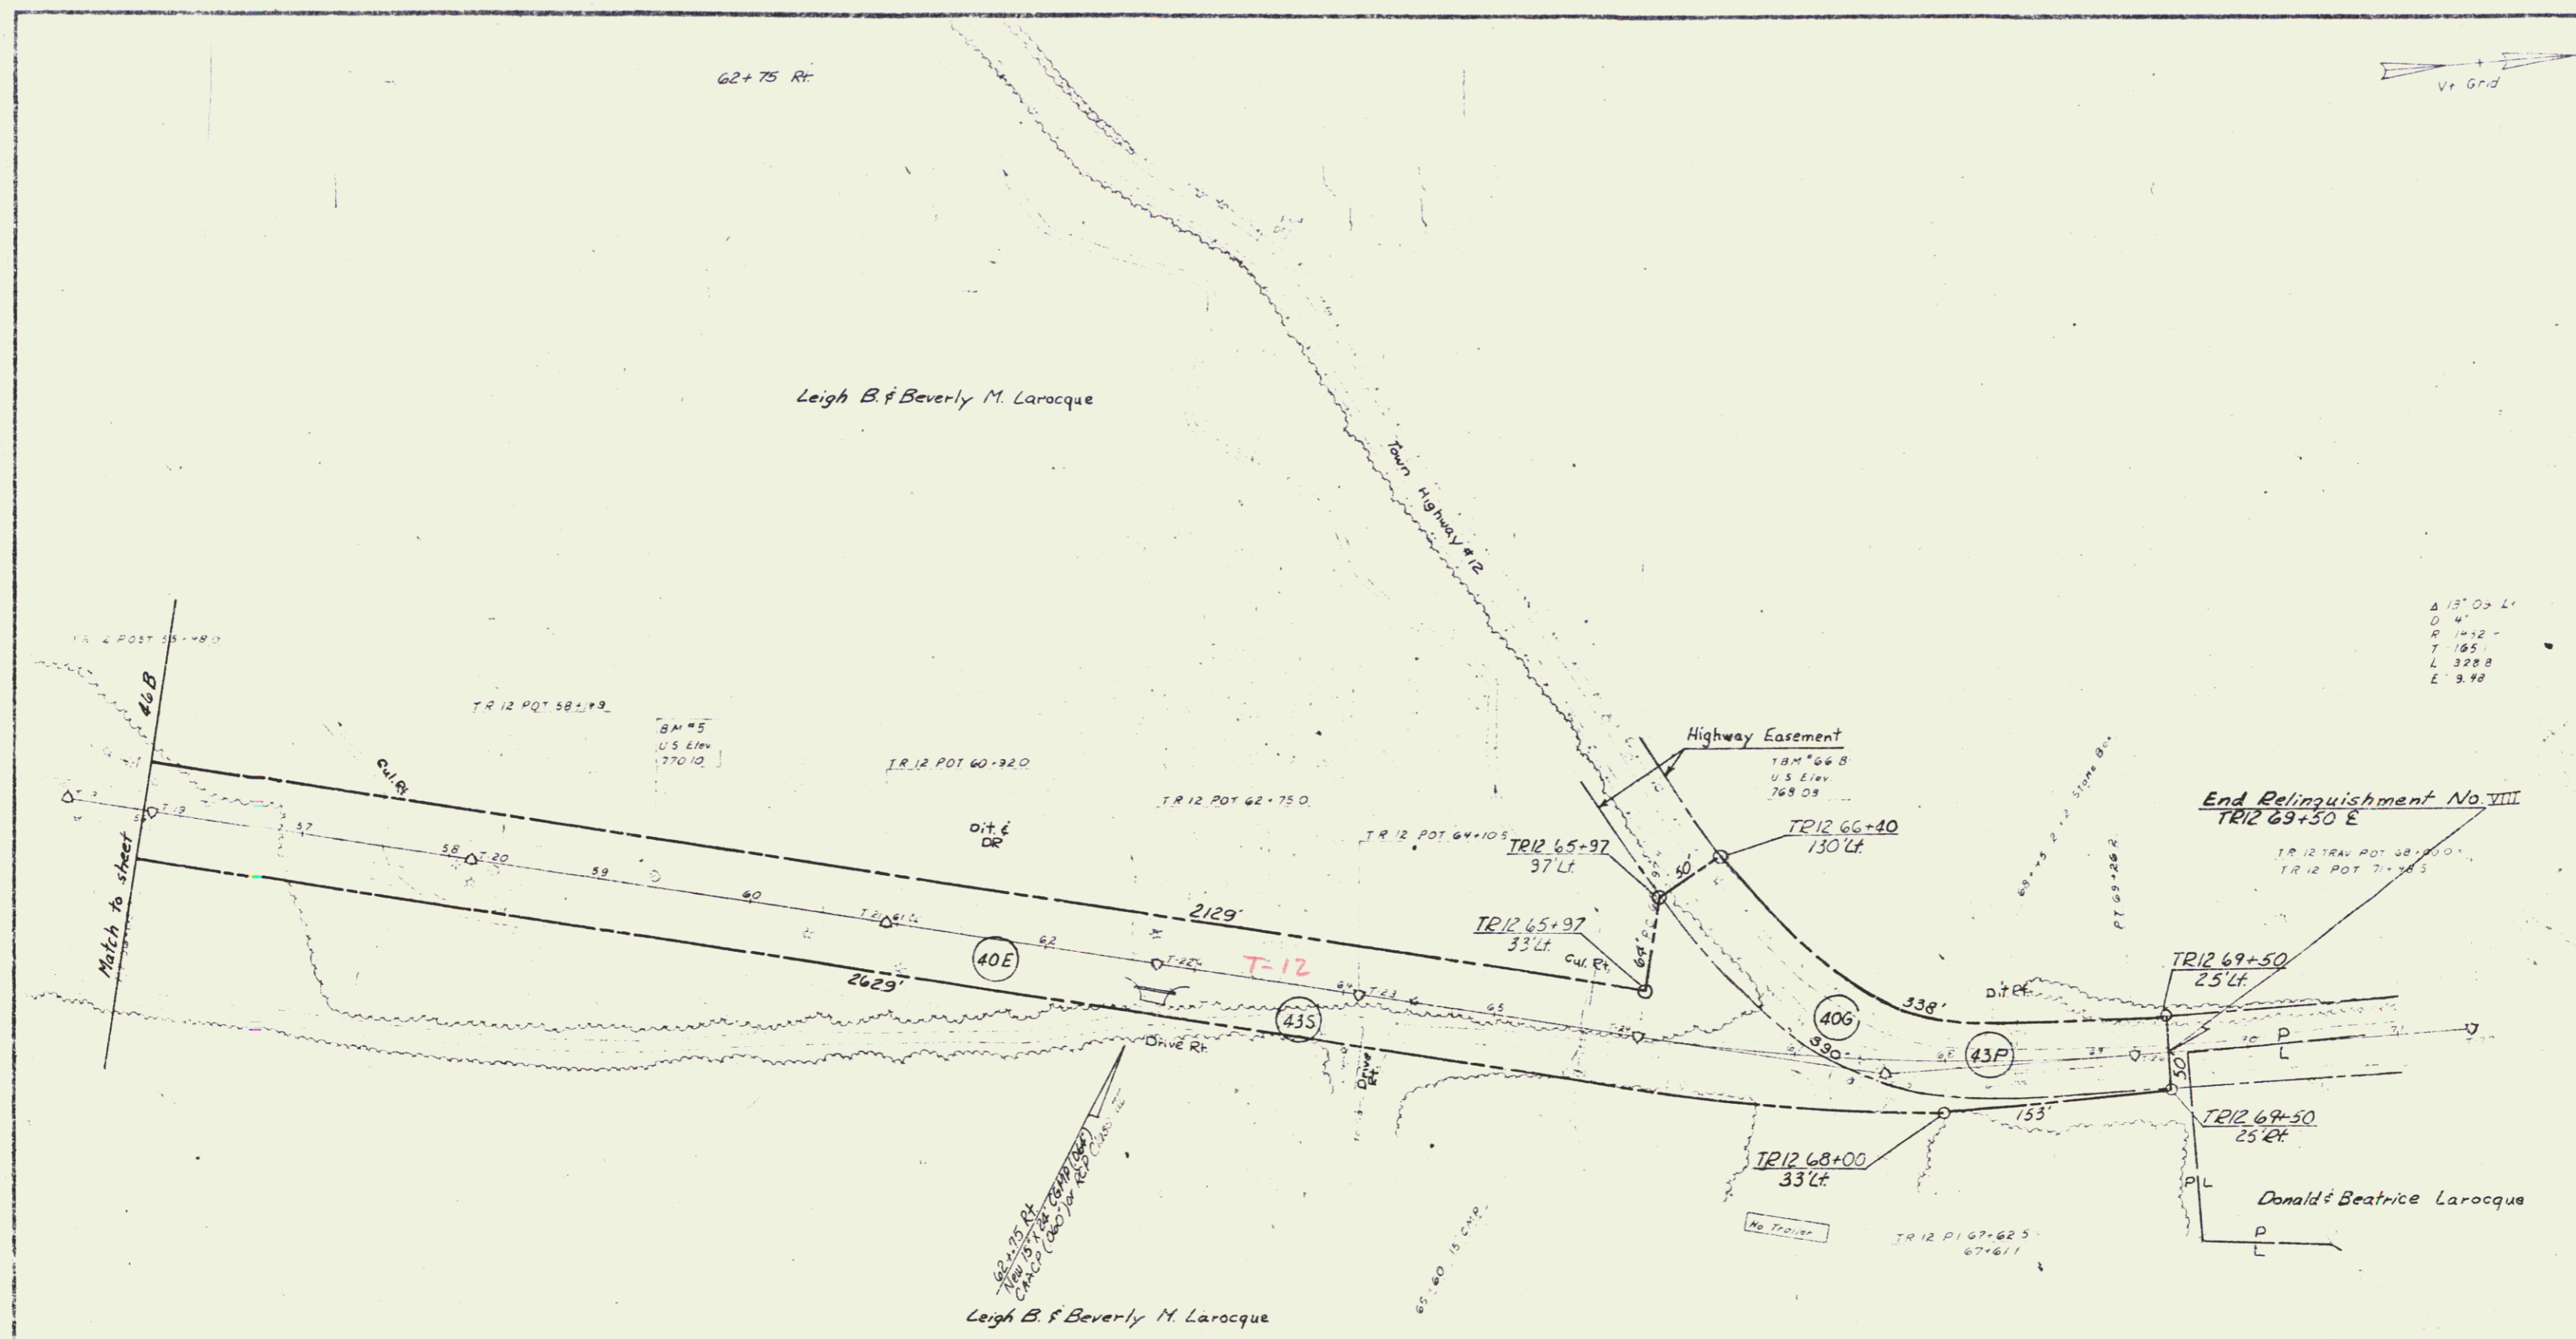

ALL DRIVES AS INDICATED ON  
PLANS ARE SUBJECT TO PERMITS  
PURSUANT TO TITLE 19,  
SECTION 43, V.S.A.

CONTRACT 2

Product 300000

SURVEYED BY: \_\_\_\_\_ DATE: \_\_\_\_\_

DRAWN BY: \_\_\_\_\_ DATE: \_\_\_\_\_

TRACED BY: \_\_\_\_\_ DATE: \_\_\_\_\_

PROJ. 1 No. 91-2121 Sect II

SHEET 46C of 151

D-7

JAN 10 1984 36