


DRILLING & BLASTING OF SOLID
ROCK SUBGRADE ITEM 20610
NB 6661125-6663125

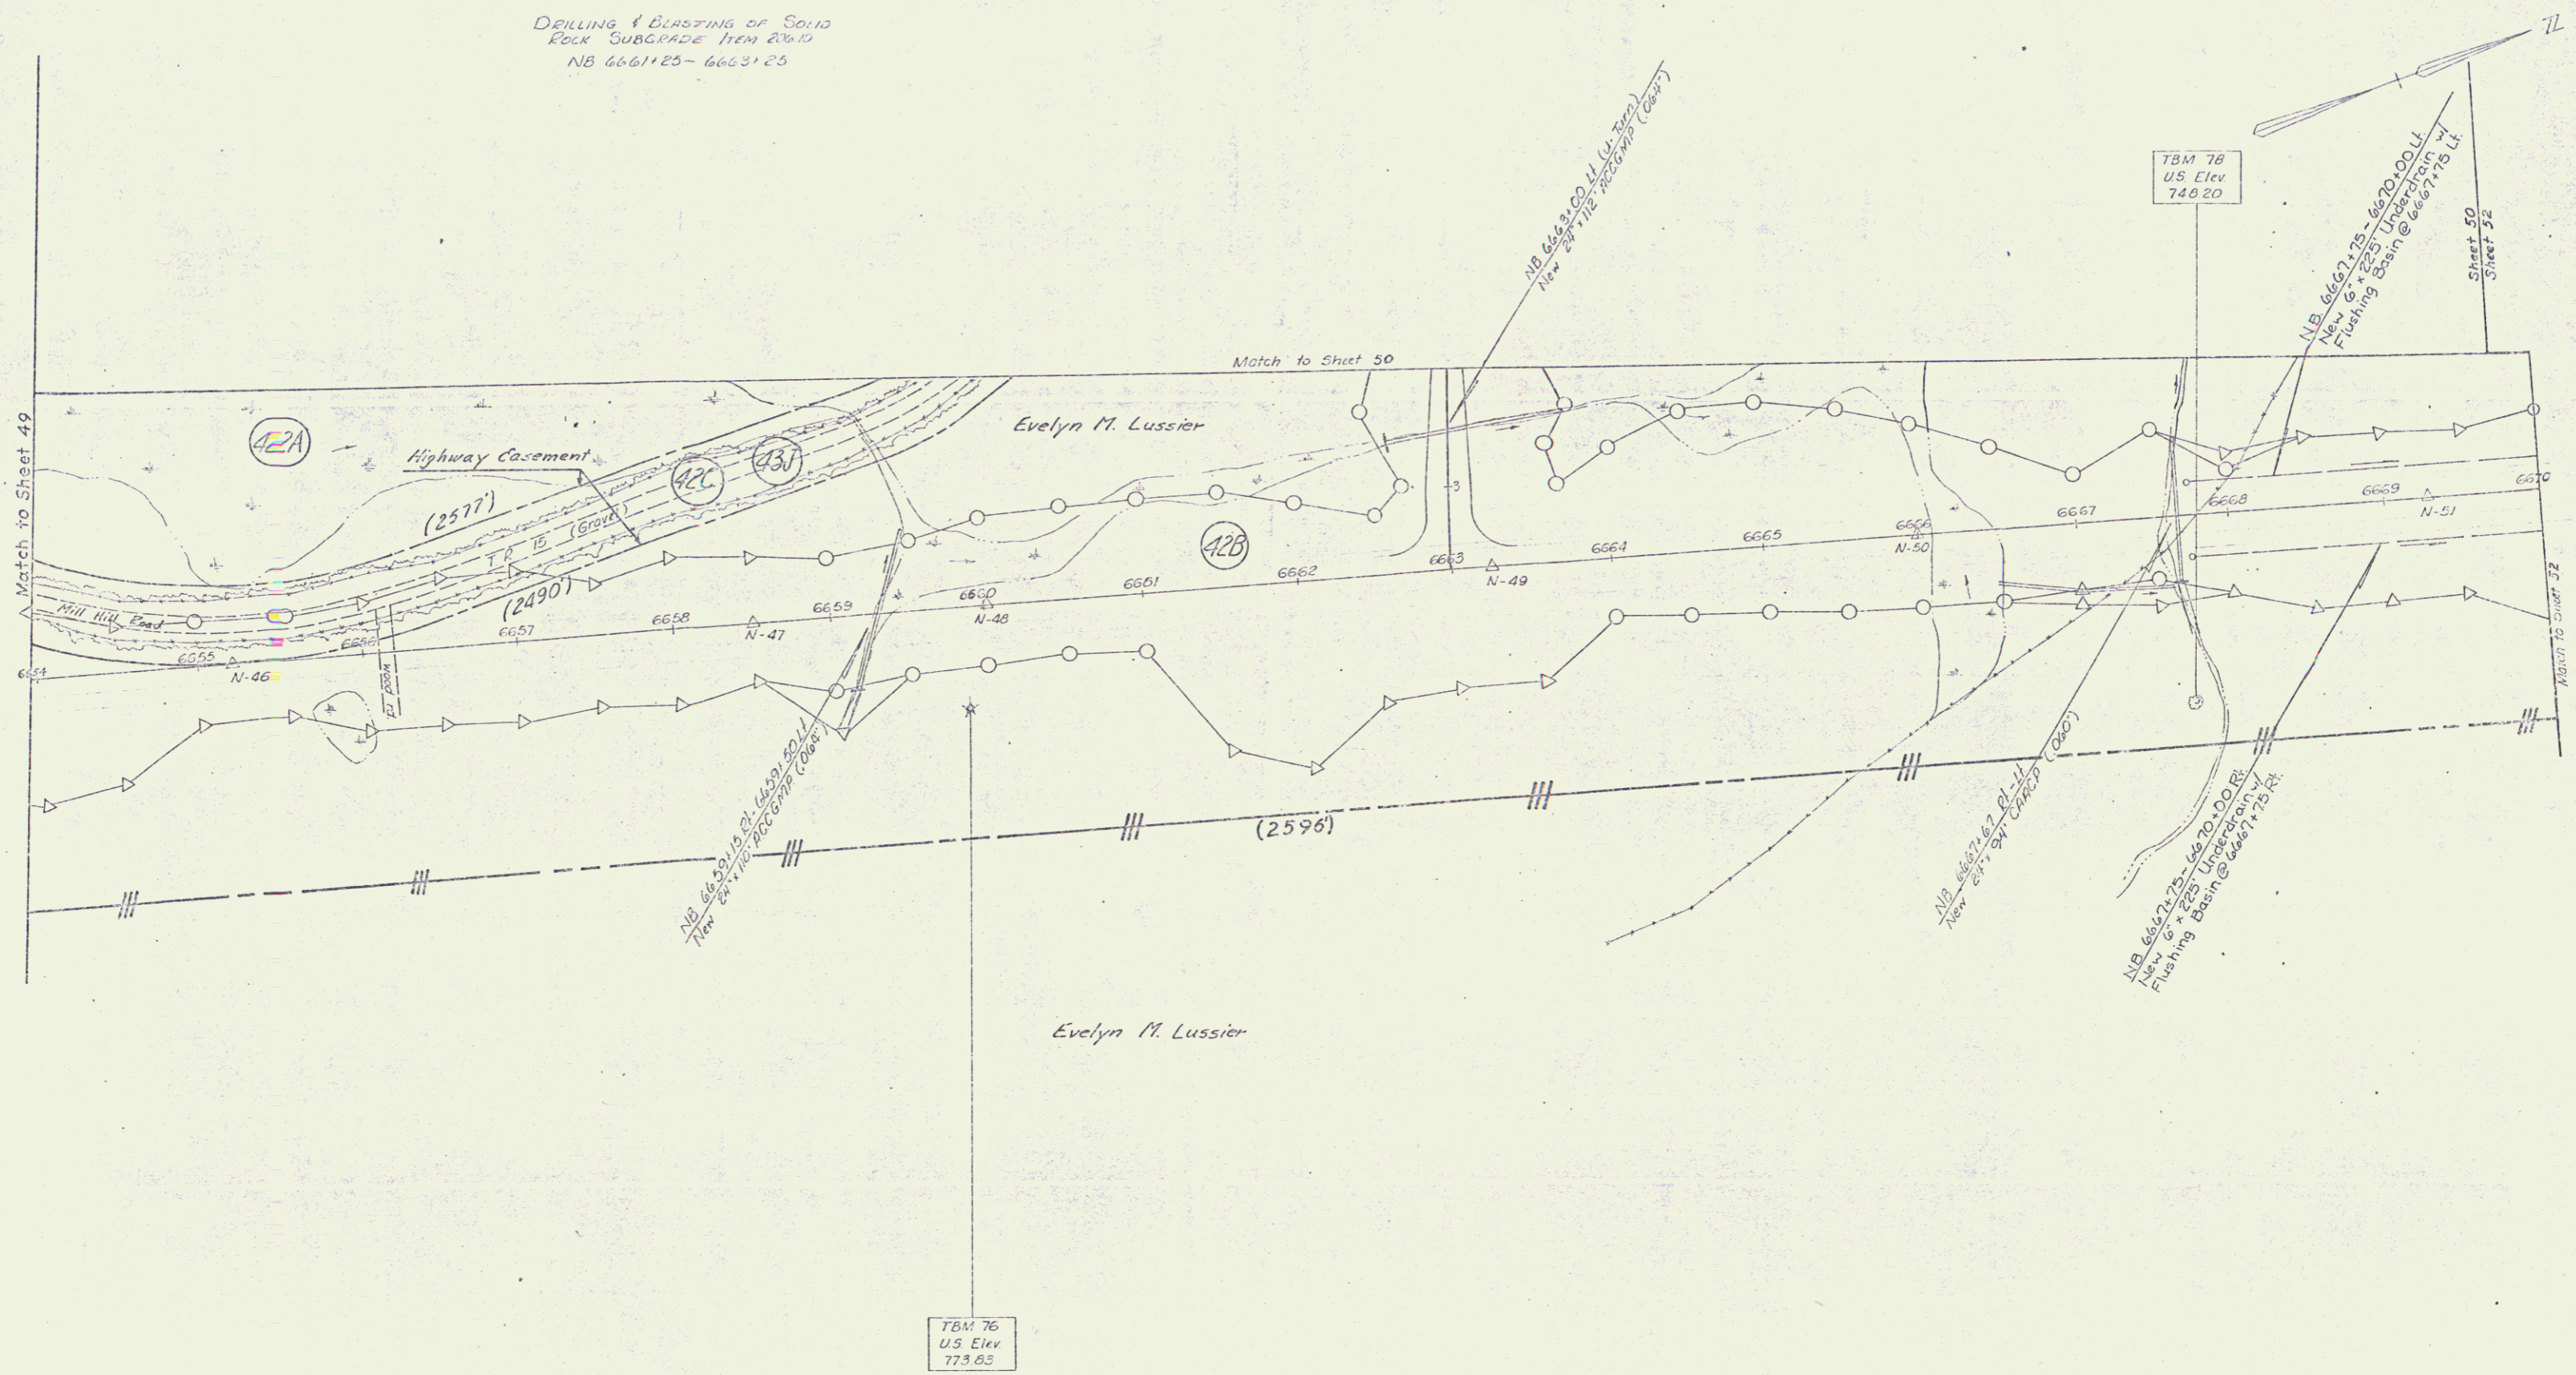

BARNET - ST. JOHNSBURY

SURVEYED BY	DATE
DRAWN BY	DATE
TRACED BY	DATE
PROJ. 7	No. 91-2 (21) Sect. 3
SHEET 51	of 151