



ALL DRIVES AS INDICATED ON PLANS ARE SUBJECT TO PERMITS PURSUANT TO TITLE 19, SECTION 43, V.S.A.

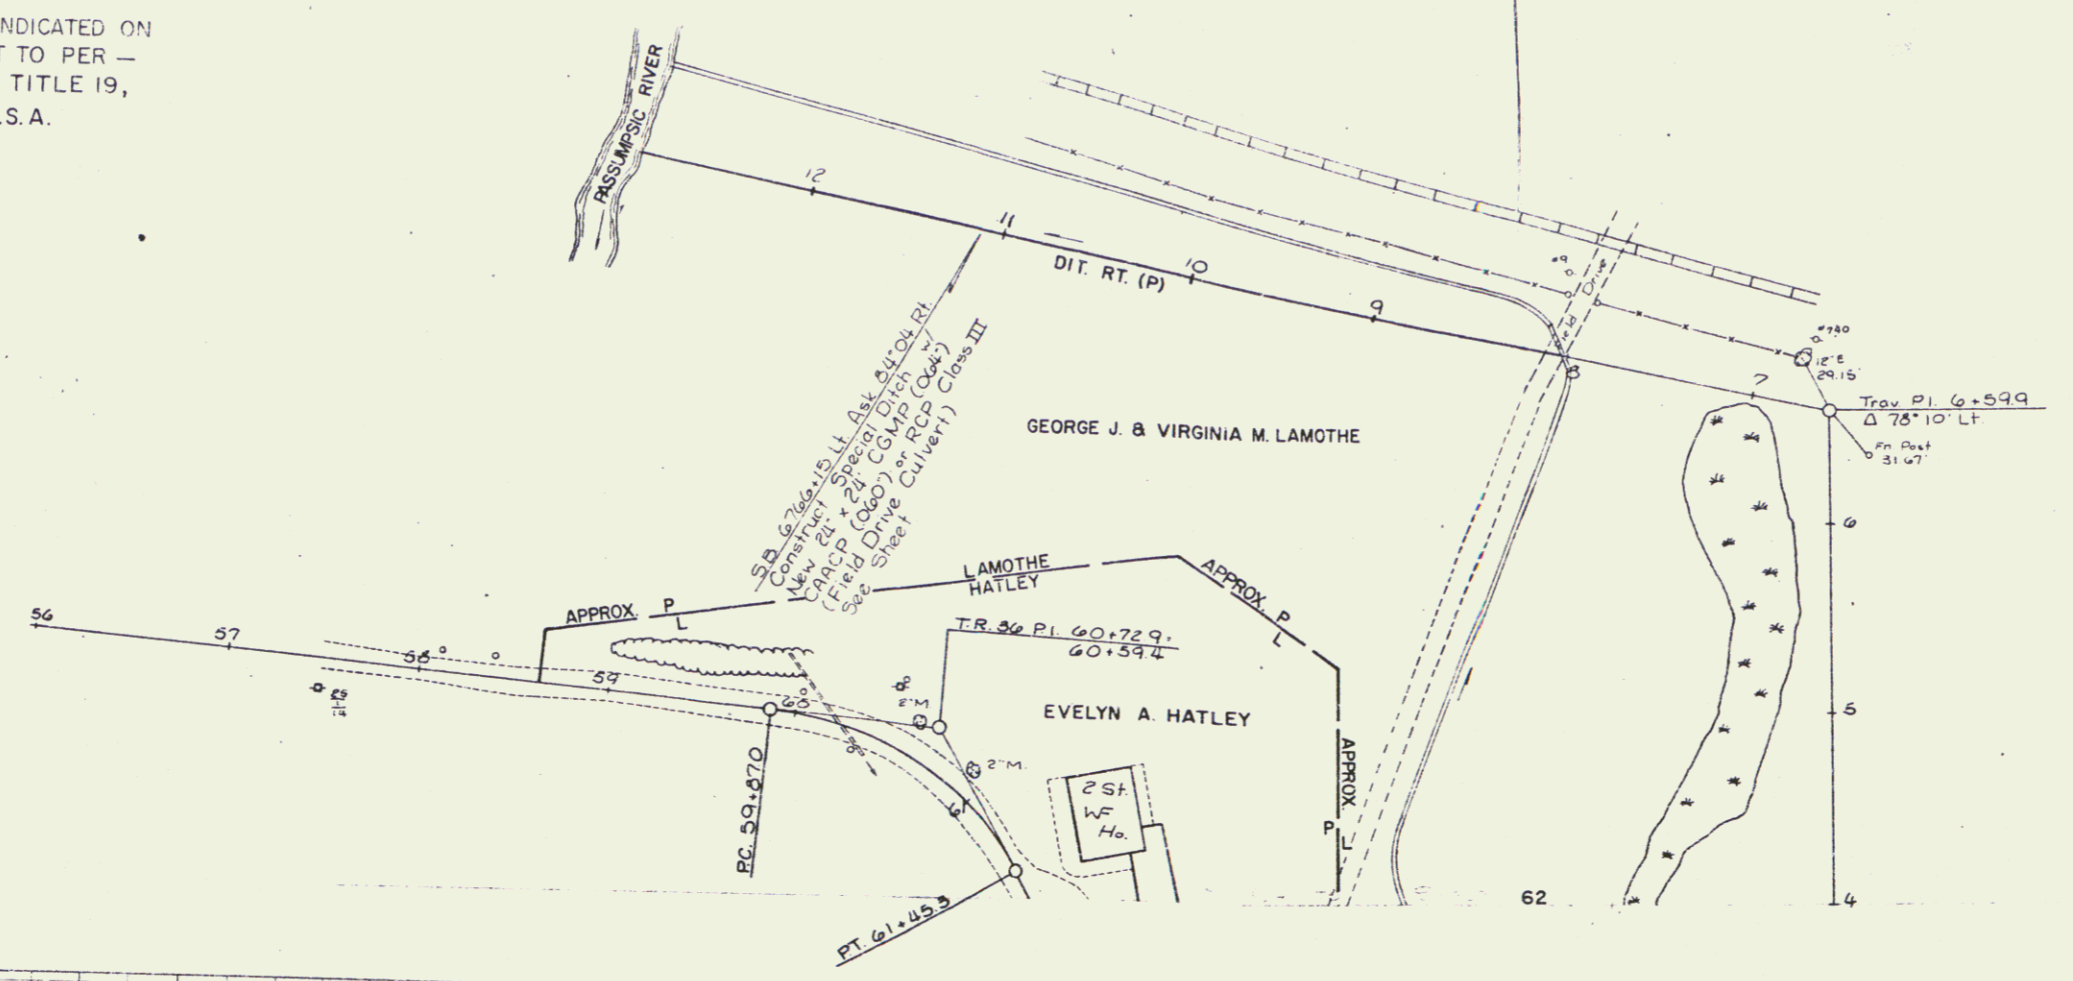

PLAN	SURVEYED	BY	DATE
REPORTED CHECKED			
NO. 27			
NO. 28			



PROFILE	SURVEYED	BY	DATE
REPORTED CHECKED			
NO. 27			
NO. 28			

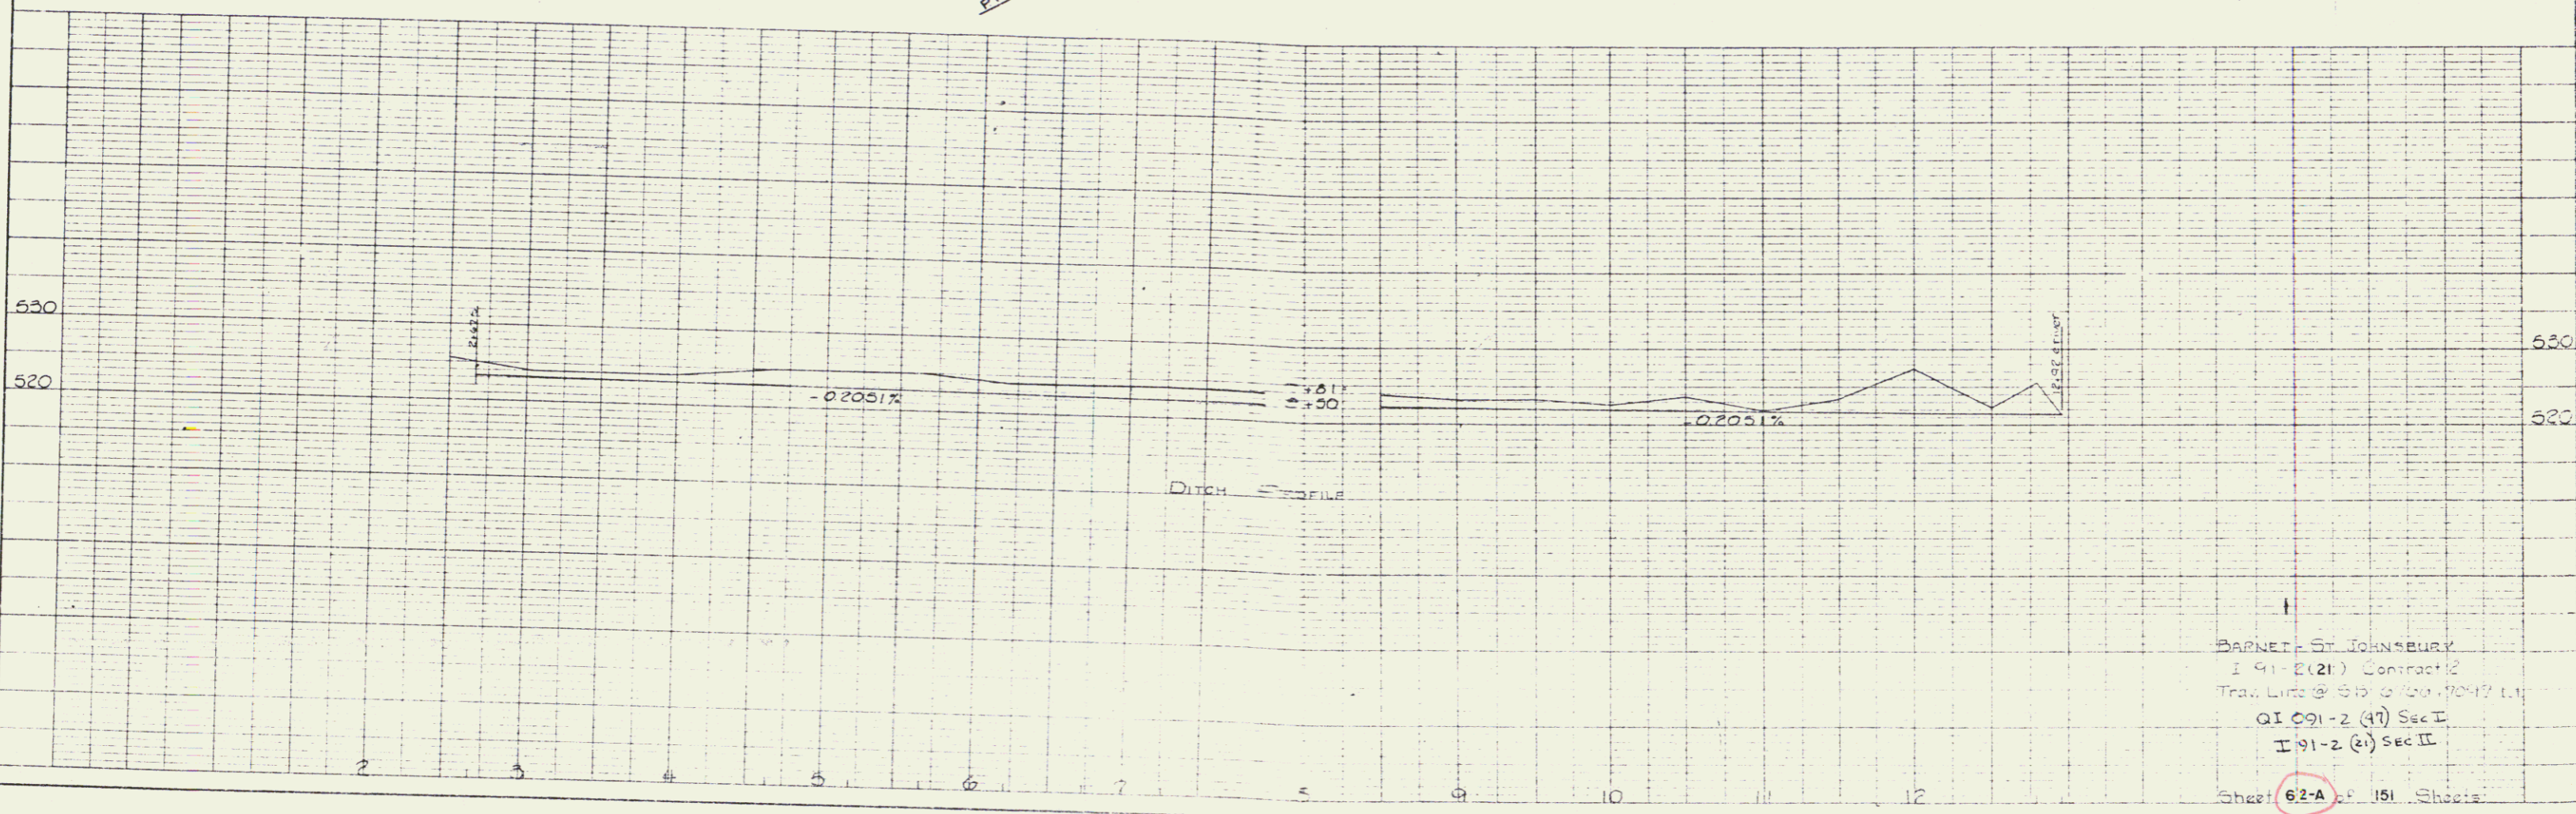

BARNETT ST. JOHNSBURY
 I 91-2(21) Contract 12
 Trac. Line @ 515.0' to 704.7' L.L.
 Q1 091-2 (47) Sec I
 I 91-2 (21) Sec II
 Sheet 62-A of 151 Sheets

PLAN PROFILE
 1/2" = 100'

JAN 10 1984

59