


POOR ORIGINAL COPY

Sta 54+00  
Begin Relinquishment No 2  
(687)



ALL DRIVES AS INDICATED ON PLANS ARE SUBJECT TO PERMITS PURSUANT TO TITLE 19, SECTION 43, V.S.A.

TOWN ROAD 168

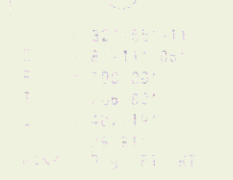

NOTE: T.B. 168 IS TO BE BUILT IN ITS ENTIRETY DURING STAGE 1 CONSTRUCTION.  
NOTE: FOR R.C. TIES SEE TIE SHEET NO.

STATE OF VERMONT  
DEPARTMENT OF HIGHWAYS

TOWN OF [unclear]  
ROUTE NO. [unclear] STA. [unclear]

CONTRACT NO. [unclear]

STAGE CONSTRUCTION NO. [unclear]

51 177

18