


RAMP E TO N		RAMP E TO S	
Δ	179°-47'-00"	Δ	37°-01'-23"
Dc	20°-50'-13"	Dc	4°-05'-33"
P	274.97'	R	1400.00'
L	862.81'	T	469.74'
E	75.38'	L	881.65'
BANK	1" FT RT	E	75.38'
		BANK	3/4" FT RT @ 11'

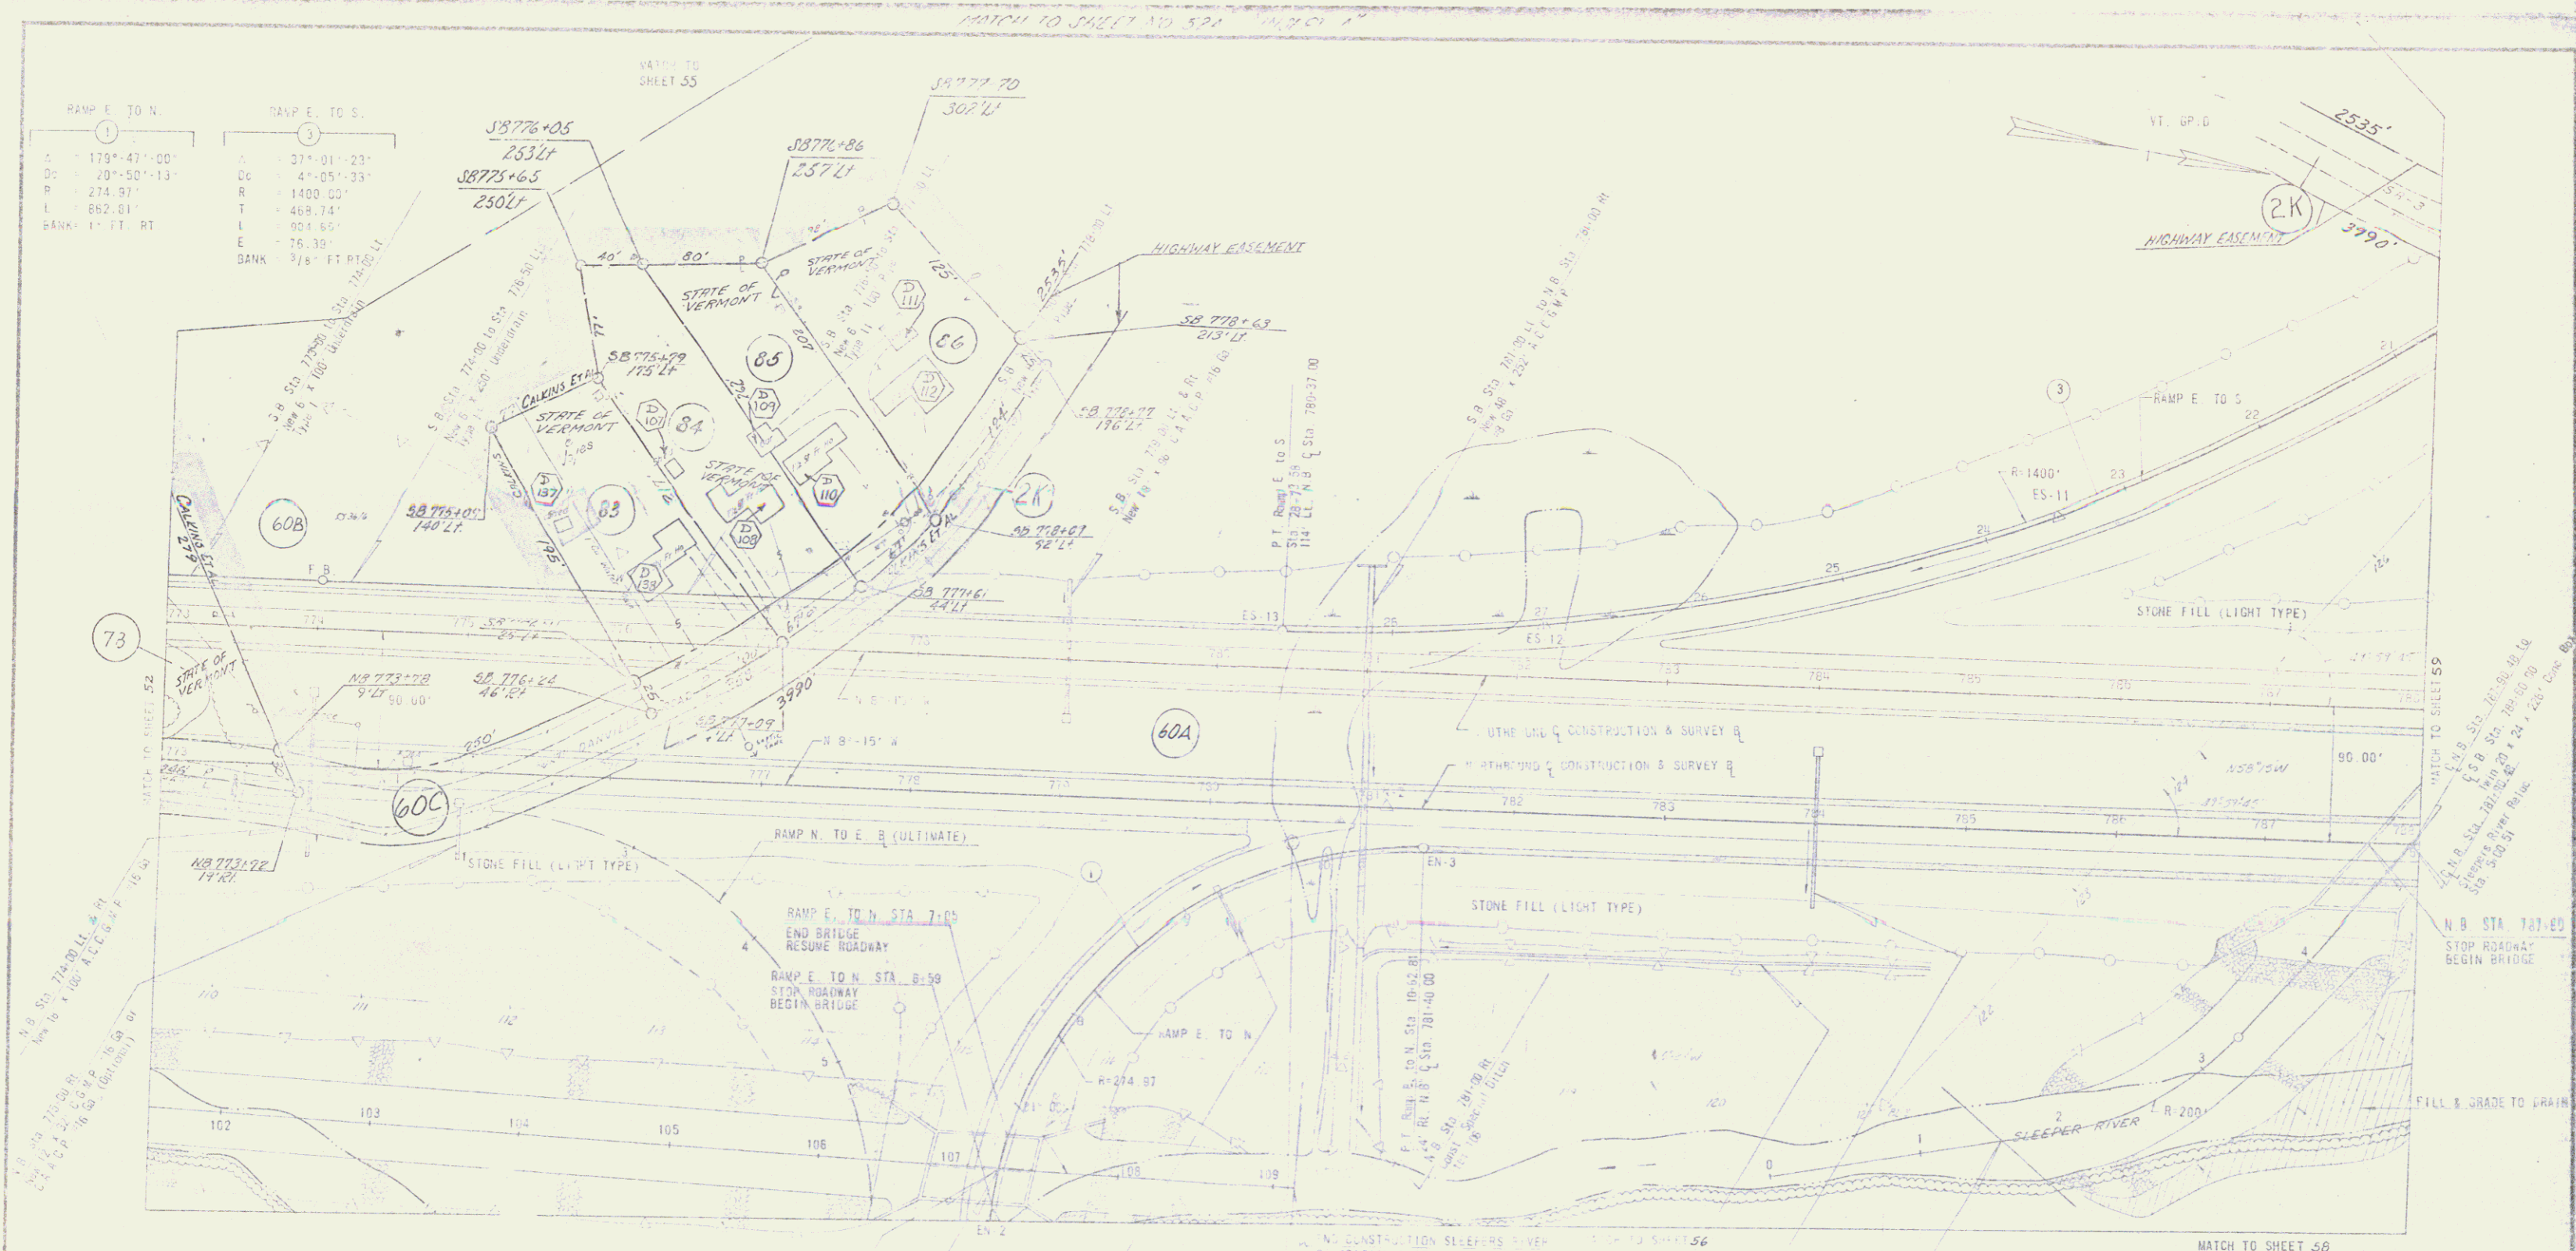

**POOR ORIGINAL COPY**

STATE OF VERMONT  
DEPARTMENT OF HIGHWAYS

TOWN OF ...

ROUTE NO. ... STA. ...

CONTRACT ...

STATE CONTRACT ...

Scale: 1" = 100'