


MATCH TO SHEET NO. 52A "INSERT B"

MATCH TO SHEET NO. 52A "INSERT C"

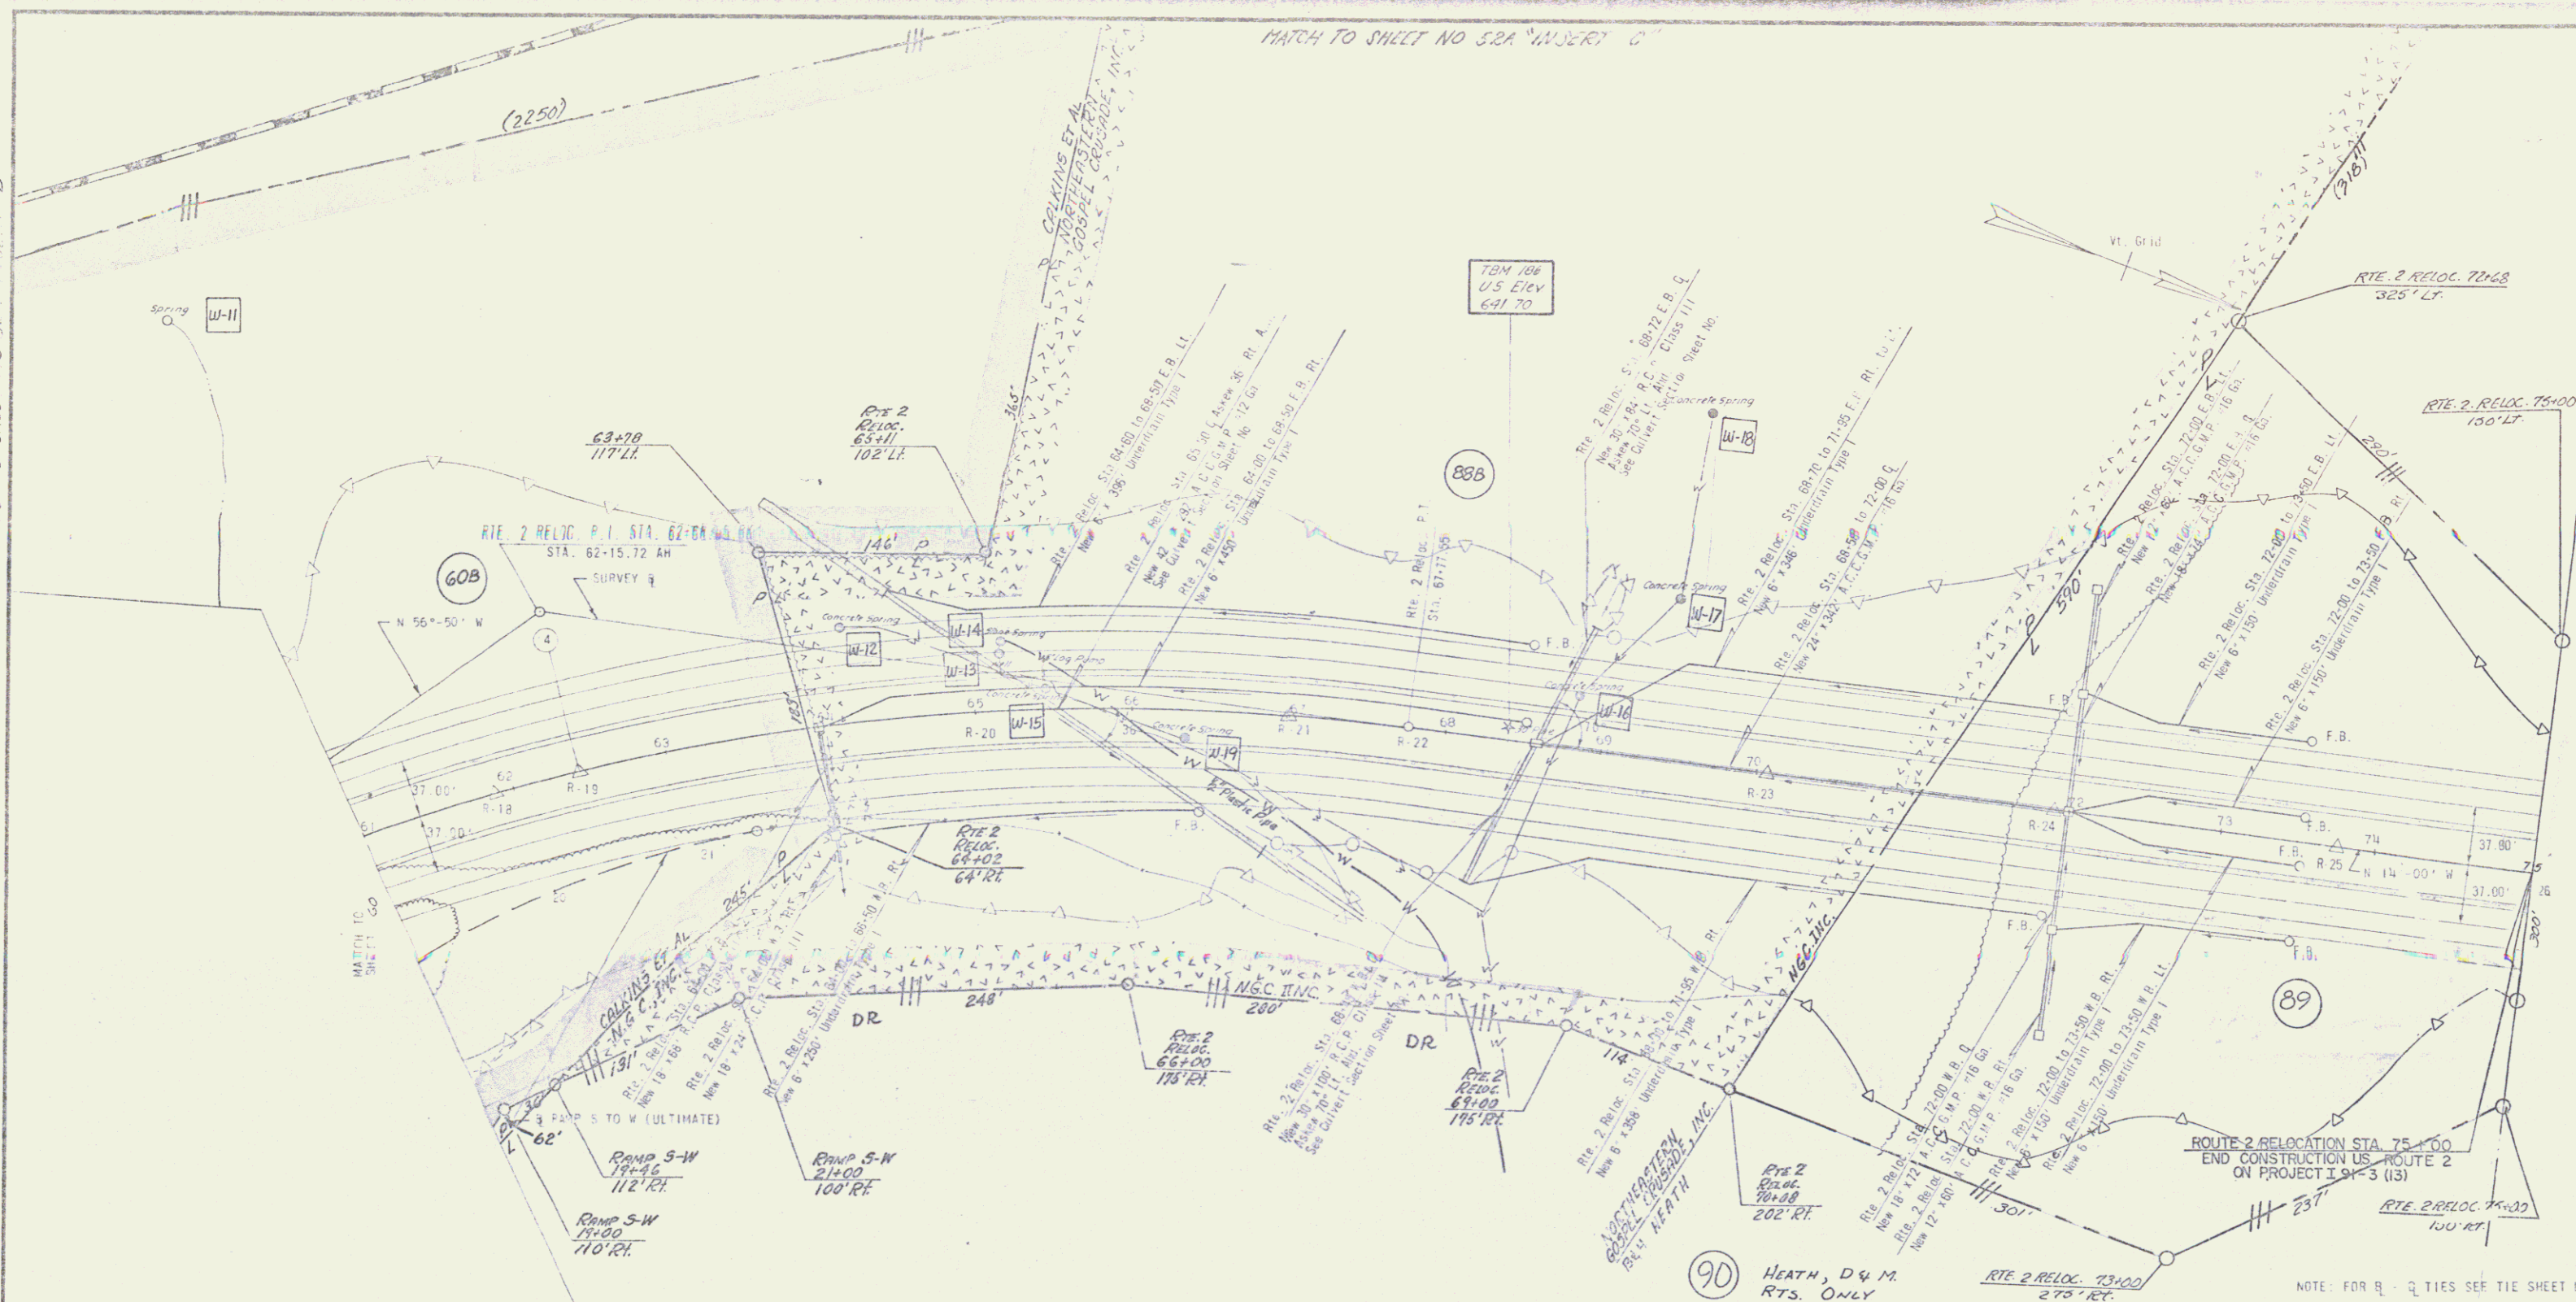

ROUTE #2

+	421.50' 00"
DC	4.00' 00"
RT	143' 40"
TL	581.93'
CL	1070.83'
BANK	108.74'
	7' 8" FT. RT.

JUTE MATTING ITEM 623  
 RTE. 2 RELOC. STA. 61+00 TO 63+00 MED.  
 RTE. 2 RELOC. STA. 64+00 TO 65+00 E.B. LT.  
 RTE. 2 RELOC. STA. 64+00 TO 65+00 MED.  
 RTE. 2 RELOC. STA. 64+00 TO 67+00 E.B. LT.

STONE FILL FOR SLOPE PROTECTION (LIGHT TYPE)  
 ITEM 512  
 RTE. 2 RELOC. STA. 63+80 TO 64+58 F.B. LT.

STANDARD STEEL BEAM GUARD RAIL & STEEL POSTS  
 ITEM 545-A  
 RTE. 2 RELOC. STA. 67+00 TO 68+50 W.B. RT.

ROUTE 2 RELOCATION IS TO BE BUILT IN ITS ENTIRETY DURING STAGE 1 CONSTRUCTION, EXCEPT 1' 4" HEARING COURSE.

90 HEATH, D & M. RTS. ONLY

NOTE: FOR R & Q TIES SEE TIE SHEET NO.

STATE OF VERMONT  
 DEPARTMENT OF HIGHWAYS

TOWN OF ST. JOHNSBURY  
 ROUTE No. 91 STA. 61+00 TO STA. 75+00  
 ROUTE 2 RELOCATION STA. 61+00 TO STA. 75+00

CONTRACT # 2  
 STAGE CONSTRUCTION I

PROJECT No. 1-91-31(3)  
 SHEET 61 OF 177

CLARKSON, CLARK AND YOKEL  
 ALBANY, NEW YORK