

STONE FILL FOR SLOPE PROTECTION (LIGHT TYPE)
ITEM 512
N.B. STA. 872+00 TO STA. 872+10 RT.

PLANK GUARD RAIL ITEM 540
S.B. STA. 876+20 LT.
N.B. STA. 885+50 RT.

CONTROL OF ACCESS IS COMPLETE
ON THIS SHEET.


BITUMINOUS CONCRETE CURB ITEM 555
S.B. STA. 871+30 TO STA. 874+00 LT.
N.R. STA. 872+00 TO STA. 875+00 LT.
S.B. STA. 877+00 TO STA. 881+00 RT.

JUTE MATTING ITEM 623
S.D. STA. 871+30 TO STA. 872+25 LT.
N.R. STA. 872+00 TO STA. 873+40 LT.
N.F. STA. 879+50 TO STA. 885+00 LT.

ALL DRIVES AS INDICATED ON
PLANS ARE SUBJECT TO PER-
MITS PURSUANT TO TITLE 19,
SECTION 43, V.S.A.

MATCH LINE TO SHEET 69A

VT. GRID

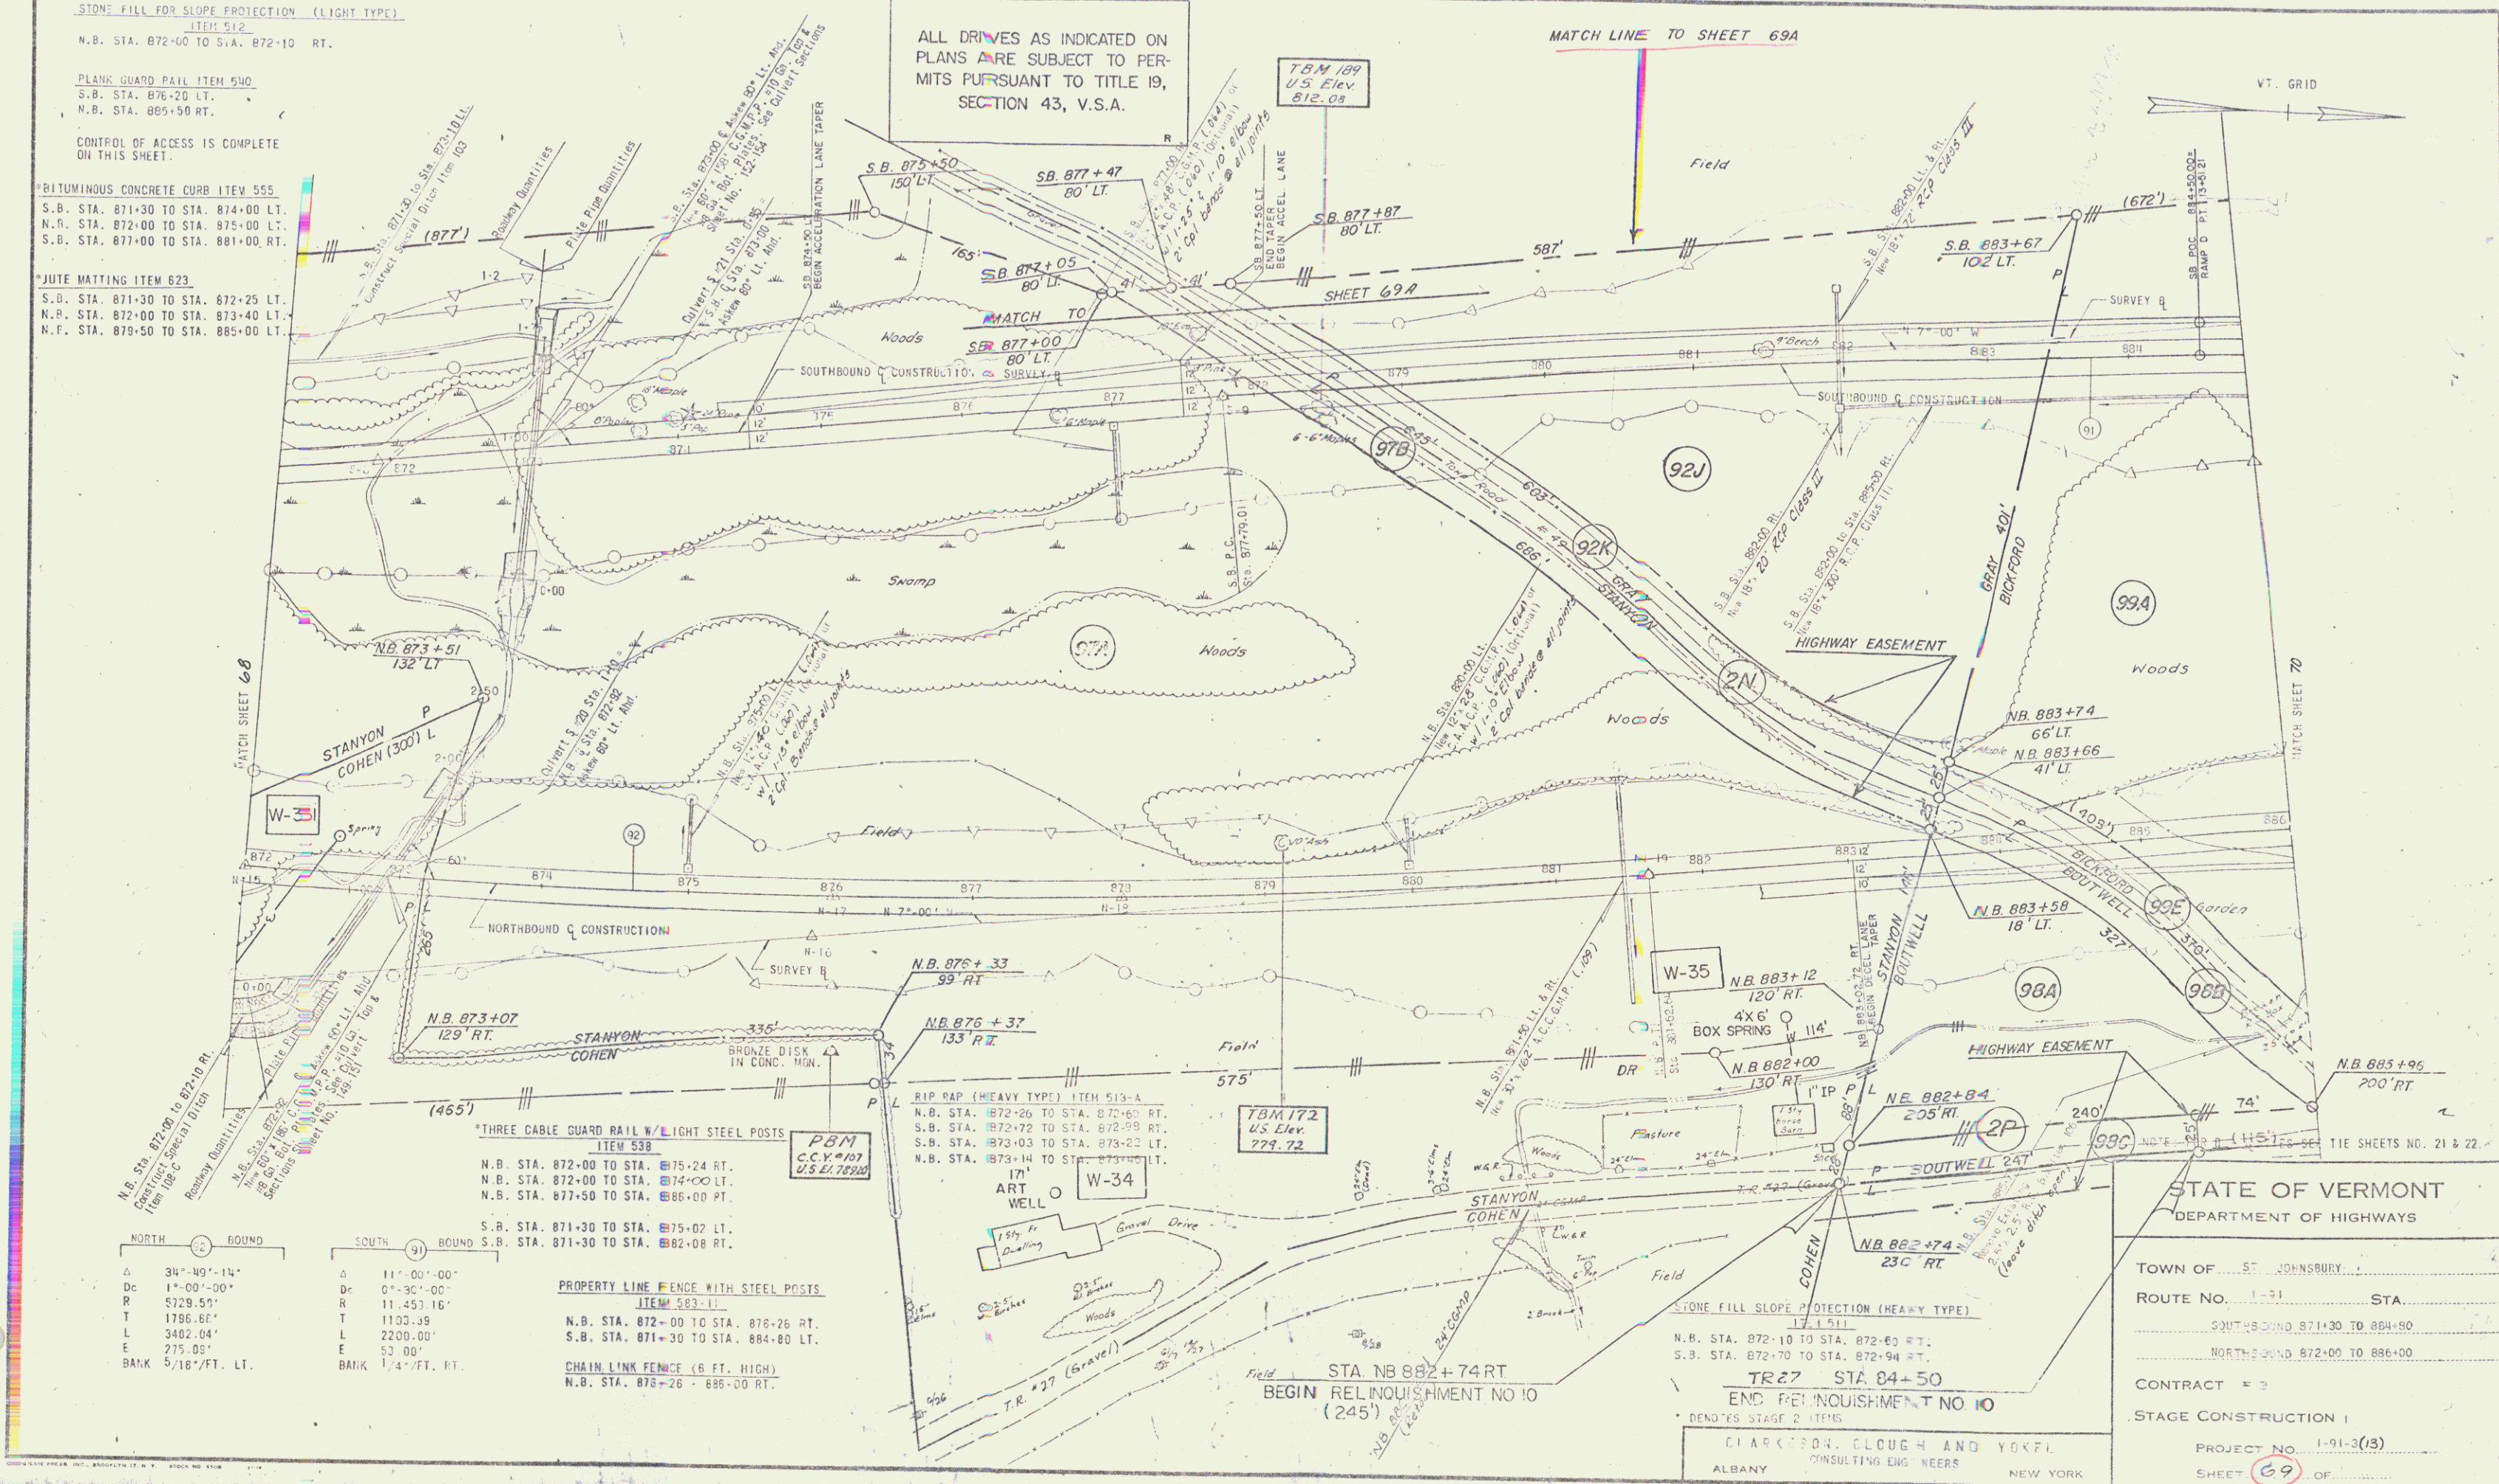

NORTH BOUND		SOUTH BOUND	
Δ	34°-09'-13"	Δ	11°-00'-00"
Dc	1°-00'-00"	Dc	0°-30'-00"
R	5729.55'	R	11,453.16'
T	1786.66'	T	1103.39'
L	3402.04'	L	2200.00'
E	275.86'	E	53.00'
BANK 5/16" FT. LT.		BANK 1/4" FT. RT.	

THREE CABLE GUARD RAIL W/ LIGHT STEEL POSTS
ITEM 538
N.B. STA. 872+00 TO STA. 875+24 RT.
N.B. STA. 872+00 TO STA. 874+00 LT.
N.B. STA. 877+50 TO STA. 886+00 RT.

PROPERTY LINE FENCE WITH STEEL POSTS
ITEM 583-11
N.B. STA. 872+00 TO STA. 876+26 RT.
S.B. STA. 871+30 TO STA. 884+80 LT.

CHAIN LINK FENCE (6 FT. HIGH)
N.B. STA. 875+26 - 885+00 RT.

STONE FILL SLOPE PROTECTION (HEAVY TYPE)
ITEM 511
N.B. STA. 872+10 TO STA. 872+60 RT.
S.B. STA. 872+70 TO STA. 872+94 RT.

CLARKSON, CLOUGH AND YOKEL
ALBANY CONSULTING ENGINEERS
NEW YORK

STATE OF VERMONT
DEPARTMENT OF HIGHWAYS

TOWN OF ST. JOHNSBURY

ROUTE NO. 1-91 STA.

SOUTH BOUND 871+30 TO 884+80
NORTH BOUND 872+00 TO 886+00

CONTRACT # 3

STAGE CONSTRUCTION I

PROJECT NO. 1-91-3(13)

SHEET 69 OF