


SOUTHBOUND		NORTHBOUND	
98	98	98	98
A = 8°-10'-01"	A = 44°-48'-52"	A = 39°-30'-00"	A = 39°-45'-00"
Dc = 0°-30'-00"	Dc = 1°-00'-00"	Dc = 0°-45'-00"	Dc = 0°-45'-00"
R = 11,459.16	R = 5729.58	R = 7633.44	R = 7633.44
T = 816.85	T = 232.41	T = 232.41	T = 232.41
L = 1033.38	L = 4481.44	L = 4481.44	L = 4481.44
E = 29.16	E = 467.92	E = 467.92	E = 467.92
BANK = 1/4" FT. LT.	BANK = 5/16" FT. RT.	BANK = 1/4" FT. RT.	BANK = 1/4" FT. RT.

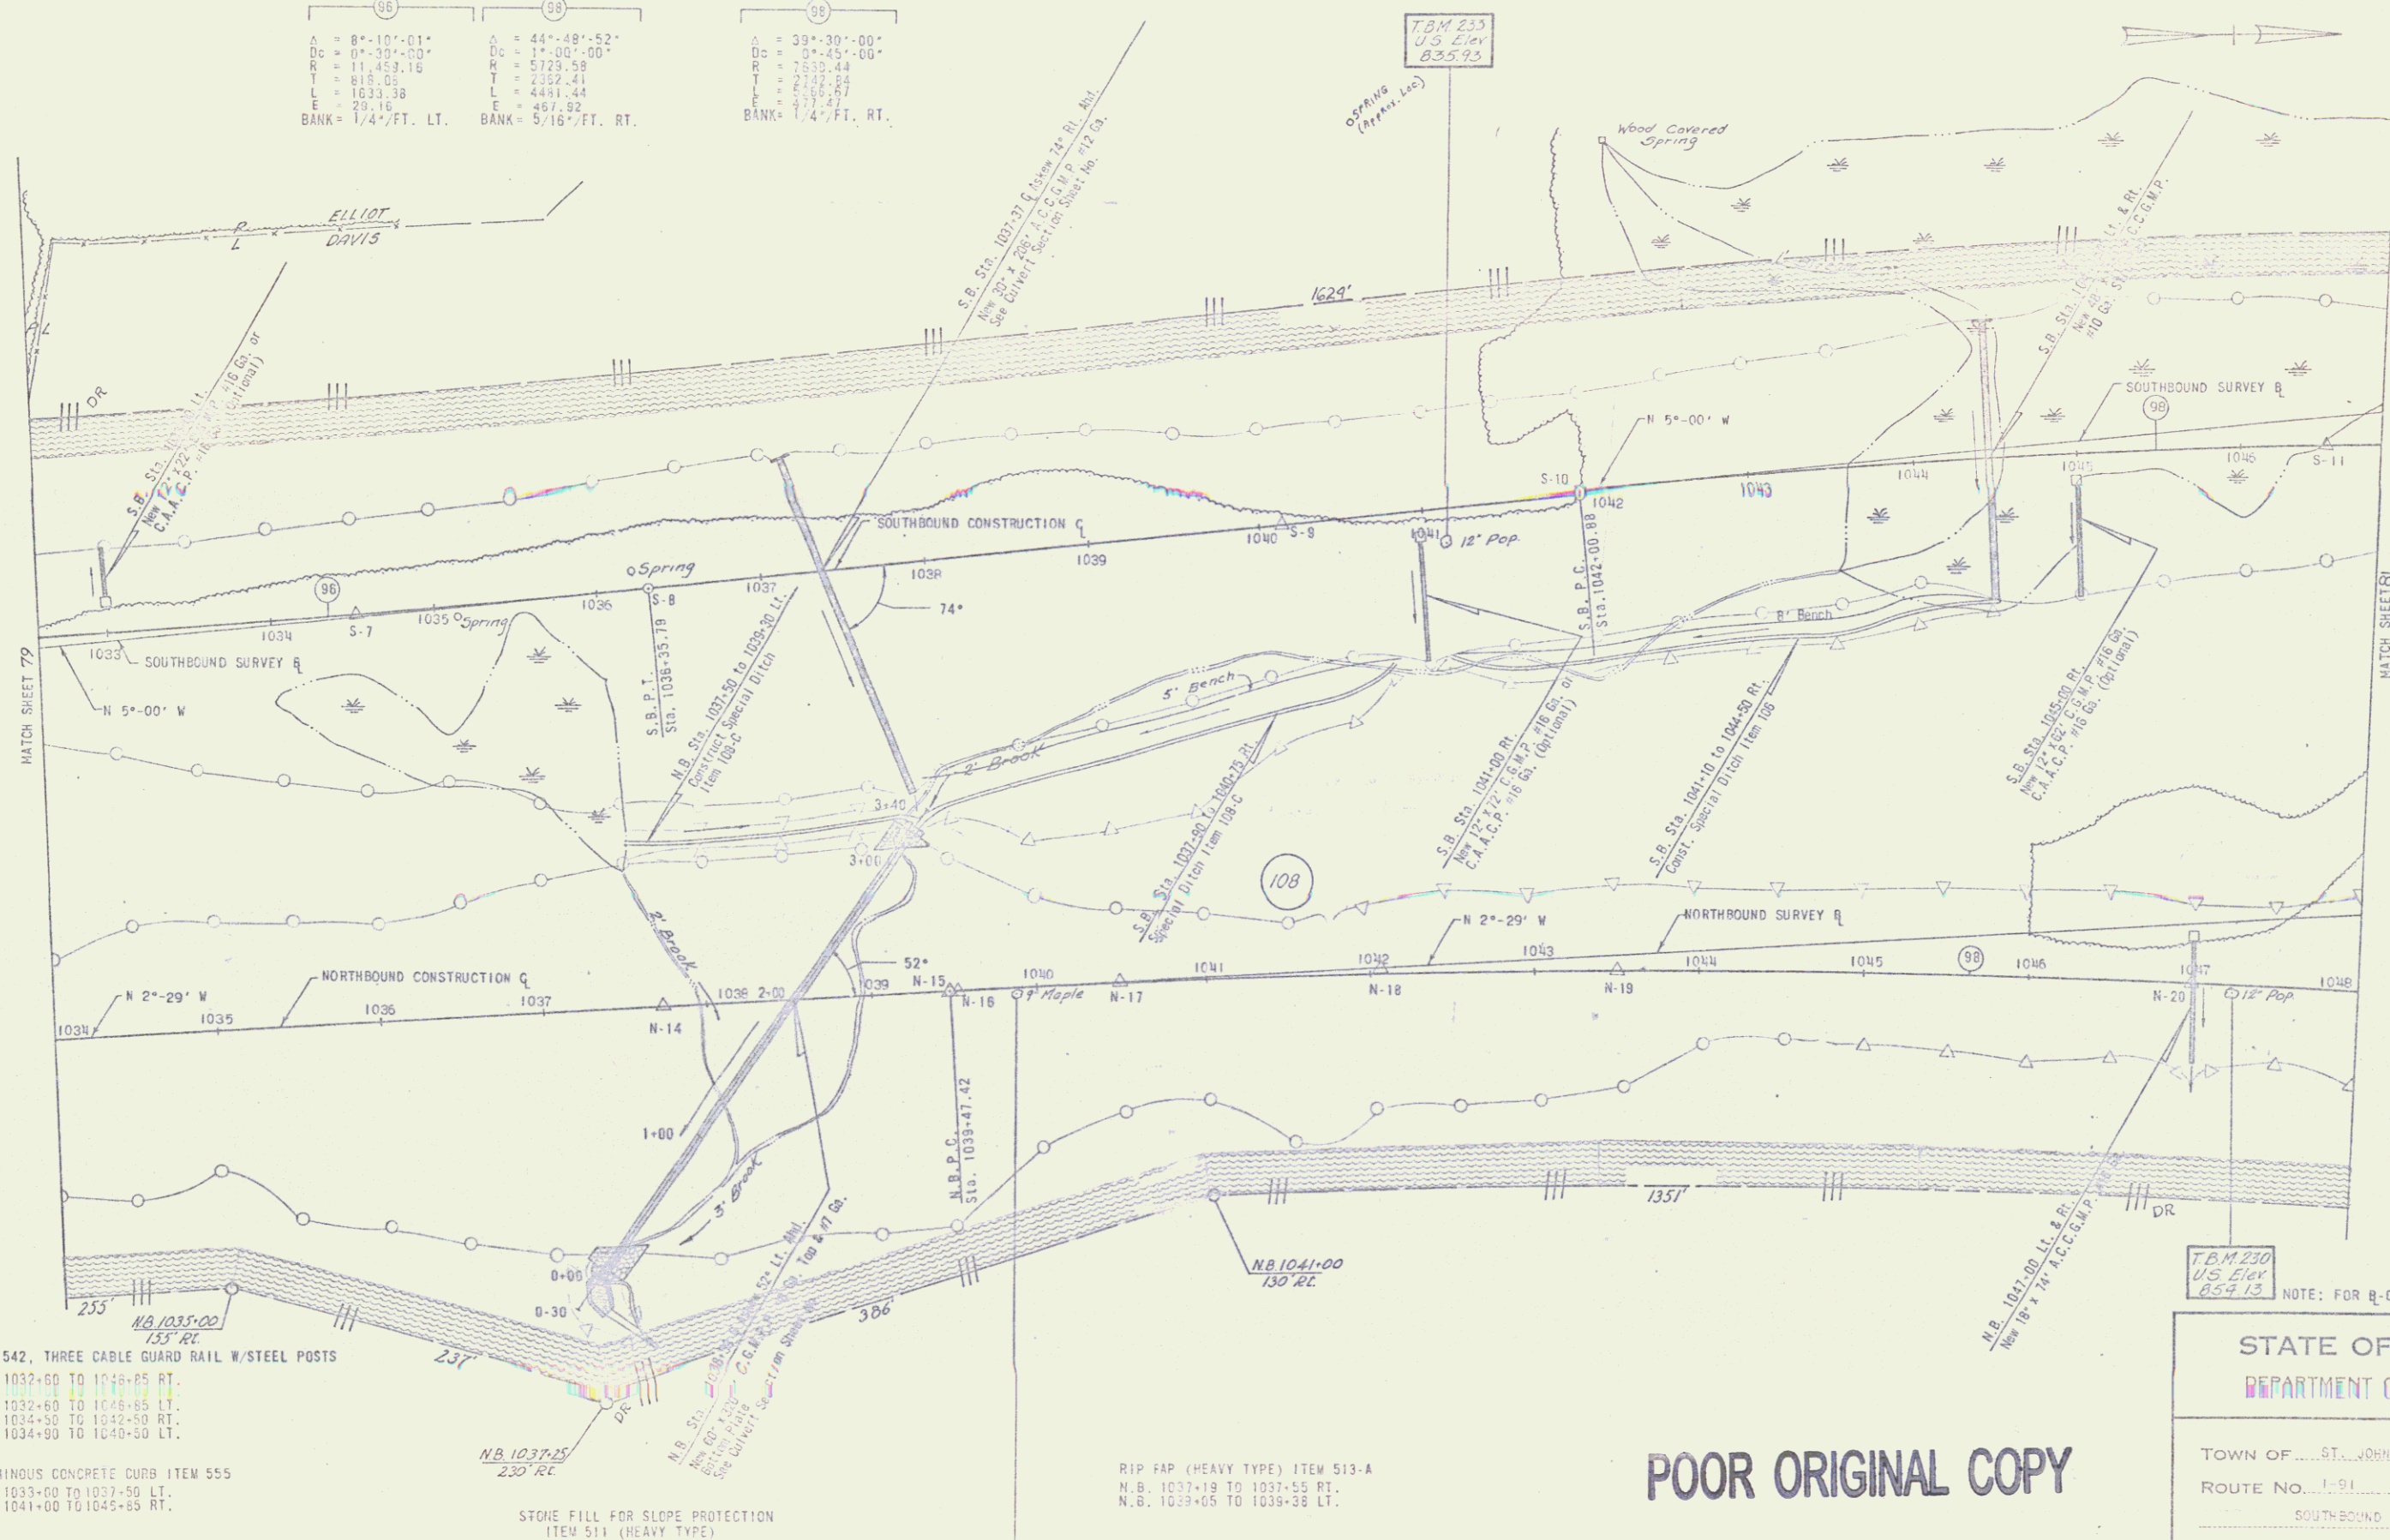

*ITEM 542, THREE CABLE GUARD RAIL W/STEEL POSTS
 S.B. 1032+00 TO 1038+85 RT.
 S.B. 1032+60 TO 1038+85 LT.
 N.B. 1034+90 TO 1042+50 RT.
 N.B. 1034+90 TO 1040+50 LT.

*BITUMINOUS CONCRETE CURB ITEM 555
 S.B. 1033+00 TO 1037+50 LT.
 S.B. 1041+00 TO 1045+85 RT.

STONE FILL FOR SLOPE PROTECTION
 ITEM 511 (HEAVY TYPE)
 N.B. 1037+16 TO 1037+32 RT.

JUTE MATTING ITEM 623
 S.B. 1041+10 TO 1044+50 RT.

RIP RAP (HEAVY TYPE) ITEM 513-A
 N.B. 1037+19 TO 1037+55 RT.
 N.B. 1039+05 TO 1039+38 LT.

STONE FILL FOR SLOPE PROTECTION
 ITEM 512 (LIGHT TYPE)
 S.B. 1037+80 TO 1040+75 RT.

POOR ORIGINAL COPY

PLAN SCALE
 1" = 40'

*DENOTES STAGE 2 ITEMS
 CLARKESON, FLORENCE AND YOKEL
 CONSULTING ENGINEERS
 ALBANY NEW YORK

STATE OF VERMONT
 DEPARTMENT OF HIGHWAYS

TOWN OF... ST. JOHNSBURY...

ROUTE No. 191 STA. ...

SOUTHBOUND 1032+60 TO 1038+85
 NORTHBOUND 1034+00 TO 1040+00

CONTRACT = 1

STAGE CONSTRUCTION I

PROJECT No. 1-91-3093 Sec. II
 SHEET 89 OF 177