


DATE: 11/17/95
 DRAWN BY: [illegible]
 CHECKED BY: [illegible]
 BANK: 4" = 100' RT.

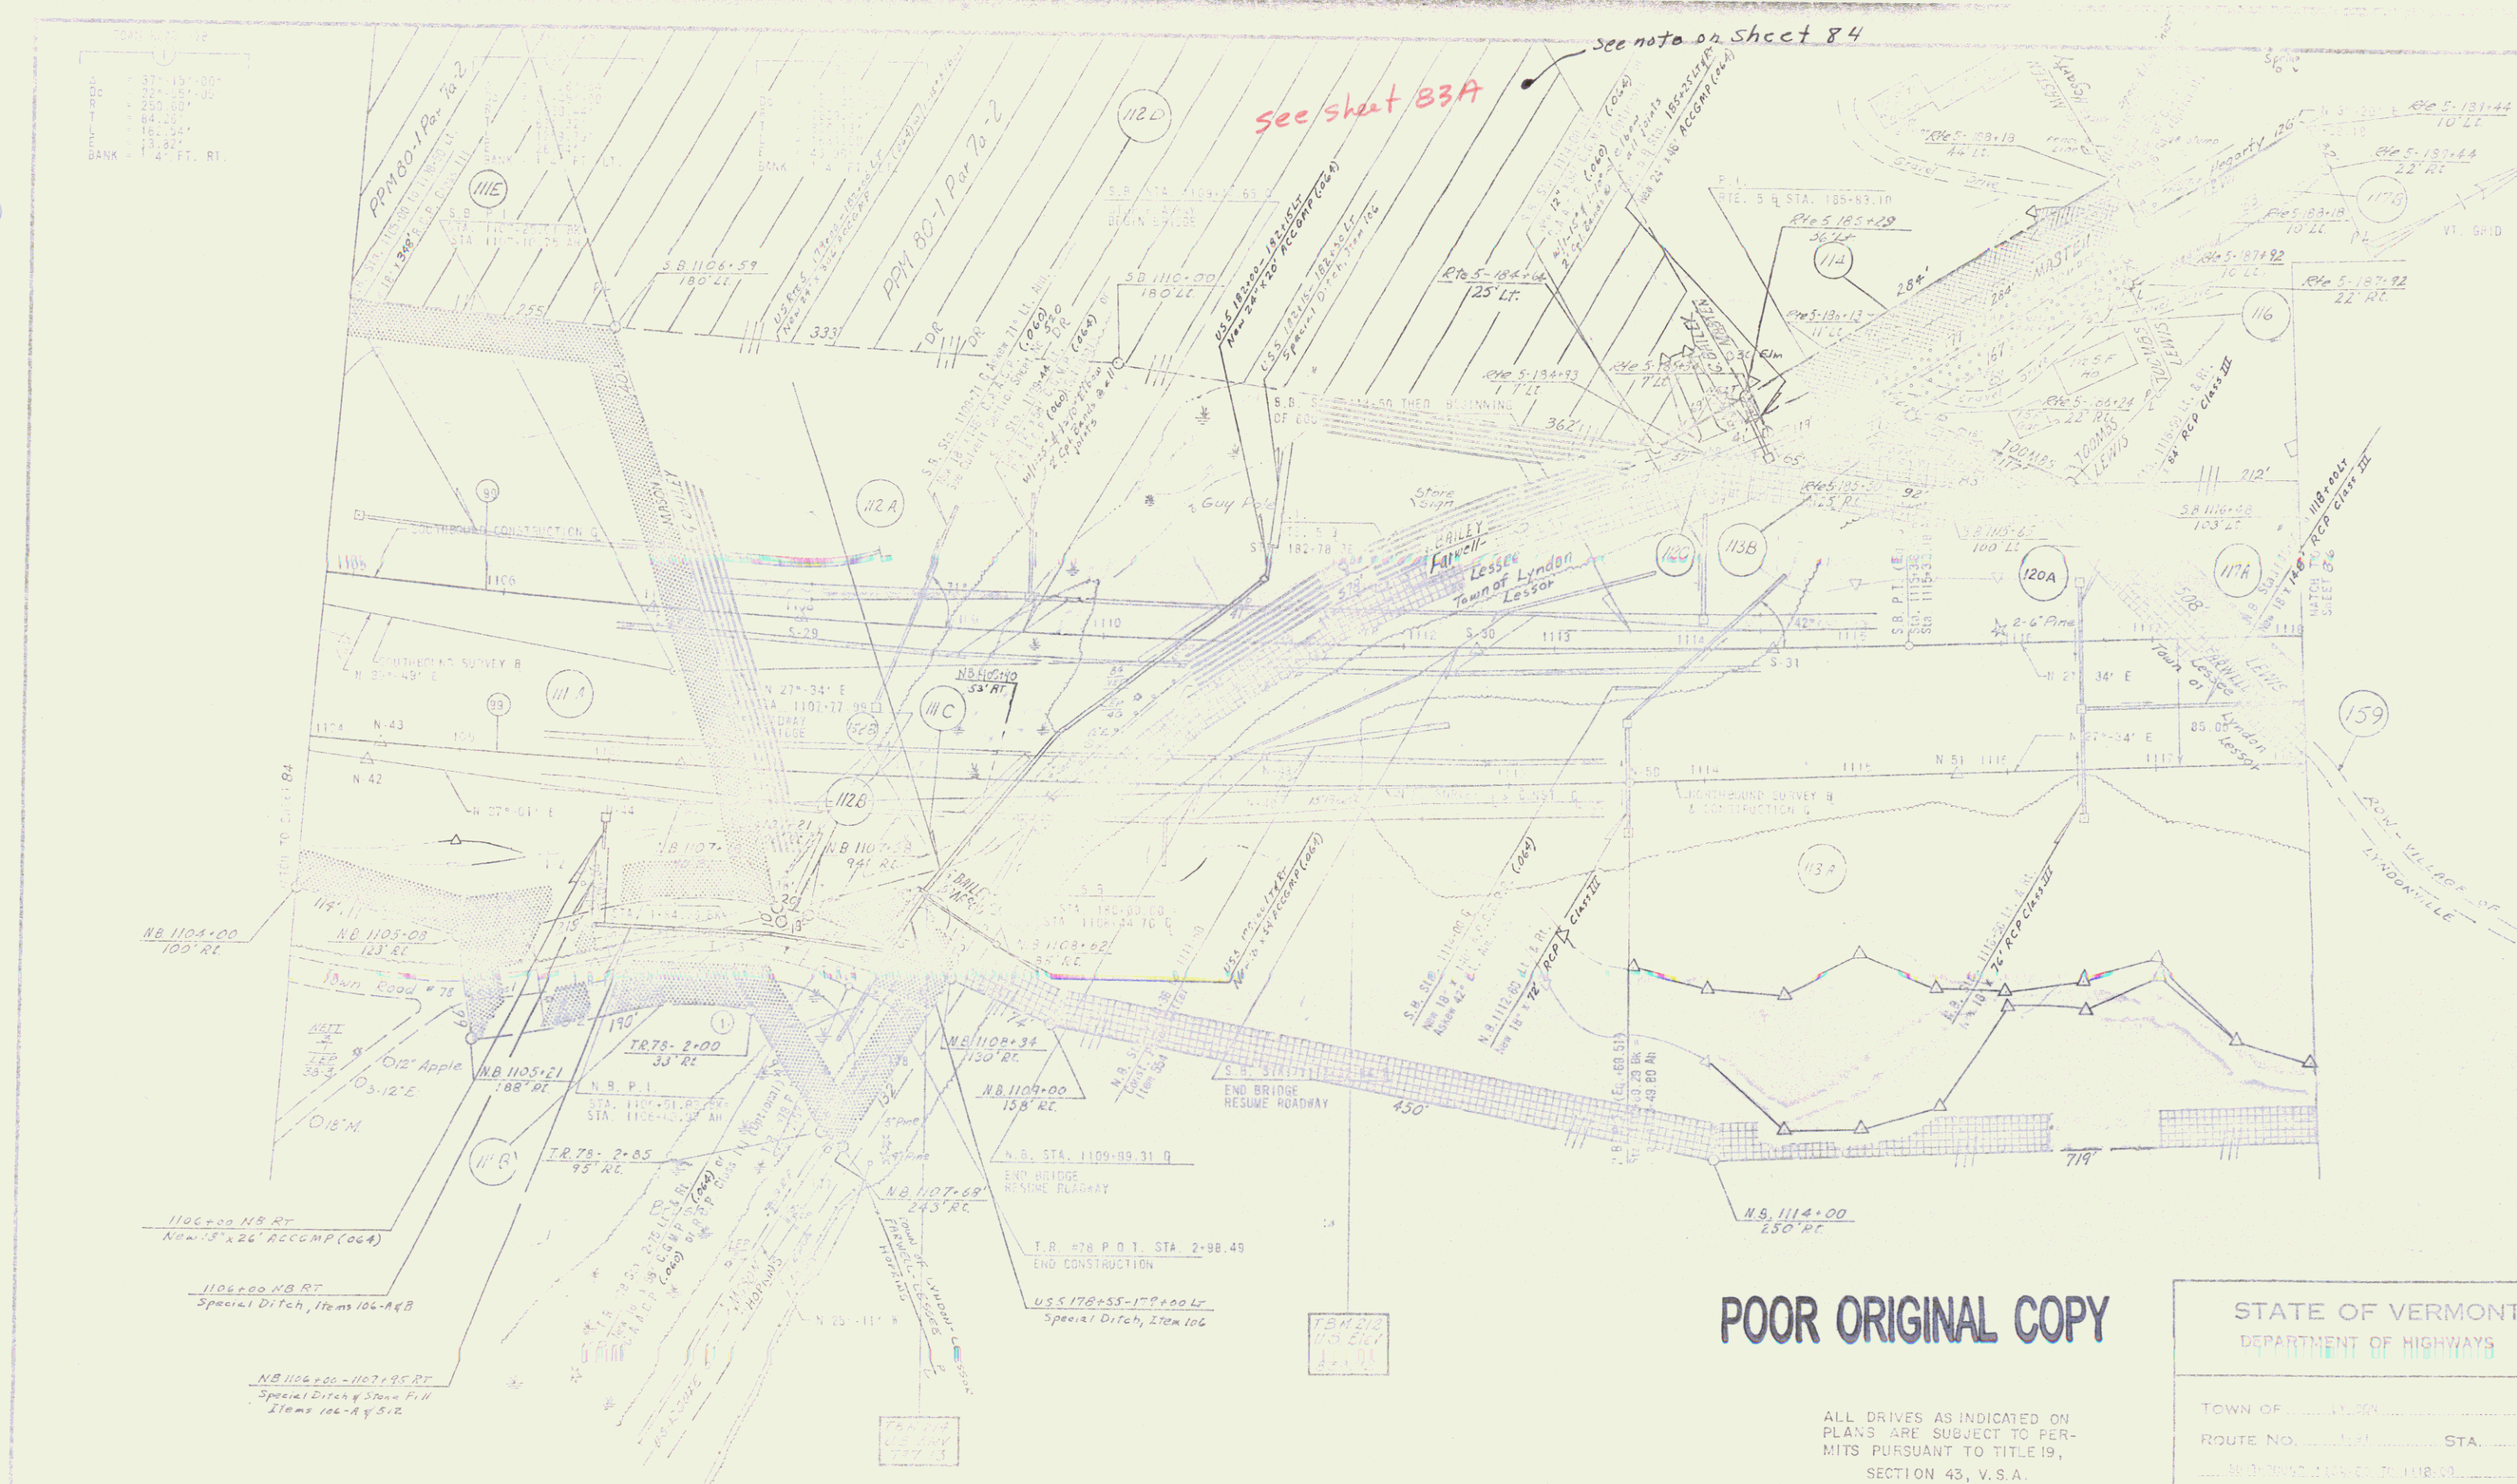

see note on sheet 84
 see sheet 83A

POOR ORIGINAL COPY

ALL DRIVES AS INDICATED ON PLANS ARE SUBJECT TO PERMITS PURSUANT TO TITLE 19, SECTION 43, V.S.A.

STATE OF VERMONT
 DEPARTMENT OF HIGHWAYS

TOWN OF [illegible]
 ROUTE NO. [illegible] STA. [illegible]
 CONTRACT NO. [illegible]
 STAGE CONSTRUCTION I

PROJECT NO. [illegible] Ser 2/1
 SHEET NO. 95