

JUTE MATTING
 S.B. STA. 6887+50 TO STA. 6886+92 RT.
 N.B. STA. 746+00 TO STA. 748+90 LT.
 N.B. STA. 756+00 TO STA. 757+50 RT.

EROSION MATTING
 N.B. STA. 751+00-753+00 LT.

TREATED TIMBER CURB
 N.B. STA. 747+00 TO STA. 749+05 RT.
 N.B. STA. 750+50 TO STA. 754+00 RT.
 N.B. STA. 757+50 TO STA. 758+00 RT.

THREE CABLE GUARD RAIL W/LIGHT STEEL POSTS
 T.R. 66 STA. 11+00 TO STA. 18+95 RT.

STONE FILL, TYPE I
 N.B. STA. 743+75 TO STA. 744+10 RT.
 CONTROL OF ACCESS IS COMPLETE ON THIS SHEET.

WOVEN WIRE FENCE W/ STEEL POSTS
 N.B. STA. 743+00 TO STA. 751+00 RT.
 S.B. STA. 6882+75 LT. TO 6886+45 LT.
 N.B. 757+07 - 758+00 RT.

CHAIN LINK FENCE (6 FT. HIGH)
 #68 STA. 61+37 TO STA. 62+44 RT.
 #65 STA. 61+52 TO STA. 62+44 RT.
 #68 STA. 61+52 TO STA. 62+44 RT.
 #68 STA. 63+90 TO STA. 65+88 RT.
 #66 STA. 10+50 TO STA. 18+95 RT.
 N.B. STA. 750+28 TO STA. 757+00 RT.
 STA. 6886+45 TO STA. 6889+11 LT.
 STA. 6889+12 TO STA. 749+10 N.B.
 STA. 6889+30 TO STA. 750+10 N.B.

PLANK GUARD RAIL
 N.B. STA. 753+70 RT.

*** THREE CABLE GUARD RAIL W/LIGHT STEEL POSTS**

*** APPROACH RAILING**
 N.B. STA. 747+62 TO STA. 749+05 RT.
 N.B. STA. 746+90 TO STA. 749+05 RT.
 N.B. STA. 750+34 TO STA. 751+46 RT.
 N.B. STA. 750+40 TO STA. 750+76 RT.

STANDARD STEEL BEAM GUARD RAIL W/STEEL POSTS, TYPE I, (6'-3" SPACING)
 T.R. 66 STA. 65+50 TO 67+63 LT.
 T.R. 66 STA. 68+00 TO 69+75 RT.

STONE FILL, TYPE II
 T.R. #68 STA. 12+00 TO STA. 12+25 RT.
 T.R. #68 STA. 68+75 TO STA. 69+25 RT.
 T.R. #68 STA. 69+94 TO STA. 67+33 LT.
 S.B. STA. 756+75 TO STA. 758+00 LT.

DEMOLITION & DISPOSAL OF BUILDING
 No. 12

② S.B. STA. 6883+78 FOUNDATION 22' LT.
 ④ N.B. STA. 749+15 FOUNDATION 6'


⑤ S.B. STA. 756+20 1 1/2 STY. FR HOUSE 4'

REMOVAL & DISPOSAL OF EXISTING GUARD RAIL
 T.R. #68 STA. 60+05 TO STA. 61+75 LT.
 T.R. #68 STA. 64+64 TO STA. 67+65 LT.
 S.B. STA. 754+77 TO STA. 755+37 RT.

DEMOLITION & DISPOSAL OF BUILDING
 CONTINUED

③ MT. VERNON ST. STA. 10+50 FOUNDATION 54' RT.
 ④ T.R. #68 STA. 66+05 SPRING HOUSE 65' LT.
 ⑤ T.R. #68 STA. 67+40 SHED 98' LT.

SAND BORROW
 N.B. STA. 754+00 TO 756+50
 N.B. 747+00 TO 748+70

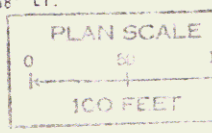

STATE OF VERMONT
 DEPARTMENT OF HIGHWAYS

TOWN OF ST. JOHNSBURY

ROUTE No. 101

STA. 60+00 TO STA. 70+00
 SOUTHBOUND STA. 6882+75 TO STA. 753+00
 TOWN ROAD 101 STA. 9+85.19 TO STA. 13+95
 NORTHBOUND STA. 749+00 TO STA. 758+00
 MT. VERNON ST. STA. 15+00 TO STA. 17+75 RT.

STAGE CONSTRUCTION II

PROJECT No. 101-101 (17)

SHEET 101 OF 101

DRAWN BY: J.C.K.
 CHECKED BY: J.C.K.
 DATE: 10/1/50