

Construct U Turn
NB 774+50 LT.

CONTROL OF ACCESS IS COMPLETE ON THIS SHEET.

Match to Sheet 47 Insert A

TRENCH EXCAVATION ITEM 20420 (REMOVE EXISTING PIPES)

EXIST. STA. 779+00 LT. 100' EXIST. 12" PIPE
EXIST. STA. 783+00 LT. 340' EXIST. 12" PIPE
RAMP E TO S STA. 773+00 RT. 2' EXIST. 12" PIPE
N.B. STA. 773+55 RT. 2' EXIST. 12" CMP

SAND BORROW ITEM 20331
S.B. 773+25-776+00

VT. GRID

RAMP E. TO N.

1
 $\Delta = 179^{\circ}47'00''$ RT
 $D_c = 20^{\circ}50'13''$
 $R = 274.97'$
 $L = 862.01'$
 BANK = .063 FT./FT. RT

RAMP E. TO S.


3
 $\Delta = 37^{\circ}01'24''$ RT
 $D_c = 4^{\circ}05'33''$
 $R = 1400.00'$
 $L = 469.74'$
 $T = 904.85'$
 $E = 76.39'$
 BANK = .051 FT./FT. LT.

STONE FILL, TYPE II

ITEM 61311

N.B. 773+00 TO 776+00 RT.
 N.B. 781+40 TO 787+00 RT.
 S.L. 785+60 TO 788+00 LT.
 N.E. 787+90 TO 788+00 RT.
 RAMP E TO N 7+00 TO 8+15 LT.
 RAMP TO N 7+25 TO 10+63 RT.
 RAMP E TO S 21+00 TO 25+41 LT.

STONE FILL FOR SLOPE STABILIZATION
 ITEM 61311
 S.B. 772+75-776+00 Lt. Type II

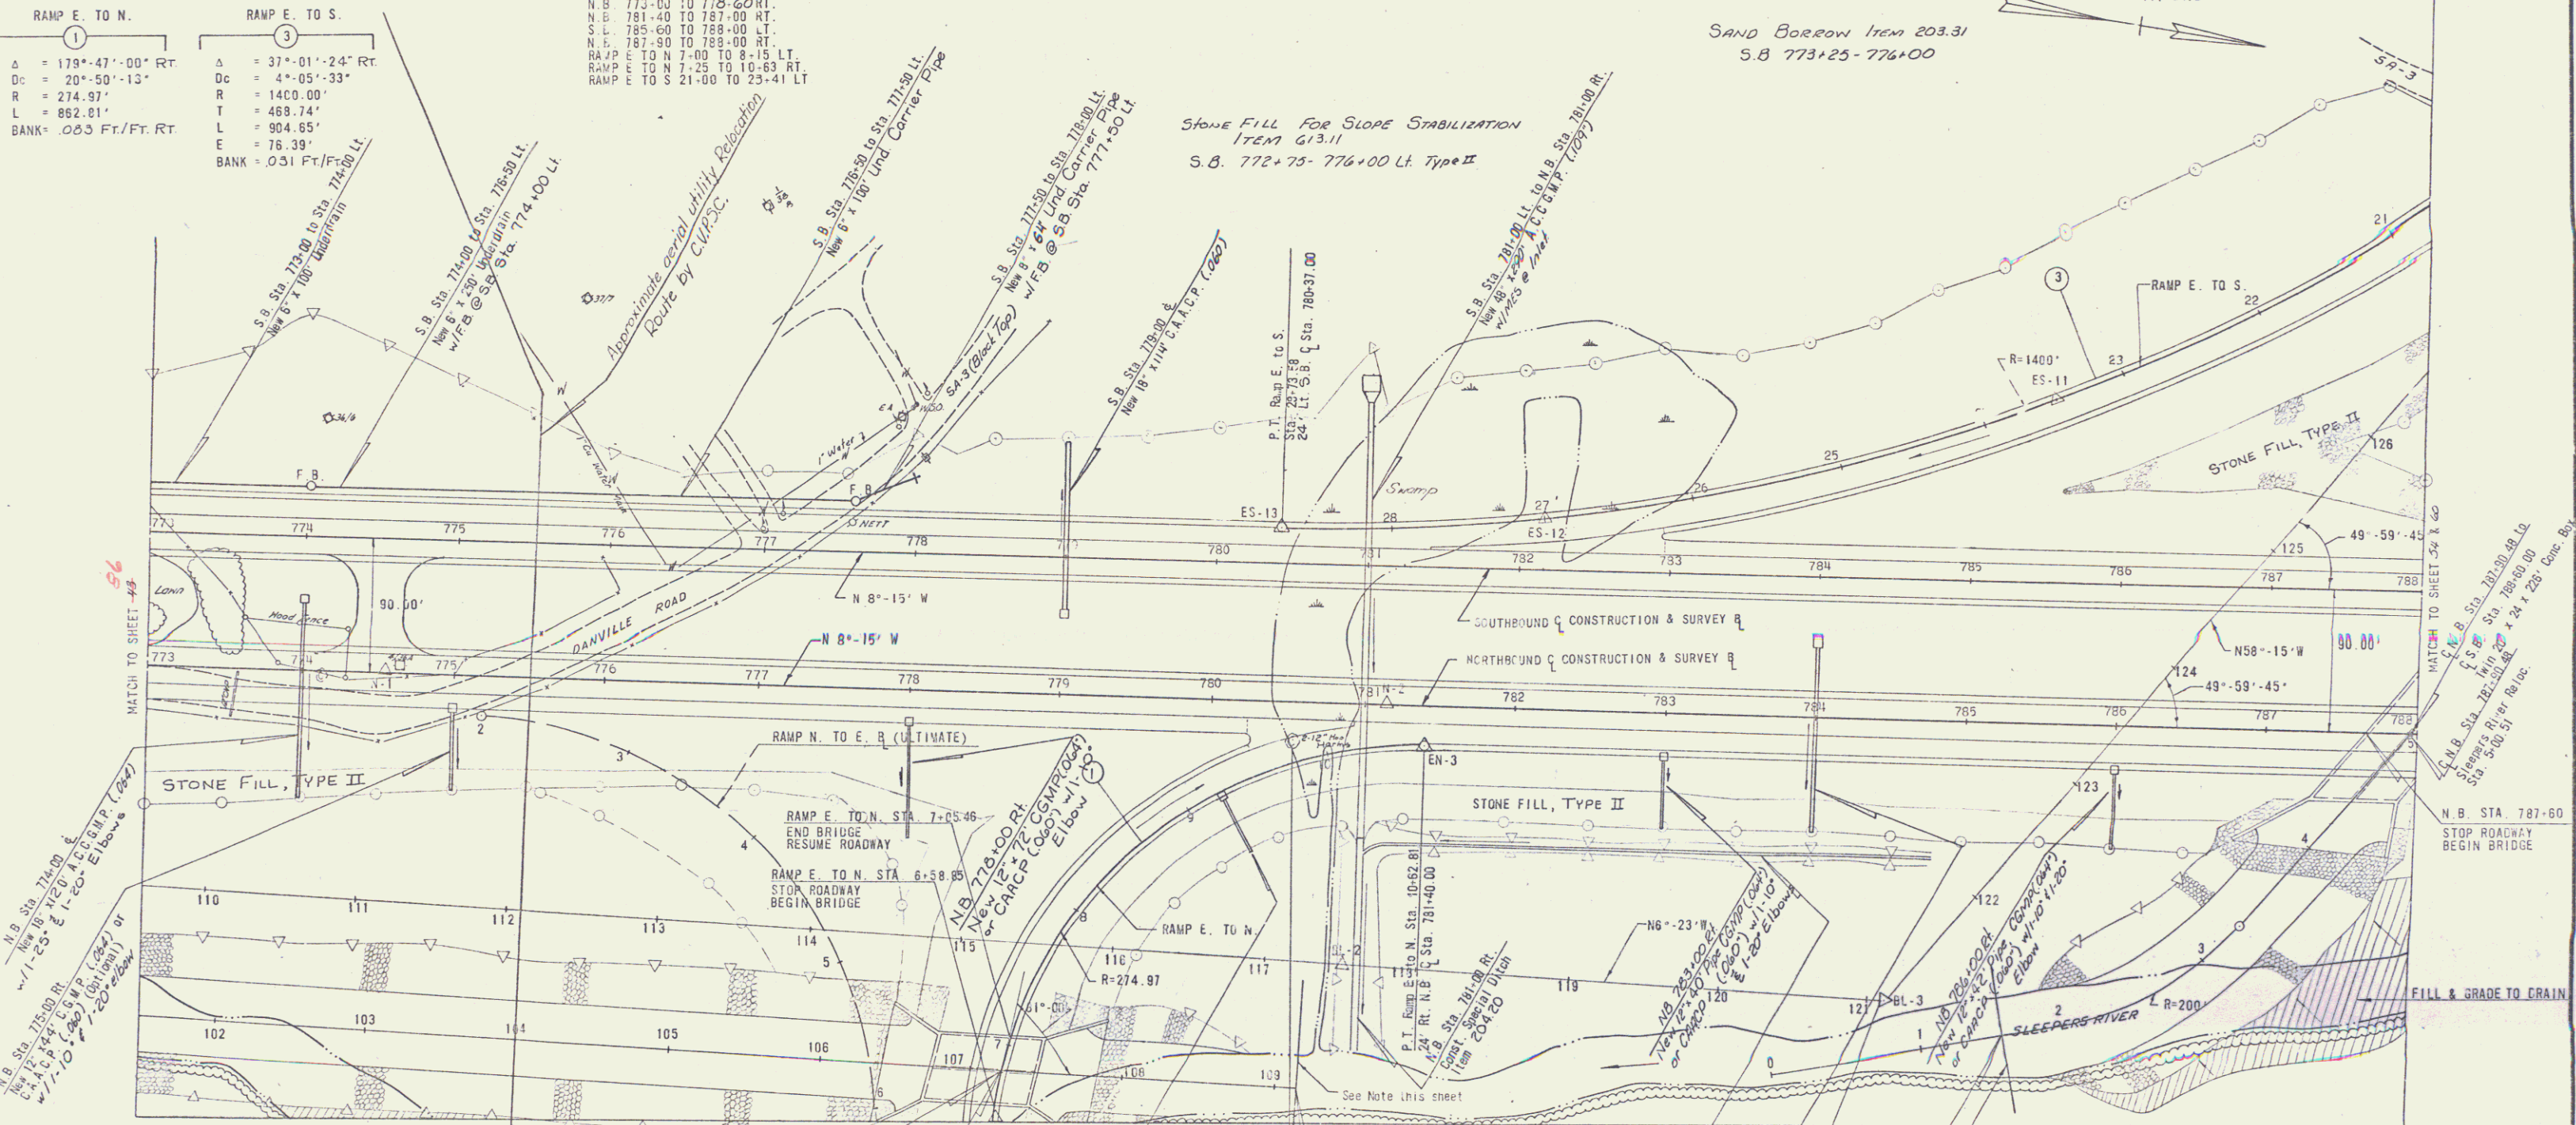

* THREE CABLE GUARD RAIL W/LIGHT STEEL POSTS
 ITEM 62127
 N.B. STA. 773+00 TO 776+54 RT.

RAMP E TO N STA. 6+50 TO N.B. 788+00 RT.

STANDARD STEEL BEAM GUARD RAIL W/STEEL POSTS
 ITEM 62126
 * RAMP E TO N STA. 6+50 TO 108+00 LT.
 * S.B. STA. 737+00 TO 788+00 LT.

WOVEN WIRE FENCE W/STEEL POSTS
 ITEM 62225
 S.B. STA. 773+00 LT. TO RAMP E TO S STA. 20+70 RT. EXCAVATION & REMOVAL OF ROAD SURFACES AND PAVEMENTS
 ITEM 20213
 S.B. 771+57 LT. TO RAMP E TO S 20+20 RT.

* TREATED TIMBER CURB Item 61635
 N.B. 773+00 TO 776+00 RT.
 Ramp E-N 6+50 RT - NB 789+00 RT.

JUTE MATTING ITEM 60410
 N.B. 773+00 TO 774+00 LT.
 N.B. 775+00 TO 783+00 LT.
 N.B. 775+00 TO 788+00 RT.
 N.B. 784+00 TO 788+00 LT.

RAMP E. TO N STA. 6+58-85
 SLEEPERS RIVER RELOCATION
 STA. 107+20 TO 109+15

RAMP E. TO N STA. 6+58-85
 STA. 107+20 TO 109+15

RAMP E. TO N STA. 6+58-85
 STA. 107+20 TO 109+15

RAMP E. TO N STA. 6+58-85
 STA. 107+20 TO 109+15

EXCELSIOR MATTING, ITEM 65415
 S.B. STA. 773+00-761+00 LT.

EXCELSIOR MATTING, ITEM 65415
 S.B. STA. 773+00-761+00 LT.

END CONSTRUCTION SLEEPERS RIVER
 RELOCATION C. STA. 109+15

END CONSTRUCTION SLEEPERS RIVER
 RELOCATION C. STA. 109+15

BEGIN CONSTRUCTION SLEEPERS RIVER
 RELOCATION C. STA. 1+55

BEGIN CONSTRUCTION SLEEPERS RIVER
 RELOCATION C. STA. 1+55

NOTE: FOR 9-6 TILES SEE THE SHEET NO. 3233 + 34

STATE OF VERMONT
 DEPARTMENT OF HIGHWAYS

TOWN OF ... ST. JOHNSBURY

ROUTE No. 1-91 STA. ...

SOUTHBOUND STA. 773+00 TO STA. 788+00

NORTHBOUND STA. 773+00 TO STA. 788+00

RAMP E TO S STA. 20+70 TO STA. 28+75.58

RAMP E TO N STA. 6+50 TO STA. 10+02.81


STAGE CONSTRUCTION II

PROJECT No. 1-91-3 (17)

SHEET 46 OF ...

* DENOTES STAGE 2 ITEMS

CLARKSON, CLOUGH AND YOKEL
 CONSULTING ENGINEERS
 ALBANY NEW YORK

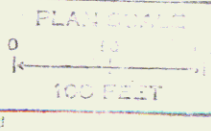

DRAWN BY: [Signature]
 CHECKED BY: [Signature]
 DATE: [Date]