

SOUTHBOUND		NORTHBOUND	
88		89	
At = 56°-30'-00" RT.	At = 56°-30'-00" RT.	At = 56°-30'-00" RT.	At = 56°-30'-00" RT.
Ac = 47°-30'-00"	Ac = 47°-30'-00"	Ac = 47°-30'-00"	Ac = 47°-30'-00"
Dc = 3°-00'-00"	Dc = 3°-00'-00"	Dc = 3°-00'-00"	Dc = 3°-00'-00"
R = 1809.86	R = 1809.86	R = 1809.86	R = 1809.86
Tc = 840.36	Tc = 840.36	Tc = 840.36	Tc = 840.36
Lc = 1583.33	Lc = 1583.33	Lc = 1583.33	Lc = 1583.33
Ec = 176.71	Ec = 176.71	Ec = 176.71	Ec = 176.71
Qs = 4°-30'-00"	Qs = 4°-30'-00"	Qs = 4°-30'-00"	Qs = 4°-30'-00"
Ls = 300.00	Ls = 300.00	Ls = 300.00	Ls = 300.00
P = 1.98	P = 1.98	P = 1.98	P = 1.98
K = 149.97	K = 149.97	K = 149.97	K = 149.97
Lt = 200.06	Lt = 200.06	Lt = 200.06	Lt = 200.06
St = 100.06	St = 100.06	St = 100.06	St = 100.06
Ts = 1177.23	Ts = 1177.23	Ts = 1177.23	Ts = 1177.23
X = 299.81	X = 299.81	X = 299.81	X = 299.81
Y = 7.85	Y = 7.85	Y = 7.85	Y = 7.85
BANK = .070 Ft./Fr. Rt.	BANK = .070 Ft./Fr. Rt.	BANK = .070 Ft./Fr. Rt.	BANK = .070 Ft./Fr. Rt.


CONTROL OF ACCESS IS COMPLETE ON THIS SHEET.

SAND BORROW ITEM 203.31
SB 816+50 - 818+50

DRILLING & BLASTING OF SOLID
ROCK SUBGRADE ITEM 206.10
NB 816+00 - 830+00
SB 818+00 - 830+00

Stone Fill For Slope Stabilization
ITEM 613.10 & 613.11
NB 827+75 - 830+00 RT Type II
SB 821+25 - 826+75 Lt. Type I

VT. GRID

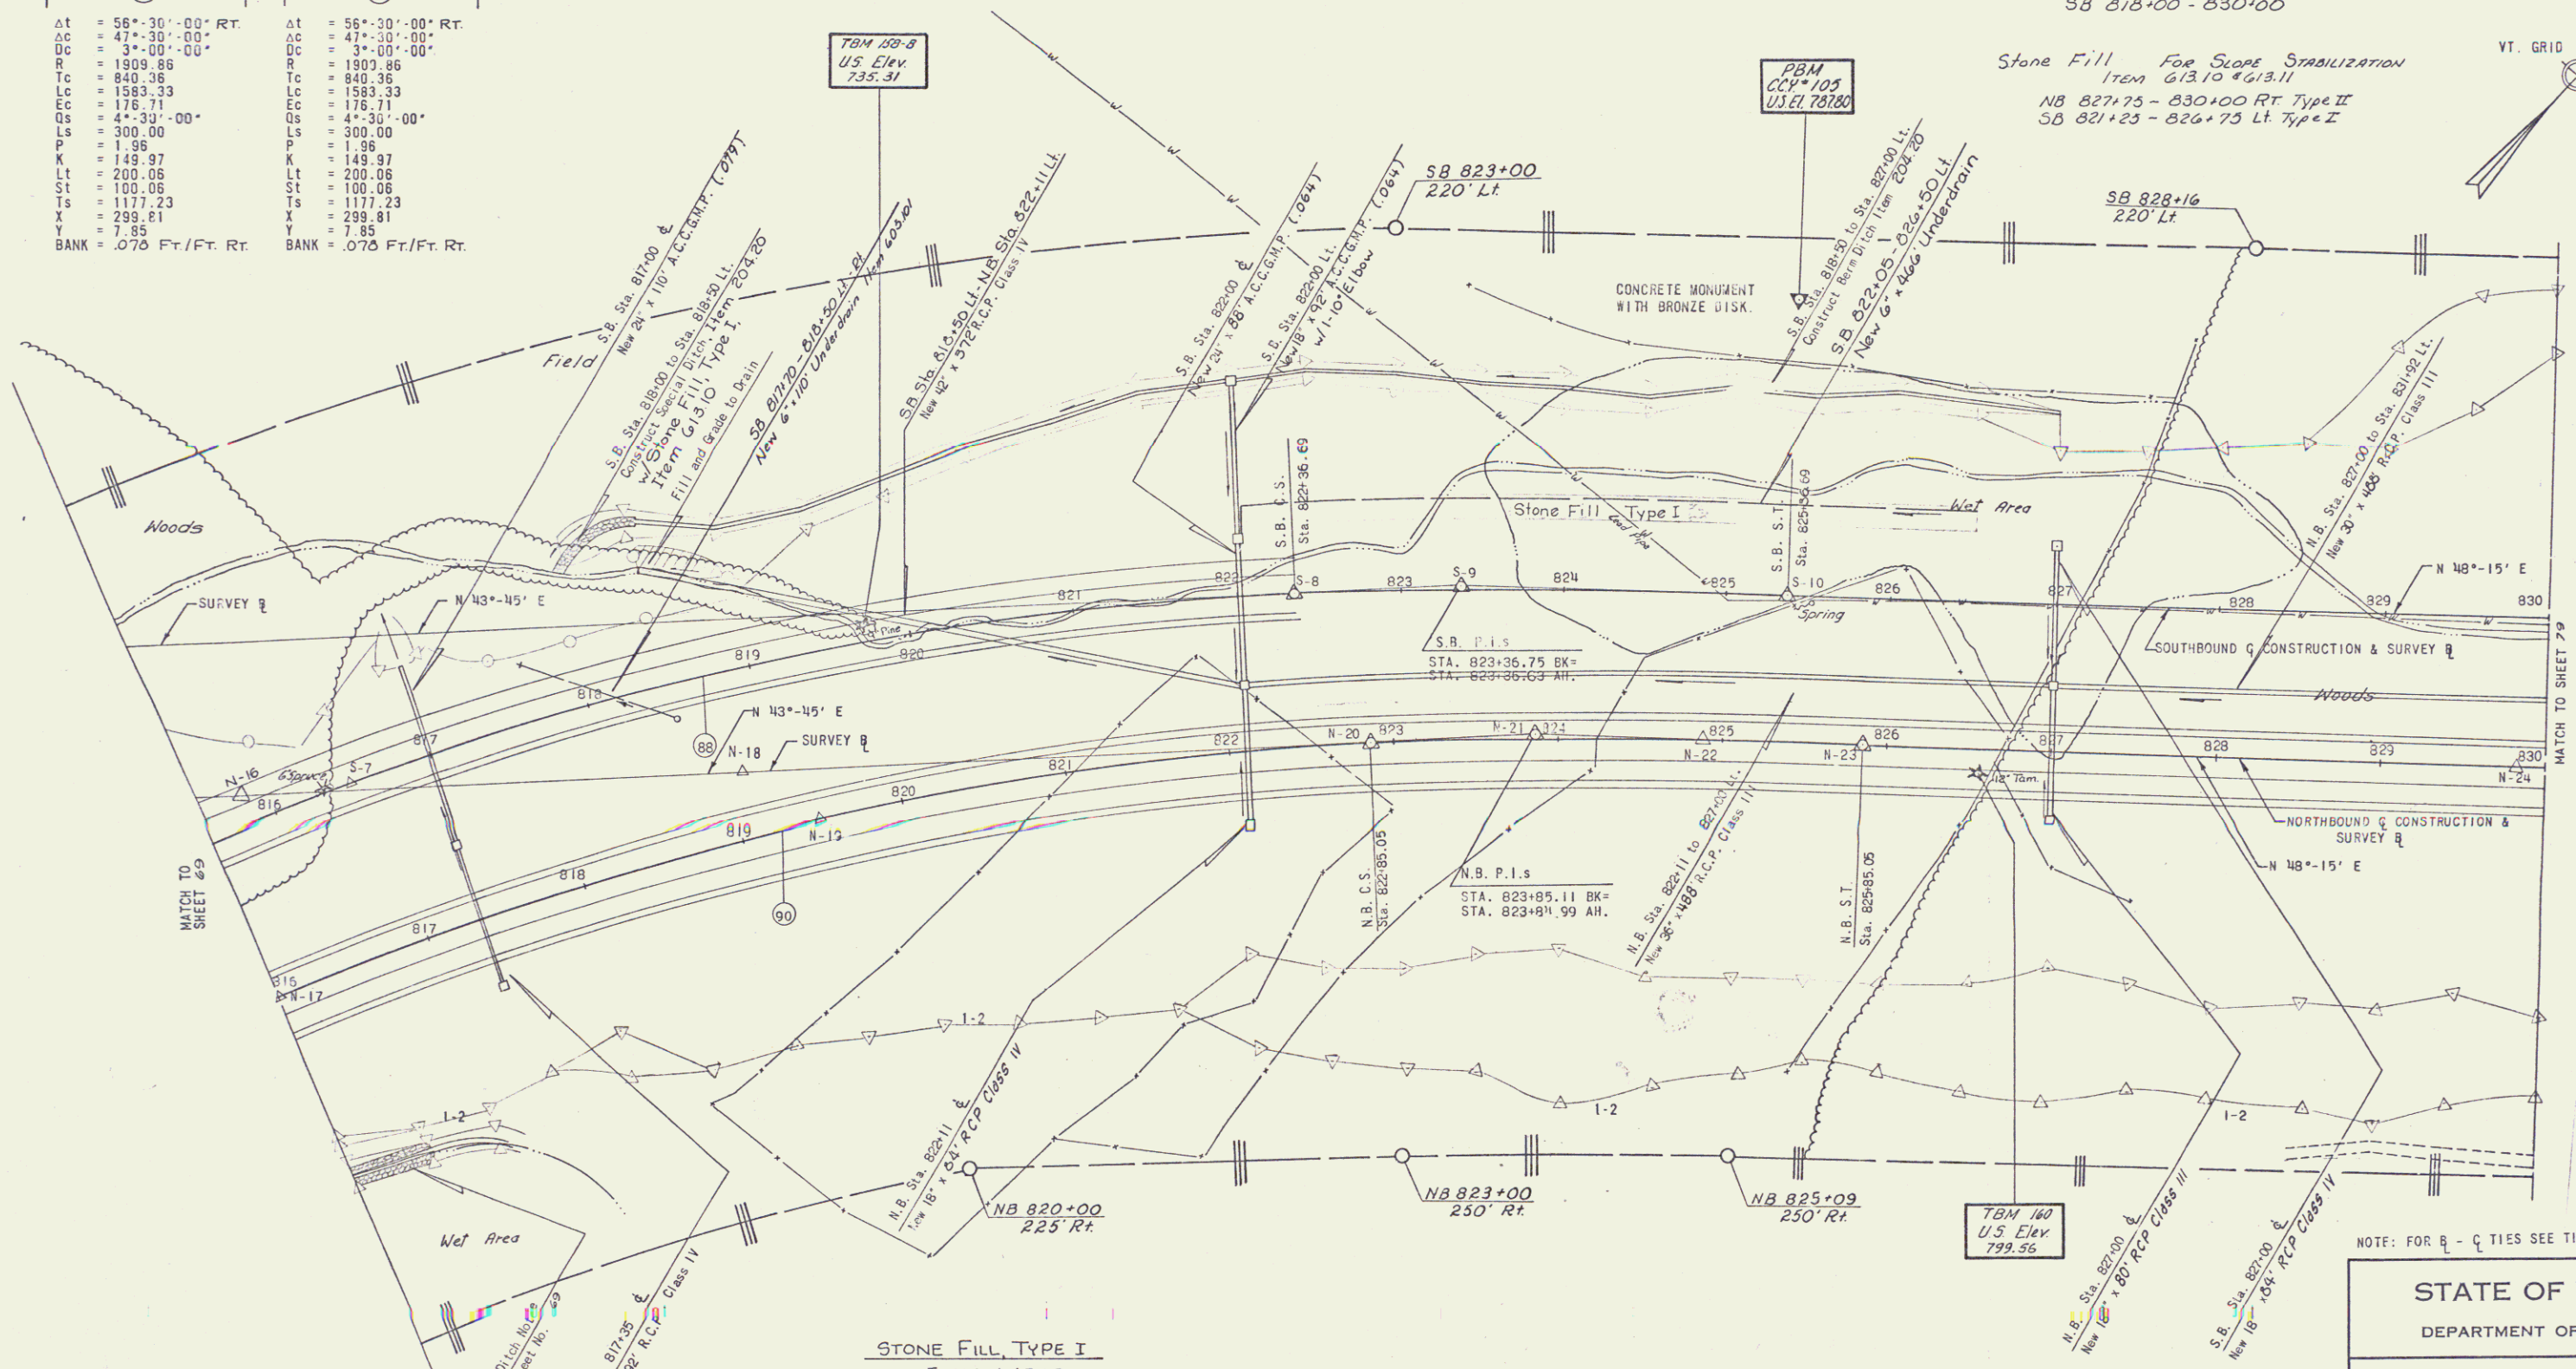


WOVEN WIRE FENCE W/STEEL POSTS
ITEM 620.23
S.B. STA. 815+60 TO 830+00 LT.
N.B. STA. 816+00 TO 830+00 RT.
Construct Fence Prior to any other work in this Area
SB 815+00 - 828+00 Lt.

STONE FILL TYPE I
ITEM 613.10
S.B. 822+00 - 826+50 LT.

JUTE MATTING ITEM 654.10
S.B. 818+50 TO 821+50 LT.
S.B. 822+00 TO 826+50 LT.

EXCESSOR MATTING
ITEM 654.10
SB. 817+00 - 818+25 RT.

* STANDARD STEEL BEAM GUARD RAIL
w/ STEEL POSTS, ITEM 621.20
S.B. STA. 815+60 TO 819+00 LT.

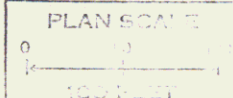

* DENOTES STAGE 2 ITEMS
CLARKSON, CLOUGH & YOKEL
ALBANY CONSULTING ENGINEERS NEW YORK

NOTE: FOR B - C TIES SEE THE SHEET NO. 32

STATE OF VERMONT
DEPARTMENT OF HIGHWAYS

TOWN OF ST. JOHNSBURY

ROUTE No. 1-91 STA. _____

SOUTHBOUND STA. 815+60 TO STA. 830+00

NORTHBOUND STA. 816+00 TO STA. 830+00

STAGE CONSTRUCTION II

PROJECT No. 1-91-3 (17)

SHEET (76) OF _____

SURVEYED BY: C.C.F.
 TRACED BY: J.M.
 CHECKED BY: J.M.
 COMPLETED: 8/1