

DRILLING AND BLASTING OF SOLID ROCK
SUBGRADE, ITEM 206.10
T.R. 27 STA. 94+00 TO 95+00
T.R. 27 STA. 98+00 TO 99+00



Plank Guard Rail Item 621.10
T.R. 27
87+60 - 87+95 Lt - Barricade

DEMOLITION & DISPOSAL
OF BUILDINGS
ITEM 202.10
T.R. 27 98+35 Lt

Excelsior Matting Item 654.15
T.R. 27 87+50-89+00 Lt
T.R. 27 93+50-97+50 Lt

CONSTRUCT HISTORIC SITE MARKER TURNOUT
T.R. 32 STA. 12+00 ~ 13+00 LT.
Removing and Resetting Property Mkt.
from TR 27 - 99+20 Lt. to TR 32 - 12+50 Lt.
See Spec. Provisions

CONSTRUCT DRIVE
PAVED
T.R. 27 97+50 Lt

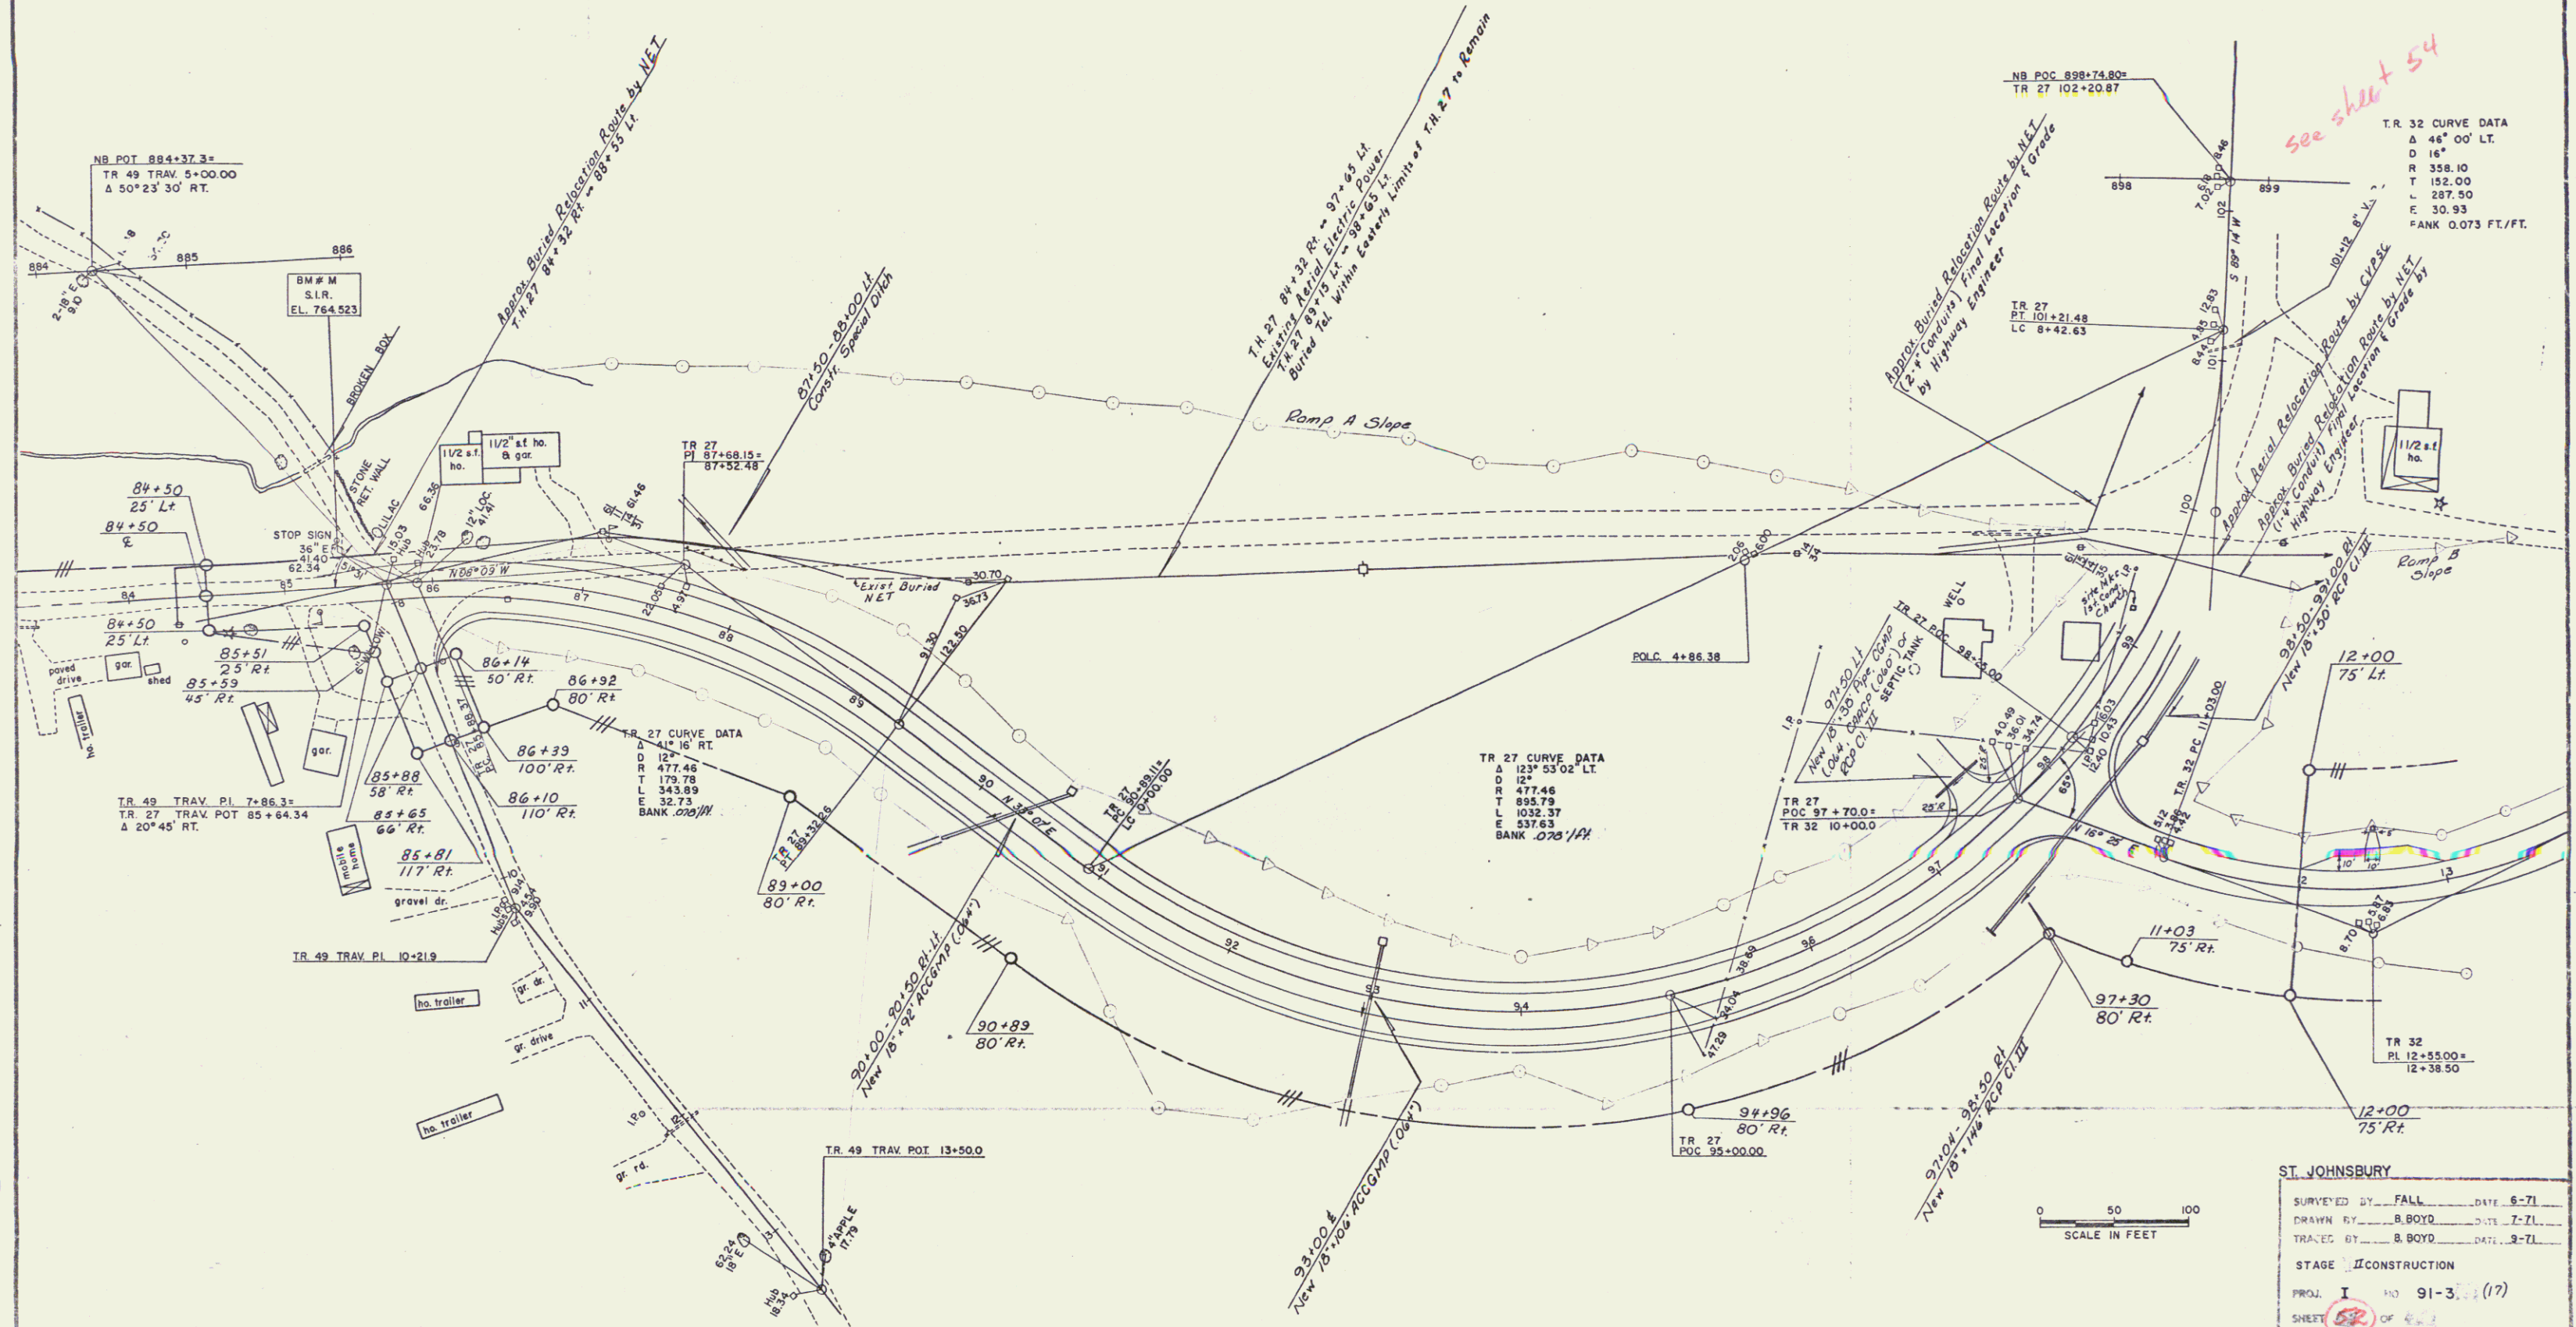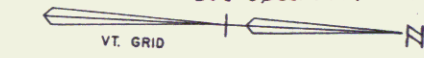

see sheet 54

T.R. 32 CURVE DATA
Δ 46° 00' LT.
D 16'
R 358.10
T 152.00
L 287.50
E 30.93
BANK 0.073 FT./FT.


T.R. 27 CURVE DATA
Δ 123° 53' 02" LT.
D 12'
R 477.46
T 85.79
L 1032.37
E 537.63
BANK 0.251 FT./FT.

T.R. 49 TRAV. PL. 7+86.3'
T.R. 27 TRAV. POT. 85+64.34
Δ 20° 45' RT.

T.R. 27 CURVE DATA
Δ 141° 16' RT.
D 12'
R 477.46
T 179.78
L 343.89
E 32.75
BANK 0.020 FT./FT.

ST. JOHNSBURY

| | | | |
|-------------|--------------|------|-----------|
| SURVEYED BY | FALL | DATE | 8-71 |
| DRAWN BY | B. BOYD | DATE | 7-71 |
| TRACED BY | B. BOYD | DATE | 3-71 |
| STAGE | CONSTRUCTION | | |
| PROJ. | I | NO. | 91-3 (17) |
| SHEET | 52 | OF | 62 |

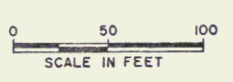

const. Road
105