


DRILLING AND BLASTING OF SOLID ROCK
 SUBGRADE, ITEM 206.10
 FRONTAGE RD. STA. 12+00 TO 13+00
 FRONTAGE RD. STA. 14+50 TO 18+00
 T.R. 27 CONN. STA. 109+00 TO 114+00

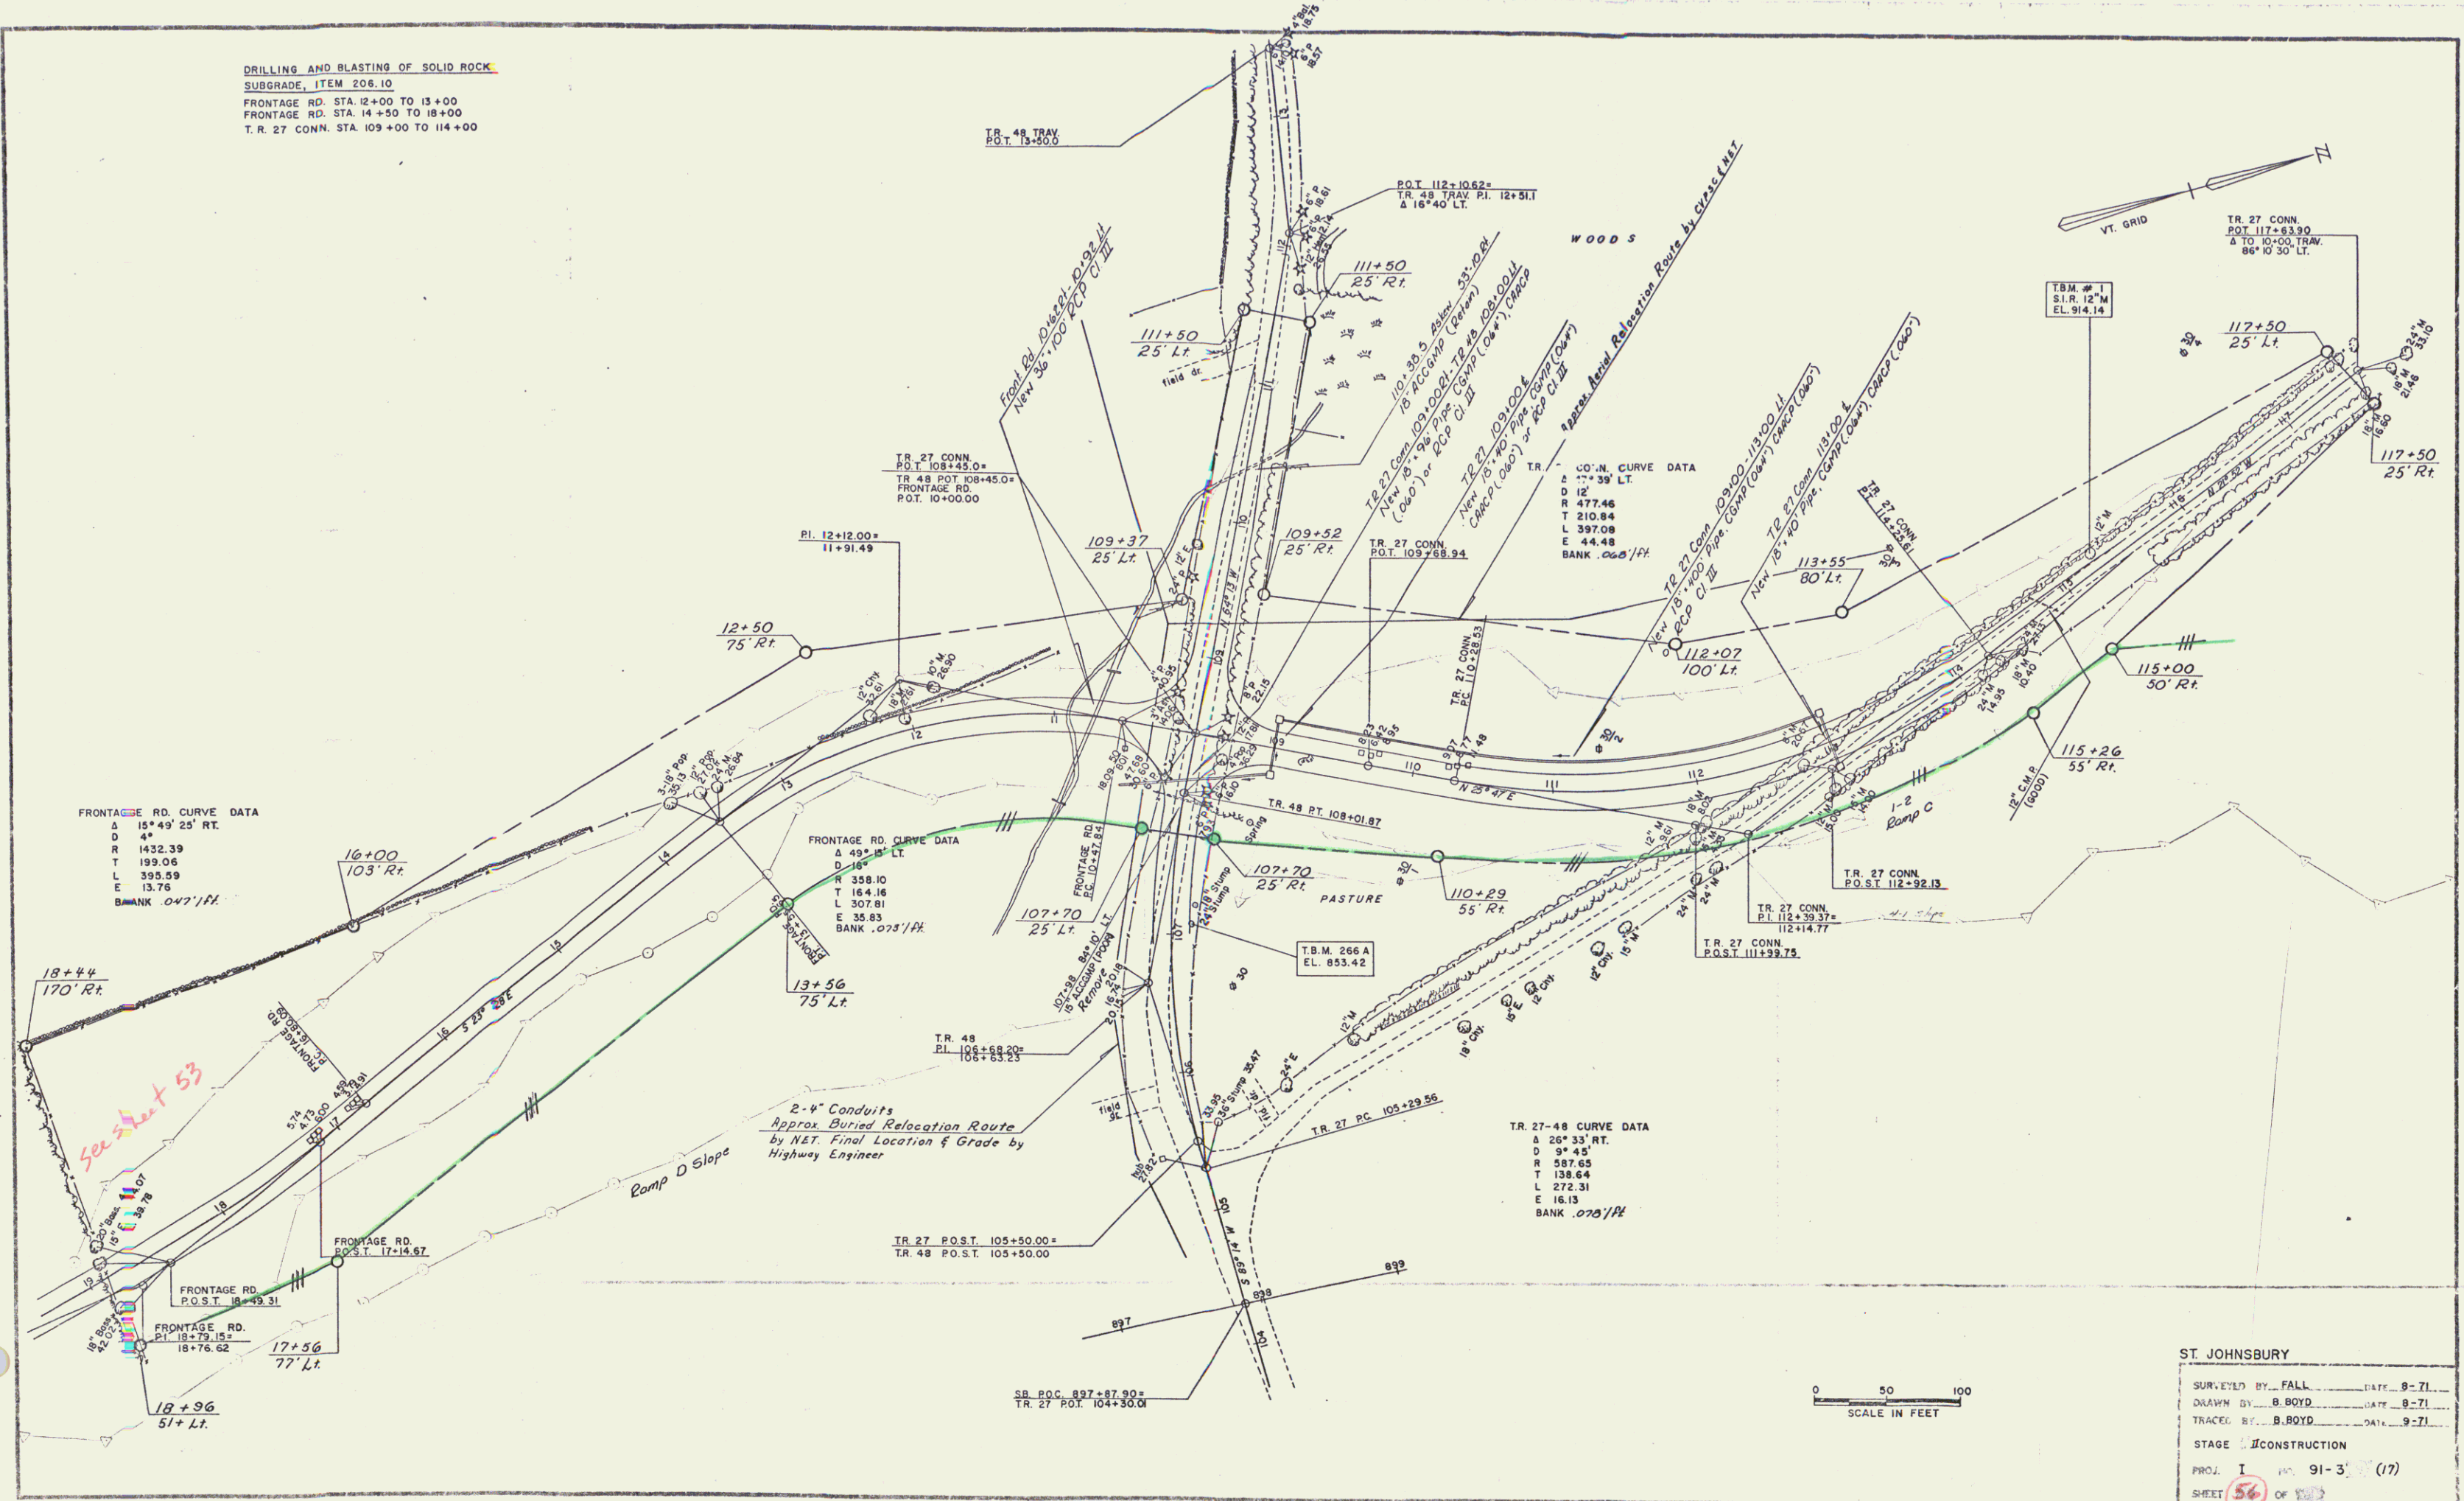

FRONTAGE RD. CURVE DATA
 Δ 15°49' 25" RT.
 D 41'
 R 1432.39
 T 199.06
 L 395.59
 E 13.76
 BANK .047'/ft.

FRONTAGE RD. CURVE DATA
 Δ 49° 15' LT.
 D 16'
 R 358.10
 T 164.18
 L 307.81
 E 35.83
 BANK .075'/ft.

TR. 27-48 CURVE DATA
 Δ 26° 33' RT.
 D 9° 45'
 R 587.65
 T 138.64
 L 272.31
 E 16.13
 BANK .070'/ft.

0 50 100
 SCALE IN FEET

ST. JOHNSBURY
 SURVEYED BY... FALL... DATE... 8-71
 DRAWN BY... B. BOYD... DATE... 8-71
 TRACED BY... B. BOYD... DATE... 9-71
 STAGE CONSTRUCTION
 PROJ. I NO. 91-3 (17)
 SHEET 56 OF 103
 0-7