

SURVEYED BY: C.C.  
 CHECKED BY: J.V.  
 COMPLETED: 10/1/50

**TBM 205**  
 U.S. Elev.  
 811.30

DRILLING AND BLASTING OF SOLID ROCK  
 SUBGRADE, ITEM 206.10  
 N.B. STA. 949+00 TO 958+50  
 S.B. STA. 947+50 TO 957+50

**TBM 207**  
 U.S. Elev.  
 794.21

Excelsior Matting Item 634.15  
 NB 954+75-957+00 RT.  
 SB 944+65-946+00 LT.

**TBM 209**  
 U.S. Elev.  
 752.30


JUTE MATTING ITEM 634.10  
 N.B. STA. 946+00 TO STA. 947+88 LT.  
 S.B. STA. 958+00 TO STA. 960+00 LT.  
 N.B. STA. 959+00 TO STA. 961+35 LT.

SOUTH		NORTH	
BOUND	BOUND	BOUND	BOUND
Δ 7°-35'-02"	Δ 21°-30'-00"	Δ 19°-00'-00"	Δ 27°-00'-00"
Dc 0°-30'-00"	Dc 1°-30'-00"	Dc 0°-45'-00"	Dc 1°-45'-00"
R 11,459.16	R 3819.72	R 7639.44	R 3274.05
T 799.51	T 725.20	T 1278.40	T 786.03
L 1516.80	L 1433.33	L 2533.33	L 1542.86
E 29.14	E 68.83	E 106.23	E 93.03
BANK .021/RT.	LT. BANK .055/RT.	BANK .029/RT.	LT. BANK .057/RT.

\*THREE CABLE GUARD RAIL W/LIGHT STEEL POSTS.  
 ITEM 621.21  
 N.B. STA. 946+00 TO STA. 951+65 RT.  
 N.B. STA. 956+44 TO STA. 961+00 RT.  
 S.B. STA. 956+76 TO STA. 959+65 RT.

**TBM 236**  
 U.S. Elev.  
 791.45

WOVEN WIRE FENCE WITH STEEL POSTS  
 ITEM 622.23  
 N.B. STA. 945+00 TO STA. 961+00 RT.  
 S.B. STA. 944+65 TO STA. 959+65 LT.

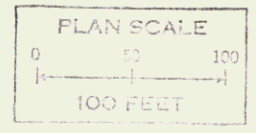

\* DENOTES STAGE 2 ITEMS  
 CLARKESON, CLOUGH AND YCKEL  
 CONSULTING ENGINEERS  
 ALBANY NEW YORK

STATE OF VERMONT  
 DEPARTMENT OF HIGHWAYS

TOWN OF ST. JOHNSBURY  
 ROUTE No. 1-91 STA.  
 SOUTHBOUND 944+65 TO 959+65  
 NORTHBOUND 946+00 TO 961+00

STAGE CONSTRUCTION II  
 PROJECT NO. 1-91-3 (17)  
 SHEET 70 OF