
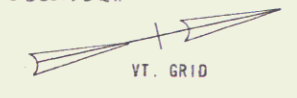


CONTROL OF ACCESS IS COMPLETE ON THIS SHEET.

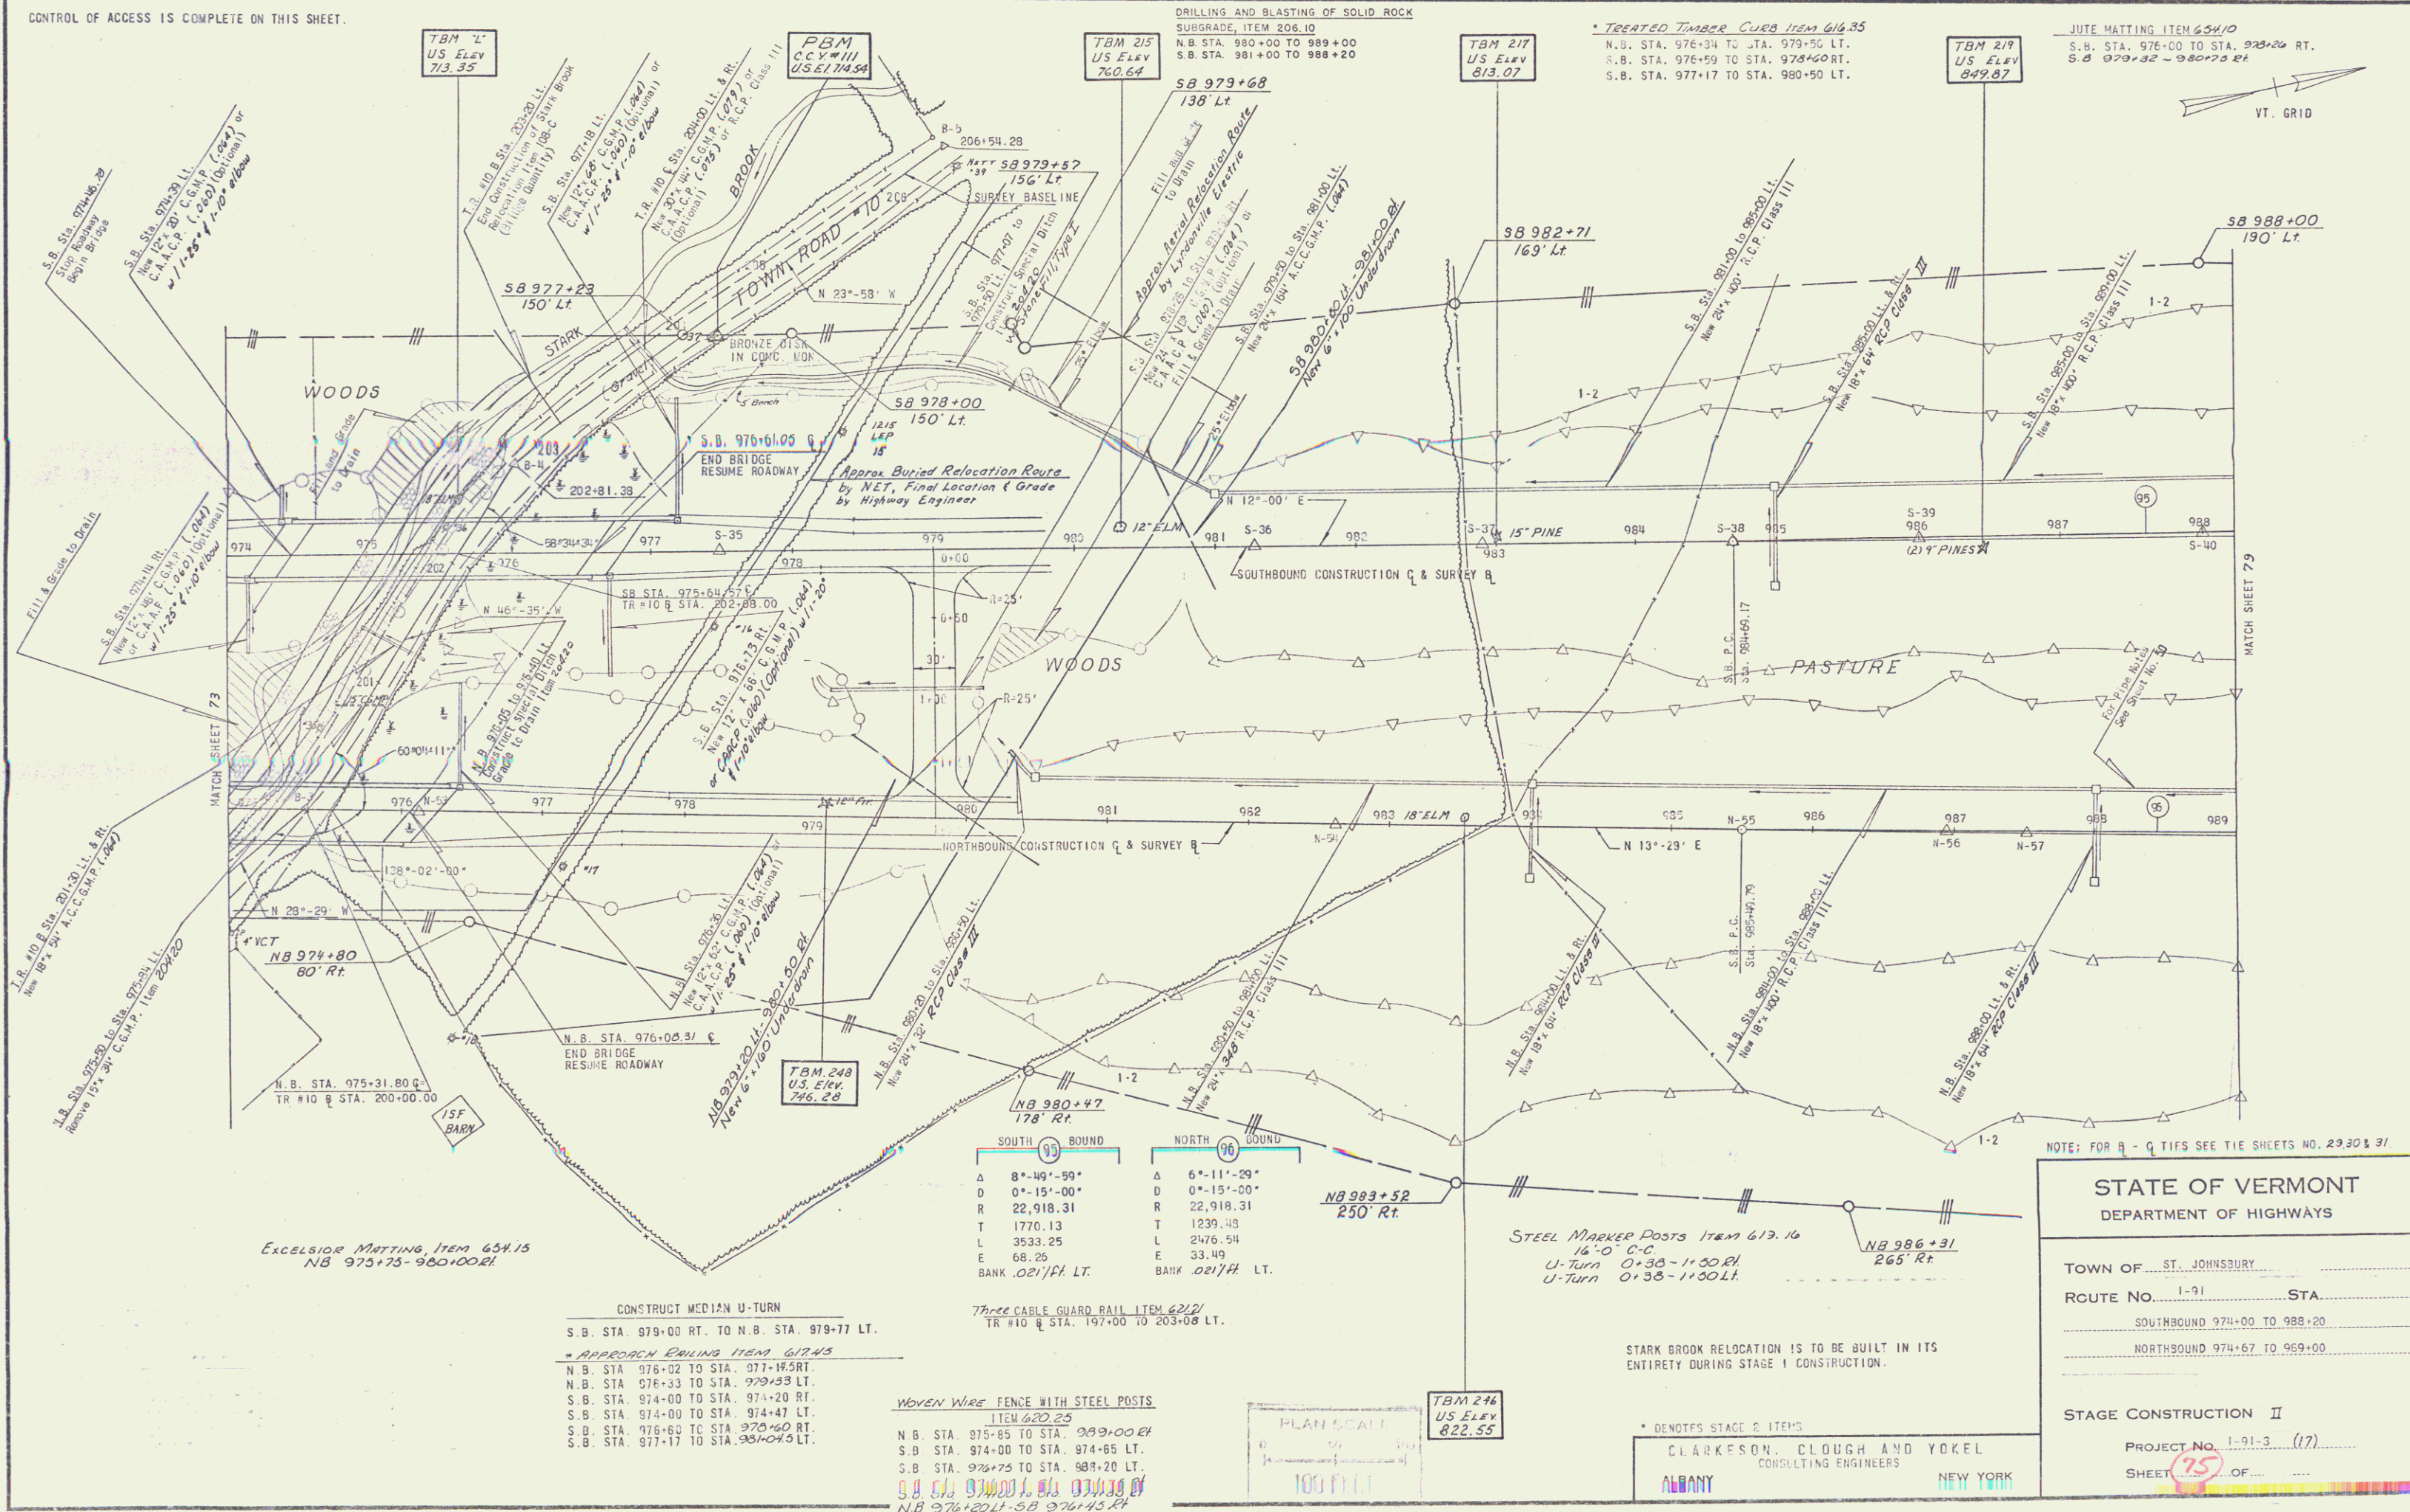

Excelsior Matting, Item 651.15  
NB 975+75-980+00 RT.


CONSTRUCT MEDIAN U-TURN  
S.B. STA. 979+00 LT. TO N.B. STA. 979+77 LT.

APPROACH EMBANKING ITEM 612.45  
N.B. STA. 976+02 TO STA. 977+16.5 RT.  
N.B. STA. 976+33 TO STA. 979+33 LT.  
S.B. STA. 974+00 TO STA. 974+20 RT.  
S.B. STA. 974+00 TO STA. 974+47 LT.  
S.B. STA. 976+60 TO STA. 976+60 RT.  
S.B. STA. 977+17 TO STA. 980+40 LT.

Woven Wire Fence with Steel Posts  
Item 620.25  
N.B. STA. 975+85 TO STA. 989+00 RT.  
S.B. STA. 974+00 TO STA. 974+65 LT.  
S.B. STA. 976+75 TO STA. 989+20 LT.  
NB 976+20 LT - SB 976+45 RT

SOUTH 95 BOUND		NORTH 96 BOUND	
Δ	8'-49"-59"	Δ	6'-11"-29"
D	0'-15"-00"	D	0'-15"-00"
R	22,918.31	R	22,918.31
T	1770.13	T	1239.43
L	3533.25	L	2476.54
E	68.25	E	33.49
BANK .021/PL LT.		BANK .021/PL LT.	

Three Cable Guard Rail Item 621.21  
TR #10 & STA. 197+00 TO 203+08 LT.

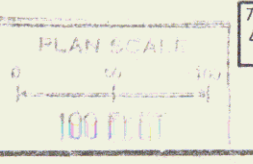

TBM 214  
US Elev  
822.55

STEEL MARKER POSTS ITEM 613.16  
16" O' C.C.  
U-Turn 0+38-11.50 RT.  
U-Turn 0+38-11.50 LT.

STARK BROOK RELOCATION IS TO BE BUILT IN ITS ENTIRETY DURING STAGE I CONSTRUCTION.

\* DENOTES STAGE 2 ITEMS  
CLARKESON, CLOUGH AND YOKEL  
CONSULTING ENGINEERS  
ALBANY NEW YORK

NOTE: FOR R - Q TIES SEE TIE SHEETS NO. 29,30 & 31

**STATE OF VERMONT**  
DEPARTMENT OF HIGHWAYS

TOWN OF ST. JOHNSBURY

ROUTE No. 1-91 STA. SOUTHBOUND 974+00 TO 989+20 NORTHBOUND 974+67 TO 969+00

**STAGE CONSTRUCTION II**

PROJECT No. 1-91-3 (17)  
SHEET 15 OF 17