
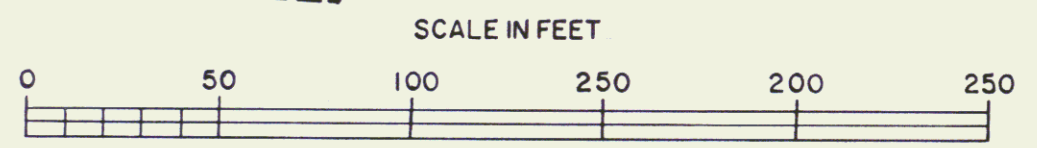


QCD to Rena B. Gilman 4/24/75  
 Pg 60 Pg 473-474  
 Formerly part of Parcel no. 11A  
 acquired from Edwin R. & Rena  
 B. Gilman, By W.D. 2-23-71 Bk.55 Pg.171

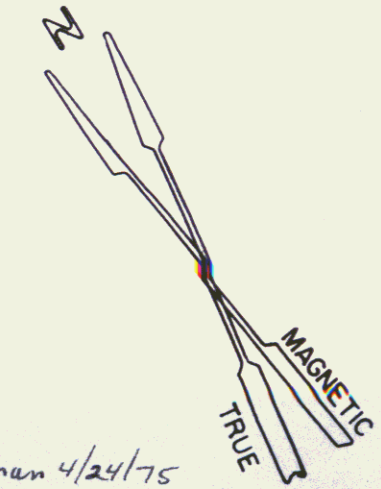

<b>STATE OF VERMONT DEPT. OF HIGHWAYS</b>		
TOWN OF LYNDON		
(36A)		
PROJECT LYNDON BARTON I91-3 (14) SECT. I		
APPROX. SCALE 1"=50'	DATE 1-31-75	DRAWN BY ROD S.

12